

Addendum No. 2
December 10, 2021

Project: Harrisburg High School - 9th Grade Academy
Sioux Falls, South Dakota
Architecture Incorporated Project #2904

Architect: Architecture Incorporated

Letting: Thursday, December 16th, 2021
2:00 p.m.

Location: Community Center Conference Room at the Harrisburg School District Administration Offices, 200 Willow Street, Harrisburg, South Dakota 57032. (Enter from southeast community center entrance).

Scope of this Addendum:

To all bidders and all others to whom drawings and specifications have been issued by Architecture Incorporated, this Addendum forms a part of the Contract Documents. Acknowledge receipt of this addendum by listing its number and date in the bidder's Form of Proposal. Failure to do so may subject bidder to disqualification. This addendum modifies the drawings and specifications as follows:

GENERAL ITEMS:

1) GENERAL CLARIFICATIONS

- a) Reflected Ceiling Plans: Generally speaking, all corridor wall should extend & seal to the structure/deck above. This is shown incorrectly (i.e. – backwards) on the reflected ceiling plans.
 - i) The room / classroom side walls should stop just above the acoustical ceiling as shown per typical door head details 1 & 2 on Sheet 4.33 and the corridor wall shall extend full height.
 - (1) Exception: At door B105 both walls extend to structure above as indicated per detail 9/4.33 & Sheet 6.10-1B.
- b) Metal soffit panels should be installed perpendicular to exterior walls. (typ)
- c) The Contractor shall furnish and install a 2-inch raceway from the (future) lift station to the CT cabinet under his Base Bid. Reference Sheet 2.70 for lift station location.
- d) The Contractor shall have the option of installing gypsum board assemblies over cross-corridor doors - in lieu of masonry - where walls are indicated to be sealed to the deck/structure above but also require large openings for the passage of ductwork or other items. This substitution shall be deemed acceptable provided the assembly is constructed to meet the same fire rating as would be required of the masonry wall. (e.g. – over doors D139-1 & D139-2)
- e) Interior Elevations: Generally speaking, the header assembly over typical classroom doors shall be constructed of gypsum board as indicated per the door head details identified per the Door Schedule. These wall areas inadvertently show up as masonry on several interior elevations – which is incorrect. The type of construction required over doors shall be dictated by the details referenced via the Door Schedule.

2) **REVISED BID FORM**

- a) By receipt of this Addendum, all bidders acknowledge receipt of a modified bid form. The bid form has been modified to include ADD Alternates No. 7A, 7B and 7C. Reference '***REVISED Form of Proposal***' form attached to the end of this addendum

3) **SECTION 012300 – ALTERNATES**

- a) CLARIFICATION: As noted in the description for ADD Alternate No. 1, the addition of classrooms E114, E118, E214 & E218 are to be accounted for on the basis of the Base Bid. As such, these rooms shall be priced accordingly in ADD Alternate No. 1.
- i) As specified, typical classrooms are to be priced with bare concrete floors per the Base Bid.
- (1) DO NOT include floor coverings in the ADD Alternate No.1 pricing for classrooms E114, E118, E214 & E218.
- b) Add ADD Alternates No. 7A, 7B & 7C to the *Schedule of Alternates* at the end of Section 012300, as follows:

J. [ADD] Alternate No. 7A – Siemens Auto Temp. Control / Building Automation System:

- 1. State the amount to be ADDED to the base bid furnish and install an Automatic Temperature Control/Building Automation System (ATC/BAS) as manufactured by Siemens (Apogee).***

a. The Base Bid shall not include any provisions for automatic temperature control / building automation systems.

i. ADD Alternate No. 7A / 7B / 7C shall take precedence over the automatic temperature control / building automation system provisions originally specified.

K. [ADD] Alternate No. 7B – Siemens Auto Temp. Control / Building Automation System:

- 1. State the amount to be ADDED to the base bid furnish and install an Automatic Temperature Control/Building Automation System (ATC/BAS) as manufactured by Schneider Electric (TAC/IA Series).***

a. The Base Bid shall not include any provisions for automatic temperature control / building automation systems.

i. ADD Alternate No. 7A / 7B / 7C shall take precedence over the automatic temperature control / building automation system provisions originally specified.

L. [ADD] Alternate No. 7C – Siemens Auto Temp. Control / Building Automation System:

- 1. State the amount to be ADDED to the base bid furnish and install an Automatic Temperature Control/Building Automation System (ATC/BAS) as manufactured by***

Distech Controls.

a. The Base Bid shall not include any provisions for automatic temperature control / building automation systems.

i. ADD Alternate No. 7A / 7B / 7C shall take precedence over the automatic temperature control / building automation system provisions originally specified.

2) SECTION 034500 – PRECAST ARCHITETCURAL CONCRETE

- a) Precast architectural concrete wall panel fabricators not designated as a PCI-certified plant for Category [AB] - *Architectural Cladding and Load Bearing Units* at time of bidding may be deemed acceptable to bid the ***Harrisburg High School – 9th Grade Academy*** project provided that they comply with the following provisions:
 - i) The fabricator must provide a minimum of five project references that are similar in size and scope that have been completed within the last two years. Project references must include the project name, location, general contractor, job superintendent, and contractor's phone number.
 - ii) The fabricator shall also meet or exceed all of the requirements set forth per PCI's Architectural Certification Program to be considered fully qualified as a PCI-certified plant for Certification Category [AC].
 - iii) The fabricator must submit a copy of their quality control procedure manual to both the Engineer of Record and the Architect of Record.
 - iv) The fabricator must submit the five references and a copy of their quality control manual to both the Engineer of Record and the Architect of Record for review and approval not less than five (5) days prior to the bid opening date.
 - v) Upon acceptable review of the information submitted, the fabricator may be pre-approved for bidding; pre-approved fabricators will be notified by the Architect of Record.
- b) Pre-Approved [Category - AC] Precast Architectural Concrete Wall Panel Fabricators:
 - i) Collins Precast; 19606 Collins Avenue, Iroquois, South Dakota is approved as an architectural concrete wall panel fabricator for this Project.
 - ii) Taracon Precast; 6189 170th St. N, Hawley, Minnesota is approved as an architectural concrete wall panel fabricator for this Project.

3) SECTION 088000 - GLAZING

- a) Add article 2.5.C. to Section 088000 as shown below:

C. Laminated Ceramic Glazing: Laminated glass made from plies of clear, ceramic flat glass; [1-1/2-inch] nominal overall thickness; complying with ASTM E119 and NFPA 251 (120 minutes with hose stream). Impact Safety Resistance: ANSI Z97.1 and CPSC 16CFR1201 (Cat. I and II).

1. *Products: Subject to compliance with requirements, [provide the following]:*
 - a. *Safti First; [SuperLite II-XL 120].*
2. *Fire Rating: [120 minutes].*
3. *Application: Install at all fire-rated [borrowed lite] [side lite] locations, including at door opening D103; see plans.*

4) SECTION 098433 – SOUND-ABSORBING WALL UNITS

- a) Provide 2-inch thick fabric-wrapped wall panels in the Auditorium; disregard all reference to 3-inch thick panels in the Auditorium.

- i) Revise article 2.3.B.10. to read as follows:

10. Thickness: 2 inch (NRC 1.05) unless noted otherwise on drawings. ~~3-inch (NRC 1.10) in Auditorium.~~

- b) Revise article 2.5.B.1.n. to read as follows:

n. Location: Commons B100.

- c) Revise article 2.5.B.1.o.1) to read as follows:

1) Utilized at locations noted as Tectum-2 on the drawings.

5) SECTION 230800 – VENTILATION AND AIR CONDITIONING

- a) Add the following to mechanical Section 230800:

DUST COLLECTOR:

Furnish and install a shop dust collection system.

Dust collection system shall consist of two principle components; a cyclone to collect larger particles and act as a spark-arrestor to minimize risk of fire, and an after-filter to filter out remaining dust and to act as a sound attenuator. Both components supplied with an epoxy primer under standard RAL # 7015 Slate Gray powder. Airflow of system shall be at least 3200 cfm @ 13.5" external static pressure.

The cyclone unit shall consist of a 30" diameter high-efficiency cyclone separator section, integrally mounted fan on "clean" side of cyclone, pressure relief door, supporting welded angle iron stand, and two 55 gallon drums with drum cover assemblies. The inlet shall be 12" diameter with companion ring for the inlet isolation device, and outlet to be 16".

Fan shall be backward-inclined design for non-overloading operation. Fan wheel shall be constructed of spark-resistant AMCA type "B". Fan motor shall be 15 HP TEFC rated for 460V, 3-phase, 60 Hz operation.

After-filter shall consist of a high-efficiency bag section, shaker assembly, weather-proof enclosure panels including 1 pressure-relief panel, automatic shaker controls, and a single

dust bin drawer. The top plenum of the after filter shall be outfitted with an acoustical lining to mitigate sound, and alignment legs providing the inlet to line up with the cyclone outlet. Clean air outlet 28" X 24" with a 90 degree up-turn transition to 16" diameter square to round transition.

After-filter shall have a minimum of 383 square feet of filter media. Media shall be Napped Polyester sateen with a seasoned efficiency of 99.9% at 1 micron.

After-filter shall be provided with an automatic electrically operated shaker mechanism including a 1/4 HP shaker motor (230/460V/3-ph/60hz) and an automatic shaker control.

Custom control panel shall be a single UL listed cabinet including motor starters, panel disconnects, circuit breakers, shaker controls, in a NEMA 12 enclosure, to be installed indoors.

Dust collector shall consist of Model 70SN70-D2 (Cyclone) and Model FT40 (After-filter) manufactured by Aget Mfg. or pre-approved equal.

The dust collector shall be provided with an inlet isolation device, mounted prior to the collector inlet per manufacturer's recommendation.

The inlet isolation device or "backdraft damper", shall be a gravity damper designed with a blade and counter weighted arm, to be installed horizontally. When air is not traveling through the pneumatic system, the damper blade should be in the closed resting position, not latched. When air is traveling through the pneumatic system, the blade will be freely drawn open.

In the event of reverse airflow through the backdraft damper, the blade is designed to slam shut and latch in the closed position. A blade/shaft latch assembly is mounted on the side of the unit with an arm that is attached to the blade shaft. A grid bar supported aluminum explosion vent mounted to the top of the backdraft damper will then deploy, relieving pressure vertically into the atmosphere.

The backdraft damper shall be equipped with a limit switch to provide an electrical signal to the control panel, indicating that the damper is in the closed/latched position. When triggered, the limit switch shall eliminate power to the fan motor of the dust collector. Wiring of the limit switch to the control panel shall be provided by others.

The damper shall be constructed of 12 ga continuous welded steel, primed and finished with 2 coats of industrial OSHA Yellow enamel.

The inlet isolation device shall be a single Clarke's 12" diameter integrated backdraft damper & explosion vent w/ limit switch.

Provide Safety Monitoring Filter (SMF) for air being returned to woodshop from the dust collection system. SMF to be installed on the interior of the woodshop as high up as is practical. SMF to be rated for an airflow of up to 4000cfm. SMF to consist of the following components:

- 1. Transition ductwork. (by Mechanical Contractor) Provide and install transition of galvanized sheet metal to adapt incoming ductwork to SMF Glide pack in accordance with best industry practices.*
- 2. SMF Farr Rigi-Flo Glide Pack. 2 Stage dual side access housing to be constructed of 16-gage galvanized steel with polyurethane gasketing.*

3. **Safety Filters.** - Provide and install 2 - Farr Riga-Flo 200 safety filters. Each filter to have a nominal dimension of 23-3/8" x 23-3/8" x 12" (deep) and each be capable of airflows up to 2000cfm. Filters will have a minimum ASHRAE 52.5-1999 MERV-rating of 14. Pre filters. 2 - Farr 30/30 pre filters- medium efficiency ASHRAE 25-30%.
4. **Magnahelic Gage.** Provide and install a Magnahelic gage and mounting kit for monitoring pressure-drop across the safety filters. Gage to be installed in proximity to the dust collector motor starter controls. Gage will have a range of 0-4" w.c. High-pressure side of gage shall be connected to SMF ductwork transition ("dirty-side" of safety filters) by means of UV-resistant 1/4" black poly-tubing. Low-pressure side of gage shall be open to atmosphere.

b) Add the following to the *DUCTLESS MINISPLIT* article in mechanical Section 230800:

Indoor, under-ceiling mounted, direct-expansion fan coil to be matched with the commercial condensing unit. Units shall be rated (when matched with appropriate outdoor unit) per ARI Standard 210/240. Units shall be certified by UL and CSA. DELIVERY, STORAGE, AND HANDLING Units shall be stored and handled per manufacturer's recommendations. **Warranty shall be for one year.**

Indoor, direct-expansion, ceiling-suspended fan coil. Fan coil shall be shipped complete with cooling coil, fan, fan motor, piping connectors, electrical controls, solid-state electromechanical control system, and ceiling mounting brackets. Cabinet shall be zinc-coated bonderized steel finished with a baked enamel paint. Inlet grilles shall be attractively styled, high-impact polystyrene. Matching mounting brackets shall be provided. Fans shall be centrifugal blower type with air intake in the bottom rear of the unit and discharge in the front. Automatic motor-driven vertical air sweep shall be provided.

Coils shall be copper tube with aluminum fins and galvanized steel tube sheets. Fins will be bonded to the tubes by mechanical expansion. A drip pan under the coil shall have a drain connection for attachment of piping to remove condensate.

Motors shall be permanently lubricated with inherent overload protection. Fan motor shall be 3-speed.

Controls shall consist of a solid-state electromechanical control system which shall control space temperature and determine optimum fan speed. The temperature control range shall be from 64 F to 84.

The unit shall have the following functions as a minimum:

1. **An automatic restart after power failure at the same operating conditions as at failure.**
2. **Non-programmable thermostat to provide cooling and heating set points and day/night set-back modes.**
3. **Wired control to enter set points and operating conditions.**
4. **Filter status indication after 250 hours of indoor fan operation.**
5. **Automatic airsweep control to provide on or off activation of airsweep louvers.**
6. **Cooling mode to provide modulating fan speed based on difference between temperature set-point and space temperature.**
7. **Fan only operation to provide room air circulation when no cooling is required.**

8. *A 50-ft indoor to outdoor control connection cable shall be provided with the fan coil unit.*
9. *Fan speed control shall be user-selectable: high, medium, low, or automatic operation during all operating modes.*

Unit shall have filter track with factory-supplied cleanable filters.

Unit shall operate on a 208-v or 230-v, 60 Hz power supply as specified on the equipment schedule.

A field installed, manufacturer provided, condensate pump shall remove condensate from the pan when gravity cannot be used. The lift capability shall be 20 inches. Float control shall be in the condensate sump to shut unit down in case of pump malfunction.

Thermostat shall be commercial grade and shall provide 7-day, 4-event scheduling. Integral sub-base shall be included. Thermostat shall also provide 3-speed fan switchover capability, air sweep auto changeover, and shall not require a battery to retain memory.

Ductless split systems shall be Carrier, Daikin, Mitsubishi or equal.

6) SECTION 230900 – AUTOMATIC TEMPERATURE CONTROL / BAS

- a) Modify article 1.23 in mechanical Section 23900 as follows:

1.23 – SEQUENCE OF OPERATION:

Welding Hood Fan and Transfer Fan:

Modulate VFD for the welding hood fan to maintain a duct static pressure of 2.5” (adj.). Modulate VFD for transfer fan to maintain a -0.05” W.C. space pressure with relation to the adjacent corridor. Provide a current switch or differential pressure switch across the fan to prove fan operation and provide status on graphics.

Combustion Air Control:

Whenever boilers B-1 or B-2 fire, the Boiler Room AHU shall be modulate the RA and OA air dampers to maintain the boiler room at a neutral pressure in relation to the commons space. The Boiler Room AHU and combustion air dampers shall also act as an intake air damper and open whenever the boiler room exhaust fan is started. The Boiler room AHU and RA/OA air dampers shall be open before the burner operates. Boiler room AHU shall modulate the heating water valve and activate the coil pump to maintain space set point.

Equipment Room Exhaust Fans:

A space temperature sensor shall enable the boiler room AHU and start the exhaust fan if the space temperature rises above 80 degrees F. (adj.). The boiler room AHU shall modulate the RA and OA dampers to maintain a neutral pressure in the boiler room with respect to the commons. The BAS shall monitor the refrigeration leak detection system to start the EF and AHU. The BAS shall deactivate the boilers and water heaters when the refrigerant monitor is in alarm. Provide a current switch or differential pressure switch across the fan to prove fan operation and show status on the graphic. If operation is not proven after the BAS has commanded the fan to start, an alarm shall be initiated at the

operator's workstation.

Data rooms shall have a space sensor to start the EF and alarm the BAS whenever the space temperature is 5 degrees above setpoint.

7) SHEET 2.10 – TOPOGRAPHIC SURVEY

- a) Add the following plan note to Sheet 2.10:

WARNING. HIGH PRESSURE PIPELINE(S). EXCAVATION AND/OR CONSTRUCTION PROHIBITED WITHOUT COMPLIANCE WITH STATE ONE-CALL, AND WITHOUT WRITTEN PERMISSION FROM MAGELLAN PIPELINE COMPANY.

8) SHEET 2.60 – OVERALL GRADING PLAN

- a) Add the following plan note to Sheet 2.60:

WARNING. HIGH PRESSURE PIPELINE(S). EXCAVATION AND/OR CONSTRUCTION PROHIBITED WITHOUT COMPLIANCE WITH STATE ONE-CALL, AND WITHOUT WRITTEN PERMISSION FROM MAGELLAN PIPELINE COMPANY.

9) SHEET 2.61 – DRAINAGE PLAN

- a) Add the following plan note to Sheet 2.61:

WARNING. HIGH PRESSURE PIPELINE(S). EXCAVATION AND/OR CONSTRUCTION PROHIBITED WITHOUT COMPLIANCE WITH STATE ONE-CALL, AND WITHOUT WRITTEN PERMISSION FROM MAGELLAN PIPELINE COMPANY.

10) SHEET 2.62 – DRAINAGE PLAN

- a) Add the following plan note to Sheet 2.62:

WARNING. HIGH PRESSURE PIPELINE(S). EXCAVATION AND/OR CONSTRUCTION PROHIBITED WITHOUT COMPLIANCE WITH STATE ONE-CALL, AND WITHOUT WRITTEN PERMISSION FROM MAGELLAN PIPELINE COMPANY.

11) SHEET 2.63 – DRAINAGE PLAN

- a) Add the following plan note to Sheet 2.63:

WARNING. HIGH PRESSURE PIPELINE(S). EXCAVATION AND/OR CONSTRUCTION PROHIBITED WITHOUT COMPLIANCE WITH STATE ONE-CALL, AND WITHOUT WRITTEN PERMISSION FROM MAGELLAN PIPELINE COMPANY.

12) SHEET 2.70 – UTILITY PLAN

- a) Add the following plan note to Sheet 2.70:
WARNING. HIGH PRESSURE PIPELINE(S). EXCAVATION AND/OR CONSTRUCTION PROHIBITED WITHOUT COMPLIANCE WITH STATE ONE-CALL, AND WITHOUT WRITTEN PERMISSION FROM MAGELLAN PIPELINE COMPANY.
- b) Callout W7 has been changed from ~~2 - 8" x 6" MJ Gate Valves~~ to **2 - 8" x 6" MJ Tees.**

13) SHEET 2.71 – UTILITY CROSSINGS

- a) Add the following plan note to Sheet 2.71:
WARNING. HIGH PRESSURE PIPELINE(S). EXCAVATION AND/OR CONSTRUCTION PROHIBITED WITHOUT COMPLIANCE WITH STATE ONE-CALL, AND WITHOUT WRITTEN PERMISSION FROM MAGELLAN PIPELINE COMPANY.

14) SHEET 3.10 – SPECIFICATIONS

- a) Reference Design Criteria heading: Change ~~Design Code: 2018~~ to **Design Code: 2021.**

15) SHEET 3.20-1C – FOUNDATION PLAN – AREA C

- a) Change dimension of ~~7'-6 1/16"~~ to **7'-2"** between north and south side precast walls in Vestibule C102.
- b) Change dimension of ~~6'-10"~~ to **6'-8"** between north and south side precast walls in Vestibule C103.

16) SHEET 3.20-1E – FOUNDATION PLAN – AREA E

- a) CLARIFICATION: Sump basins shall be installed in the SW corner of Storage D140A as indicated on mechanical drawing Sheet 8.20-1E; Contractor to coordinate accordingly.

17) SHEET 3.20-2A – MECH / PENTHOUSE FLOOR & LOW ROOF – AREA A

- a) Change the elevation of the W8x24 steel lintel above door A104-1 from elevation ~~(12'-0")~~ to **(-8'-8")**.

18) SHEET 3.20-2B – MECH / PENTHOUSE FLOOR & LOW ROOF – AREA B

- a) Reference gridline Bk: Add 1/4" bottom plate to W8x24 between gridlines B11/B12.
- b) Reference gridline Bk: Add 1/4" bottom plate to W8x24 between gridlines B14/B17.
- c) Reference gridline Bk: Add W8x24* steel lintel with elevation **(-8'-8")** for Door B105 wall opening. Top of steel for W16x26* to be **(13'-4")** west of gridline B11.

- d) Reference gridline Bk: Bottom of steel for W16x26* lintel for Door B120 is to be (-8'-0").

19) SHEET 3.20-2E – SECOND FLOOR – AREA E

- a) Add section cut for detail 9/3.61 along gridline E3 between gridlines Ec and Ed. Label as “**Base Bid**”.
- b) Provide composite acoustical floor deck throughout Corridor E200 / Learning Center E215 between Grid E2 & Grid E17 and between Grid Ec & Ed. Reference Section 053100 for additional information.
- i) Provide 2-inch galvanized cellular acoustic composite steel deck with insulation (18 ga / 18 ga).

20) SHEET 3.20-3A – HIGH ROOF – AREA A

- a) Add section cut for detail 8/3.70 along entire length of west side deck bearing precast wall of Auxiliary Gym A100.
- b) Add section cut for detail 8/3.70 along entire length of east deck bearing precast wall of Auxiliary Gym A100.

21) SHEET 3.20-3D – MAIN ROOF – AREA D

- a) Omit all references to acoustical roof deck over Media Center D137; not required. Furnish and install typical non-acoustic roof deck over Media Center D137.

22) SHEET 3.20-3E – MAIN ROOF – AREA E

- a) Reference steel framing between grid intersections Ec-E3 and Ee-E3. Add HSS10x8x3/8 girt at head of curtainwall system for Base Bid. Girt not required for add alternate. Connect girt to columns at grid intersections Ec-E3 and Ee-E3. See section 6/5.57 for additional information.
- b) Reference steel framing between grid intersections Ec-E3 and Ee-E3. Replace note ~~Base Bid: HHS12x8x3/8 (LONG SIDE VERTICAL)~~ with **Base Bid: HHS10x8x3/8 (LONG SIDE VERTICAL)**. See section 6/5.57 for additional information.
- c) Reference steel framing between grid intersections Ec-E3 and Ee-E3. Replace note ~~ADD ALT: #12x44~~ with **ADD ALT W21x44**.
- d) Provide acoustical roof deck over Learning Center E215 between Grid E2 & Grid E3 and between Grid Ec & Ed (as a part of ADD Alternate No. 1). Reference Section 053100 for additional information.


23) SHEET 3.20-4E – MAIN ROOF – AREA E

- a) Reference the W16x26 steel beam along gridline E3: Add L3x3x1/4 vertical posts @ 4'-0" to brace offset stud wall parapet similar to detail 3/3.81. Reference section 6/5.57 for additional information.

29) SHEET 4.10-2A – MECHANICAL PENTHOUSE PLAN – AREA A

- a) CLARIFICATION: A 42-inch high steel pipe guardrail (and 4-inch high concrete curb) shall be installed continuous around the north and east side of the stair opening in Mechanical A200.
 - i) Reference 13 / 5.42 for guardrail details.
- b) CLARIFICATION: The stair assembly serving Mechanical A200 shall be constructed as steel pan treads with concrete in-fill; stringers to be fabricated from steel channels.
- c) CLARIFICATION: The continuous cast-in-place concrete curb shown around the perimeter of Mechanical A200 shall measure 4" high x 6" wide. (typ)
 - i) The cast-in-place curb shall be integral with the elevated concrete landing at the top of the penthouse stair; T.O. Concrete at top of stair landing shall be 13'-8", as indicated per plan.
- d) CLARIFICATION: A 42-inch high steel pipe guardrail shall be installed continuous along the north edge of Storage A201. This guardrail shall also continue along the east edge of Storage A201 - adjacent the stair opening that leads up to Storage A201.
 - i) Reference the guardrail detail below which is to be utilized at Storage A201.

GUARDRAIL DETAIL – 10/5.42 – STORAGE A201
REF SECTION 2/5.40

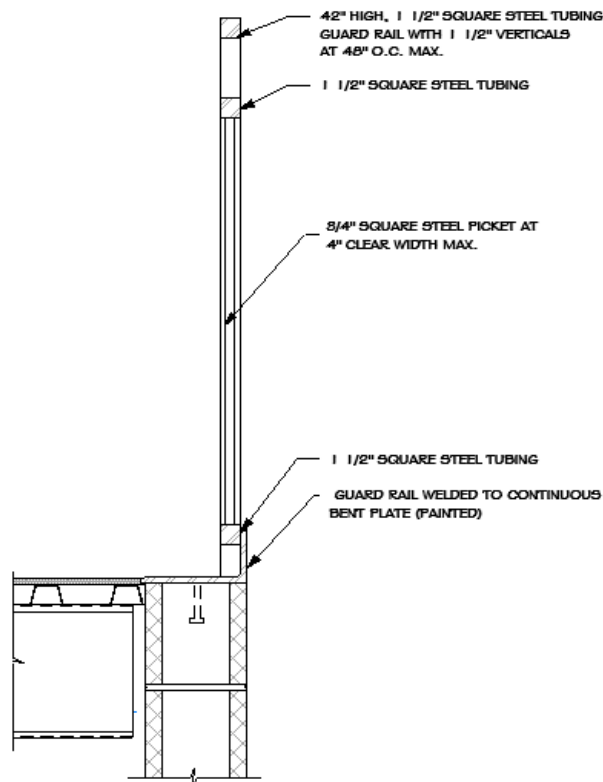

- e) CLARIFICATION: The stair assembly serving Storage AC201 shall be constructed as steel pan treads with concrete in-fill; stringers to be fabricated from steel channels.


30) SHEET 4.10-2B – MECHANICAL PENTHOUSE PLAN – AREA B

- a) CLARIFICATION: A 42-inch high steel pipe guardrail (and 4-inch high concrete curb) shall be installed continuous around the north and east side of the stair opening in Mechanical B200.
 - i) Reference 13 / 5.42 for guardrail details.
- b) CLARIFICATION: The continuous cast-in-place concrete curb shown around the perimeter of Mechanical B200 shall measure 4" high x 6" wide. (typ)
 - i) The cast-in-place curb shall be integral with the elevated concrete landing at the top of the penthouse stair; T.O. Concrete at top of stair landing shall be 14'-10", as indicated per plan.

31) SHEET 4.10-2C – MECHANICAL PENTHOUSE PLAN – AREA C

- a) CLARIFICATION: A 42-inch high steel pipe guardrail (and 4-inch high concrete curb) shall be installed continuous around the north, east and west sides of the stair opening in Mechanical C200.
 - i) Reference 13 / 5.42 for guardrail details.
- b) CLARIFICATION: The continuous cast-in-place concrete curb shown around the perimeter of Mechanical C200 shall measure 4" high x 6" wide. (typ)
 - i) The cast-in-place curb shall be integral with the elevated concrete landing at the top of the penthouse stair; T.O. Concrete at top of stair landing shall be 12'-6", as indicated per plan.
- c) CLARIFICATION: A 42-inch high steel pipe guardrail shall be installed continuous around the north and west sides of the stair opening in Storage C201.
 - i) Reference the guardrail detail below which is to be utilized at Storage C201

GUARDRAIL DETAIL - 11/5.42 – C201 STORAGE
REF SECTION 5/5.40

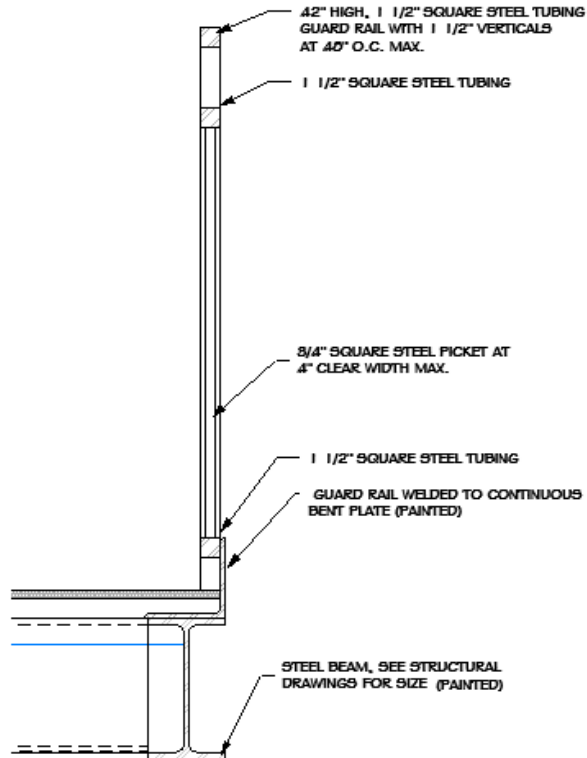

- d) CLARIFICATION: The stair assembly serving Storage C201 shall be constructed as steel pan treads with concrete in-fill; stringers to be fabricated from steel channels.
- e) CLARIFICATION: A 42-inch high steel pipe guardrail shall be installed continuous around the west and south sides of Storage C202. A small length of 42-inch high steel pipe guardrail shall also be installed at the SE corner of Storage C202 – adjacent the stairs.
 - i) The type / style of guardrail utilized at Storage C202 shall match the guardrail shown to be installed at Storage C201.
 - (1) The railing shall be attached to / embedded within the CMU (or cast-in-place concrete) curb that occurs around the edge of the storage area floor; see plans.

32) SHEET 4.10-2D – SECOND FLOOR PLAN – AREA D

- a) CLARIFICATION: A 42-inch high steel guardrail with perforated metal in-fill shall be installed continuous around the north and east sides of the 2nd Floor stair opening at Stair D200.
 - i) Reference 2 / 5.42 for guardrail details.
- b) CLARIFICATION: A 42-inch high steel guardrail with perforated metal in-fill shall be installed continuous around the north and east sides of the 2nd Floor stair opening at Stair D207A.

- i) Reference 2 / 5.42 for guardrail details.

33) SHEET 4.10-2E – SECOND FLOOR PLAN – AREA E

- a) CLARIFICATION: A 42-inch high steel guardrail with perforated metal in-fill shall be installed continuous around the north and west sides of the 2nd Floor stair opening at Stair E219.
- i) Reference 2 / 5.42 for guardrail details.

34) SHEET 4.10-3E – MECH. PENTHOUSE CLERESTORY PLAN – AREA E

- a) CLARIFICATION: A 42-inch high steel guardrail shall be installed continuous around the north and east sides of the stair opening in Mechanical E300.
- i) Guardrail details to be similar to 13 / 5.42.

35) SHEET 4.20-1C – FIRST FLOOR FINISH PLAN – AREA C

- a) Small Theatre C101 – VESTIBULES C101 and C102: Change wall types labeled ‘C2’ to be precast concrete wall panels, 12” thick. See structural Addendum #2 items for additional information.

36) SHEET 4.20-1D – FIRST FLOOR FINISH PLAN – AREA D

- a) Storage D111A: Provide PNT-1 at all walls in this room. Drywall finish and paint to run continuous from floor to roof deck; no base will be installed along the bottom of walls – as indicated per the Room Finish Schedule. Joists and roof deck to remain un-painted – as indicated per the Room Finish Schedule.
- b) Storage D141A: Provide PNT-1 at all walls in this room. Drywall finish and paint to run continuous from floor to roof deck; no base will be installed along the bottom of walls – as indicated per the Room Finish Schedule. Joists and roof deck to remain un-painted – as indicated per the Room Finish Schedule.

37) SHEET 4.20-2D – SECOND FLOOR FINISH PLAN – AREA D

- a) Storage D205A: Provide PNT-1 at all walls in this room. Drywall finish and paint to run continuous from floor to roof deck; no base will be installed along the bottom of walls – as indicated per the Room Finish Schedule. Joists and roof deck to remain un-painted – as indicated per the Room Finish Schedule.
- i) Disregard Item 19.b. in Addendum #1 that omitted the painted wall in this space.

38) SHEET 4.30 – DOOR SCHEDULE

- a) Door D103: Provide SCWOOD door with 90 minute fire-rating label.
- i) Provide HM frame with 120 minute fire-rating label.

ii) The glass in the HM sidelite of frame Type 6 shall also be fire rated for 90 minutes.

(1) Reference 120 minute fire rated glass specifications listed elsewhere in this addendum.

- b) Door D103: The Contractor shall provide a light gauge metal plate at the head of door D103 to close the gap that will be created between the two (2) steel lintels; plate to be welded in place. Exact details to be coordinated with Contractor at later date.
- c) Door D103: Provide door hardware Group #9 in lieu of Group #1.
- d) **CORRECTION:** Per Addendum No. 1 the head detail at doors D014A and D118 was incorrectly identified as 7/4.32. The correct head detail should actually be *revised* detail 26/4.32 (i.e. – 1/SD-7) as indicated on supplemental drawing SD-7 (attached to the end of Addendum No. 2).
- e) **CORRECTION:** Per Addendum No. 1 the jamb detail at door D014A and D118 was incorrectly identified as 7/4.32. The correct jamb detail should actually be *revised* detail 26/4.32 (i.e. – 2/SD-7) as indicated on supplemental drawing SD-7 (attached to the end of Addendum No. 2).

39) SHEET 4.31 – DOOR SCHEDULE

- a) Doors E100, E100-1, E200 and E200-1 are **NOT** required to be labeled as fire-rated door assemblies.
 - i) Disregard all references to 90 minute fire rating at doors E100, E100-1, E200 and E200-1.
 - ii) Disregard all references to fire-rated glazing in all Type D door leafs at door openings E100, E100-1, E200 and E200-1.
 - iii) Door hardware at doors E100, E100-1, E200 and E200-1 shall not be listed/labeled as fire-rated door hardware.
- b) Omit HM frame Type 9; NOT USED.

40) SHEET 4.32 – DOOR DETAILS

- a) Borrowed Lite Types:
 - i) Add borrowed lite type '4': Type 4 shall be a 7'-4" wide frame that is 4'-0" high with a 4" head. Provide 2 intermediate vertical mullions.
 - (1) Borrowed lite Type '4' to be used at Area E Conference rooms E116, E117, E216, E217.
 - (2) Reference floor plan sheets 4.10-1E and 4.10-2E; change borrowed lite Type 6 indicated on floor plan to Type 4.
 - ii) Borrowed lite Type '6': Change height from 4'-0" to 7'-4". Provide a 4" sill at the floor and add a horizontal mullion to match borrowed lite frame Type '2' with top of horizontal mullion at 3'-2".
 - (1) Head detail shall be 10/4.33 and jamb detail shall be 11/4.33.

- (a) Provide ¼" safety glazing where the nearest vertical edge of the glazing is within a 24-inch arc of either vertical edge of the door in a closed position.
- iii) Borrowed lite Type '7': Change height from 6'-8" to 7'-4". Sill should be placed at the floor. Provide a 4" sill at the floor and add a horizontal mullion to match borrowed lite frame Type '2' with top of horizontal mullion at 3'-2".
- iv) Borrowed lite Type '8': Omit this borrowed lite. This borrowed lite type is not used.
- v) Borrowed lite Type '9': Change overall height to 4'-0". Install top of head at 7'-4" AFF at 1st and 2nd Floors.
- b) Borrowed Lite Types Schedule:
 - i) Add borrowed lite Type '4': Hollow metal frame, ¼" clear glass, head detail 5/4.33, jamb detail 6/4.33 and sill detail 7/4.33.
 - ii) Borrowed lite Type '6': Head detail to be 10/4.33 and jamb detail to be 11/4.33.
 - (1) Add Note: Provide ¼" safety glazing where the nearest vertical edge of the glazing is within a 24-inch arc of either vertical edge of the door in a closed position.
 - iii) Borrowed lite Type '8A': Change head detail to 15/4.31, change jamb detail to 16/4.31 and change sill detail to 17/4.31.
- c) Detail 26/4.32 and 27/4.32: Change door frame head to 4" head. Locate door frame 7 5/8" from the face of the CMU to cover the joint between the concrete blocks and locate the north face of the door 7 5/8" from the face of the wall.

41) SHEET 4.55 – INTERIOR ELEVATIONS – AREA C

- a) Elevation K/4.553 (C108 Hall): Provide (painted) gypsum board over door C116 as shown per detail 1 /4.33

42) SHEET 4.56 – INTERIOR ELEVATIONS – AREA C

- a) CLARIFICATION: All wall-mounted, fabric-wrapped acoustical panels installed in Small Theater C101 shall be random absorption diffusion (RAD) type wall panels, as specified per Section 098433.

43) SHEET 4.57 – INTERIOR ELEVATIONS – AREA D

- a) Elevation C/4.57 – D137 Media Center – West: Install borrowed lite frame Type 9 at 7'-4" AFF at 1st and 2nd Floors.

44) SHEET 5.20 – EXTERIOR FRAME ELEVATIONS

- a) CLARIFICATION: All exterior glass shall be 1" clear, low-e insulated glazing units unless specifically identified otherwise on per frame elevations or the Door Schedule.

45) SHEET 5.21 – EXTERIOR FRAME ELEVATIONS

- a) CLARIFICATION: All exterior glass shall be 1” clear, low-e insulated glazing units unless specifically identified otherwise on per frame elevations or the Door Schedule.

46) SHEET 5.22 – WINDOW AND STOREFRONT DETAILS

- a) Window Type Schedule: The operable sashes at all Type B, B1, B2, B3 & B4 windows shall be 16 inches tall; change the 4’-3” dimension to 1’-4”.
- b) Window Type Schedule: The intermediate horizontal mullion(s) at window Types A, C, C1, C2, C3, C4, F & G shall be changed to match the height of the operable sashes at all Type B, B1, B2, B3 & B4 windows; see above. Change the 4’-3” dimension to 1’-4”.
 - i) The intermediate horizontal mullion(s) at window Type E shall be changed to match the height of the operable sashes at all Type B, B1, B2, B3 & B4 windows; see above. Change the 4’-4” dimension to 1’-4”.

47) SHEET 5.36 – BUILDING SECTIONS AREA E

- a) B/5.36 – SECTION AREA E – see attached new drawing sheet 5.57 for details at grids E1, E2 and E3 for large scale details at base bid and add alternate #1.
- b) C/5.36 – Conference Rooms E116, E117 – extend masonry walls up to bottom of steel beam/floor deck above.

48) SHEET 5.40 – ENLARGED ELEVATOR AND STAIR SECTIONS

- a) Omit the full guardrail assembly shown along the west side of the steel pan stairs leading up to Storage A201; refence stair section 2 / 5.40.
 - i) Provide a wall-mounted steel pipe handrail on each side of this stair.
 - (1) The steel pipe handrail on the west side of the stair shall be fabricated in a manner such that the north end of the railing continues/extends the full length of the stair run (including required horizontal extension).
 - (a) The handrail assembly shall include a vertical post near the bottom of the stair to support the northernmost end of the handrail.
 - (b) The vertical post shall be welded to the top of the stair stringer. (typ)
- b) The triangle-shaped gypsum board in-fill area shown along the west side of the stair serving Storage A201 shall be supported from the side of the stair stringer. (typ) Reference section 2/5.40.
- c) The triangle-shaped gypsum board in-fill area shown along the north side of the stair serving Mechanical B200 shall be supported from the side of the stair stringer. (typ) Reference section 3/5.40.

- d) The triangle-shaped gypsum board in-fill area shown along the west side of the stair serving Mechanical C200 shall be supported from the side of the stair stringer. (typ) Reference section 4/5.40.
- e) CLARIFICATION: Provide a wall-mounted steel pipe handrail along the east side of the stair serving Storage C201.
- f) Omit the full guardrail assemblies shown along the north and west sides of the steel pan stairs leading up to Storage C202; reference stair sections 9 & 10 / 5.40.
 - i) Provide a (continuous) wall-mounted steel pipe handrail on each side of this stair.
 - ii) Provide steel stud framing and gypsum board sheathing along the west side of the upper stair run to in-fill in the triangle-shaped opening that occurs adjacent the stair. Support gypsum board assembly from the side of the stair stringer. (typ)

49) SHEET 5.41 – ENLARGED STAIR PLANS AND SECTIONS

- a) CLARIFICATION: A 42-inch high steel guardrail with perforated metal in-fill shall be installed continuous around the north and east sides of the 2nd Floor stair opening at Stair D207A.
 - i) Reference 2 / 5.42 for guardrail details.
- b) CLARIFICATION: A 42-inch high steel guardrail with perforated metal in-fill shall be installed continuous around the north and east sides of the 2nd Floor stair opening at Stair D200.
 - i) Reference 2 / 5.42 for guardrail details.
- c) CLARIFICATION: The guardrail assembly along the south side of the intermediate landing of Stair E219 shall be fabricated with perforated metal in-fill; reference enlarged stair plans 2 & 3 / 5.41 and typical guardrail detail 2 / 5.42. Weld guardrail to top of tube steel framing at landing. (typ)
- d) CLARIFICATION: The guardrail assembly along the west side of the intermediate landing of Stair D200 shall be fabricated with perforated metal in-fill; reference enlarged stair plans 6 & 7 / 5.41 and guardrail detail 2 / 5.42. Weld guardrail to top of tube steel framing at landing. (typ)

50) SHEET 5.42 – STAIR AND RAILING DETAILS

- a) CLARIFICATION: A 4-inch high cast-in-place concrete landing shall be provided at the top of all mechanical penthouse stairs as indicated per the floor plans.
 - i) The stair supplier shall make provisions for these landings when detailing / fabricating his steel pan stair assemblies, even though the 4-inch high cast-in-place concrete landings are not specifically identified in section detail 5 / 5.42.
- b) The bottom of steel stair stringers shall be terminated vertically at the bottom of the stair run; omit the horizontal stringer extension identified as *mounting location for guardrail post*.
 - i) Lower guardrail posts shall be mounted to the top of the sloped stringers. (typ)

- ii) Handrail extensions shall be designed to return back horizontally to the lowest guardrail post; bottom of horizontal return shall be located not more than 27" A.F.F.

51) SHEET 5.57 – SECTION DETAILS

- a) See attached **NEW** architectural drawing Sheet 5.57 with new enlarged details per below:
 - i) Details 1, 2 & 3/5.57 – refer to building section J/5.34, grid EA for location of these details.
 - ii) Details 4, 5/5.57 – refer to building section B/5.36 for location.
 - iii) Reference new exterior building elevation 7 / 5.57 which now shows the west exterior elevation of Area E – per the Base Bid.

52) SHEET 6.10-1A – FIRST FLOOR PLAN REFLECTED CEILING PLAN – AREA A

- a) CLARIFICATION: The head detail / section cut referenced over doors A104 & A104-1 is incorrectly shown as 3/6.20 on Sheet 6.10-1A.
 - i) Change detail reference over doors A104 & A104-1 to 4/4.33, as indicated per the Door Schedule on Sheet 4.30.

53) SHEET 6.10-1A – FIRST FLOOR PLAN REFLECTED CEILING PLAN – AREA A

- a) CLARIFICATION: The head detail / section cut referenced over doors A104 & A104-1 is

54) SHEET 6.10-2B – FIRST FLOOR REFLECTED CEILING PLAN – AREA B

- a) Reference *revised* architectural drawing Sheet 6.10-2B, *revision* dated 12-10-21, attached to the end of this addendum for modifications to the acoustical ceilings in Commons B100, including additional suspended baffles, additional light fixtures and revisions to HVAC ductwork / diffusers.

55) SUPPLEMENTAL DRAWINGS

MECHANICAL ITEMS:

1) SHEET 8.10 – LEGEND & DETAILS

- a) AHU-9 Heating/Cooling Coil Piping Diagram:
 - i) Substitute “AHU-2 & AHU-9 Heating/Cooling Diagram Coil Piping Diagram” title for the AHU-9 title listed previously. Refer to revised drawing sheet 8.10, ADDM M2, dated 12/10/21.

- ii) Substitute a calibrated balance valve in the by-pass piping for the balance valve previously shown. Refer to revised drawing sheet 8.10, ADDM M2, dated 12/10/21.
- b) Add AHU-11 Heating Coil Piping Diagram. Refer to revised drawing Sheet 8.10, ADDM M2, dated 12/10/21.

2) SHEET 8.11 – DETAILS

- a) Water Heating Piping Detail:
 - i) Add piping sizes & thermal expansion tank size. Refer to revised drawing Sheet 8.11, ADDM M2, dated 12/10/21.

3) SHEET 8.12 – SCHEDULES

- a) CONDENSING UNIT SCHEDULE: Add note 3 to provide 5K SCCR rating.
- b) DUST COLLECTOR SCHEDULE: Add note 5 to provide 5K SCCR rating.
- c) VAV TERMINAL SCHEDULE: Add VAV-A103, VAV-A104 and VAV-A112 to the schedule.
- d) AIR HANDLING UNIT SCHEDULE: Revise AHU-1.
- e) FAN SCHEDULE: Revise EF-B120.

4) SHEET 8.13 – SCHEDULES

- a) BOILER SCHEDULE: Add note 6 to provide 5K SCCR rating.
- b) COOLING TOWER SCHEDULE: Add to note 2 to provide 5K SCCR rating.
- c) REGISTER, GRILLE & DIFFUSER SCHEDULE: Revise G6 to have a neck size of 48/24.
- d) PUMP SCHEDULE: Add AHU-11 heating coil pump P-23. Refer to revised drawing sheet 8.13, ADDM M2, dated 12/10/21.

5) SHEET 8.20-1A – FIRST FLOOR PLAN – AREA A – PLUMBING & HEATING

- a) CORRIDOR A103: Add VAV-A103 & associated piping. Refer to revised drawing sheet 8.20-1A, ADDM M2, dated 12/10/21.

6) SHEET 8.20-1B – FIRST FLOOR PLAN – PLUMBING & HEATING

- a) VESTIBULE B103: Add 3" roof drain & associated piping. Refer to revised drawing sheet 8.20-1B, ADDM M2, dated 12/10/21.
- b) VESTIBULE B103: Modify piping to FP-B101. See sheet 8.40-1B, ADDM M2, dated 12/10/21.

7) SHEET 8.20-1BA – ENLARGED BOILER ROOM PLAN – AREA B – PLUMBING & HEATING

- a) STOR./REC./MECH./ELEC. ROOM B130: Add 1 ½” drain with shutoff valve on cooling tower piping. Refer to revised drawing sheet 8.20-1BA, ADDM M2, dated 12/10/21.

8) SHEET 8.20- 2A – SECOND FLOOR PLAN – AREA A – PLUMBING & HEATING

- a) MECHANICAL ROOM A200 & STORAGE ROOM A201: Add VAV-A104 & VAV-A112 & associated piping. Refer to revised drawing sheet 8.20-2A, ADDM M2, dated 12/10/21.

9) SHEET 8.20-2B – ENLARGED MECHANICAL ROOM – AREA B – PLUMBING & HEATING

- a) MECHANICAL B200: Add inline pump P-23 to serve AHU-11 heating coil. Refer to revised drawing sheet 8.20-2B, ADDM M2, dated 12/10/21.

10) SHEET 8.40-1A – FIRST FLOOR PLAN – AREA A – VENTILATION & A/C

- a) Revise supply and return duct drops. Add VAV-A104, thermostat for VAV-A112 in Training A112 and thermostat for VAV-A103. Refer to revised drawing sheet 8.40-1A, ADDM M2, dated 12/10/21.

11) SHEET 8.40-1B – FIRST FLOOR PLAN – AREA B – VENTILATION & A/C

- a) Revise note 11 to add **PROVIDE INSULATED ROOF CURB FOR FUTURE FAN LOCATION**. Refer to revised drawing sheet 8.40-1B, ADDM M2, dated 12/10/21.
- b) Revise location of FP-B101. Refer to revised drawing sheet 8.40-1B, ADDM M2, dated 12/10/21.

12) SHEET 8.40-1E – FIRST FLOOR PLAN – AREA E – VENTILATION & A/C

- a) Revise 12” ø duct to FP-E118. Add Note 7: **EXPOSED SPIRAL DUCT THRU CORRIDOR SHALL BE DOUBLE WALL CONSTRUCTION**. Provide flared out opening at end of main return duct. Refer to revised drawing sheet 8.40-1E, ADDM M2, dated 12/10/21.

13) SHEET 8.40-2A – SECOND FLOOR PLAN – AREA A – VENTILATION & A/C

- a) Revise supply and return duct drops. Add VAV-0a104 and VAV-A112. Refer to revised drawing sheet 8.40-2A, ADDM M2, dated 12/10/21.

14) SHEET 8.40-2C – SECOND FLOOR PLAN – AREA A – VENTILATION & A/C

- a) Revise duct sizing and add (4) D2 diffusers. Refer to revised drawing sheet 8.40-2C, ADDM M2, dated 12/10/21.

15) SHEET 8.40-2E – FIRST FLOOR PLAN – AREA E – VENTILATION & A/C

- a) Add Note 11: ***EXPOSED SPIRAL DUCT THRU CORRIDOR SHALL BE DOUBLE WALL CONSTRUCTION.*** Revise locations of EF-220, EF-223 and EF-225. Refer to revised drawing sheet 8.40-2E, ADDM M2, dated 12/10/21.
- b) Omit the fire damper shown at louver LVR-7 at the west side of Mechanical C200; not required.

ELECTRICAL ITEMS:

1) SHEET 9.23-1B – FIRST FLOOR PLAN – AREA B – LIGHTING

- a) Room B100: Provide 4 each 3-way switches (a,b,c,d) at the southeast and southwest entries to the room.

2) SHEET 9.24-1B – FIRST FLOOR PLAN – AREA B – POWER & SIGNAL

- a) Room B103 North Canopy: Provide a weatherproof duplex receptacle above the canopy and provide Raychem FG1-12P heating cable in roof drain pipe. Connect to circuit LB2-40, the circuit breaker shall be GFI type for equipment protection.

3) SHEET 9.26-1C – FIRST FLOOR PLAN – AREA C – POWER & SIGNAL

- a) Room C100: See mechanical addendum for revised location of FP-B101.

4) SHEET 9.34-2B – SECOND FLOOR PLAN – AREA B – LIGHTING

- a) Reference revised electrical drawing 9.34-2B, revision dated 12-10-21, attached to the end of this addendum for lighting modifications in Commons B200.

5) SHEET 9.35-2B – SECOND FLOOR PLAN – AREA B – POWER & SIGNAL

- a) Room B200: Provide a manual motor starter toggle disconnect switch and connection to pump P-23 (120V, 1/12HP) located by AHU-11 (see mechanical addendum for location). Connect to circuit LB1-34.

6) SHEET 9.36-2C – SECOND FLOOR PLAN – AREA C – LIGHTING

- a) Reference revised electrical drawing 9.36-2C, revision dated 12-10-21, attached to the end of this addendum for lighting modifications in Commons B200.

7) SHEET 9.37-2C – SECOND FLOOR PLAN – AREA C – POWER & SIGNAL

- a) Delete the exterior receptacle south of the southwest door.

8) SHEET 9.39-2D – SECOND FLOOR PLAN – AREA D – POWER & SIGNAL

- a) Room D200: Delete the duplex receptacle on the north wall and the associated circuit going to the west.
- b) Room D207A: Delete the duplex receptacle on the south wall. Move the home-run to the receptacle in the hallway to the southeast.

9) SHEET 9.43-3E – PENTHOUSE FLOOR PLAN – AREA E – POWER & SIGNAL

- a) Room E300: Delete the exterior duplex receptacle by the northwest door.
- b) Roof: See mechanical addendum for revised locations of EF-E220, EF-E223, and EF-E225

GENERAL APPROVALS:

The following material or equipment furnished by the manufacturers listed, may be substituted as equivalent providing that each item, material, and piece of equipment conforms to the design and requirement of the specifications.

<u>SECTION</u>	<u>ITEM</u>	<u>MANUFACTURER</u>
033000	Underslab Vapor Retarders	W.R. Meadows; <i>Perminator HP 15</i>
034500	Precast Architectural Concrete	Collins Precast Taracon Precast
042000	Thru-Wall Masonry Flashing	York Flashings; <i>York 304 SS</i>
087100	Power-Assist Door Closers	Stanley Access Tech, LLC; <i>Magic Force Heavy Duty Swing Door Operator</i>
105113	Metal Lockers	Lockers MFG; <i>Heavy-Duty Metal Lockers</i>
116600	Athletic Equipment (Goal Post Assemblies)	Jaypro Sports; <i>FBGP-920</i>
220400	Thermal Expansion Absorber	Armstrong
220600	Infloor Heating System	Infloor
220600	Condenser Water Filtration	Proflux

230800	Relief Hoods	ACME/Twin City Fans
230800	Ductless Split System	Samsung
230800	Dust Collector	AQC, Onida Air Systems
230800	Fabric Duct System	Fabric Air
265110 / 265210	Interior and Exterior Lighting	
	Type A Series	Elite
	Type C, CE	Lithonia, LSI
	Type D Series	Delviro, Lithonia
	Type E Series	Emergency, LSI
	Type F, FE, FG	Delviro, Lithonia, Metalux
	Type F1, F1E, F1G	Delviro, Healthcare, Metalux
	Type H Series	Lithonia, Vantage
	Type J#, J#E, K#, K#E	Finelite, Peerless
	Type L#	Axis, Coronet, Finelite
	Type M Series	Lithonia, LSI
	Type N	Acclaim, NVF, TPR
	Type R Series	Lithonia, Portfolio, Vantage
	Type S	Lithonia, Portfolio, Vantage
	Type T	Lithonia, Portfolio, Vantage
	Type TA	FC, Intrigue, Lumux
	Type VF, VFE	Fail-Safe, L.C. Doane, Lithonia
	Type Y Series	Lithonia, LSI, McGraw- Edison
	Type Z	Lithonia, LSI, Lumark
	Type AA Series	Lithonia, LSI, Lumark

END OF ADDENDUM No. 2

REVISED FORM OF PROPOSAL

PROJECT: **Harrisburg High School – 9th Grade Academy**
 South Cliff Avenue and East 85th Street
 Sioux Falls, South Dakota

TO: **Harrisburg School District #41-2**
 200 Willow Street
 Harrisburg, South Dakota 57032

DATE: _____

The undersigned, having familiarized (itself) (himself) with the local conditions affecting the cost of the Work at the place where the Work is to be done and with the Plans and Specifications and other Contract Documents, and having examined the location of the proposed Work, and having received Addenda Nos. _____, _____, _____, _____, dated __/__/__, __/__/__, __/__/__, __/__/__, and having included their provisions in this proposal, hereby proposes and agrees to perform any and all labor and to provide all materials, tools, and equipment necessary to complete in a workmanlike manner all the work for the **Harrisburg High School – 9th Grade Academy** project, located at the corner of South Cliff Avenue and East 85th Street, in Sioux Falls, SD, all in strict conformance with the plans and specifications prepared by Architecture Incorporated, dated November 19, 2021:

For the following Base Bid:

 _____ (\$ _____)

Alternate No. 1: Add Four (4) Classrooms on the West Side of Area E

(ADD) _____ (\$ _____)

Alternate No. 2: Add Running Track & Track Drainage

(ADD) _____ (\$ _____)

Alternate No. 3: Add Access Road on North Side of Property

(ADD) _____ (\$ _____)

Alternate No. 4: Provide LVT in lieu of Ceramic Floor Tile in Commons B100

(DEDUCT) _____ (\$ _____)

Alternate No. 5A: Tandus Flooring Package

(ADD) _____ (\$ _____)

Alternate No. 5B: Alternative Manufacturer Flooring Package

(ADD) _____ (\$ _____)

Alternate No. 6A: Magnetic Bearing Cooling Tower Package

(ADD) _____ (\$ _____)

Alternate No. 6B: Variable Speed Screw Cooling Tower Package

(ADD) _____ (\$ _____)

Alternate No. 6C: Tri-rotor Cooling Tower Package

(ADD) _____ (\$ _____)

Alternate No. 7A: Siemens Auto Temp. Control / Building Automation System

(ADD) _____ (\$ _____)

Alternate No. 7B: Schneider Electric Auto Temp. Control / Building Automation System

(ADD) _____ (\$ _____)

Alternate No. 7C: Distech Controls Auto Temp. Control / Building Automation System

(ADD) _____ (\$ _____)

The undersigned agrees that his bid may not be withdrawn for a period of 30 days from the time set for opening of bids and that if notified of acceptance of his Proposal within that stated time, or at any time thereafter before the bid is withdrawn, he will within ten (10) days of such notification, execute and deliver an Owner - Contractor Agreement herein specified to be AIA Document A101 and to furnish and deliver the Performance Bond and the Labor and Material Payment Bond, each in an amount equal to 100 percent of the Contract Sum.

The Contractor shall commence work under this Contract after the date of receipt by him of Notice of Award on or near December 20, 2021 and shall substantially complete the project by August 12, 2023. The time stated for completion shall include allowances for inspections, completion of items requiring further attention and final clean-up of premises.

BID SECURITY:

The undersigned has attached to the Proposal the following:

1. Bid Security in the form of _____ and in
the amount of \$ _____ as outlined in the
Invitation to Bid.

In submitting this bid, the undersigned understands that the right is reserved by the Owner to reject any and all bids and to waive all informalities.

BIDDER: _____


BY: _____

TITLE: _____

BUSINESS
ADDRESS: _____

STATE OF
INCORPORATION: _____
(SEAL)


If Bid is by a
Corporation:

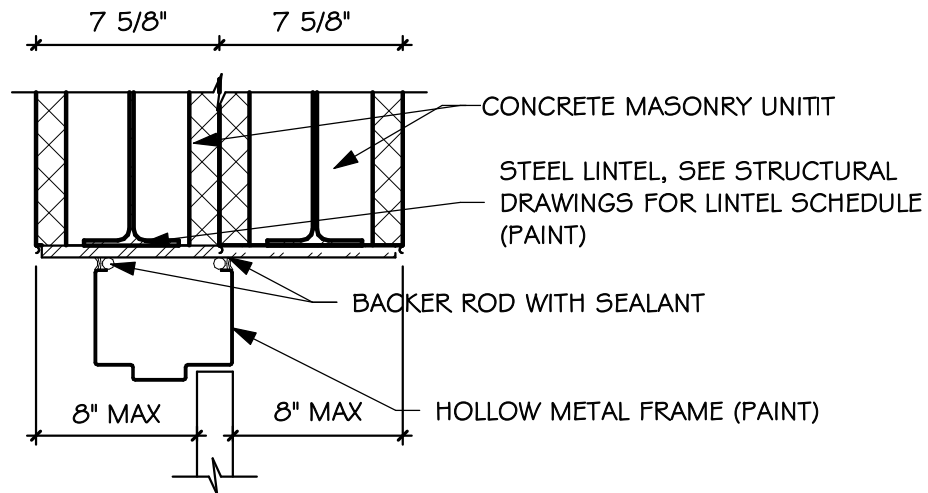

1
SD7

DETAIL 26/4.32


SCALE: 1 1/2" = 1'-0"

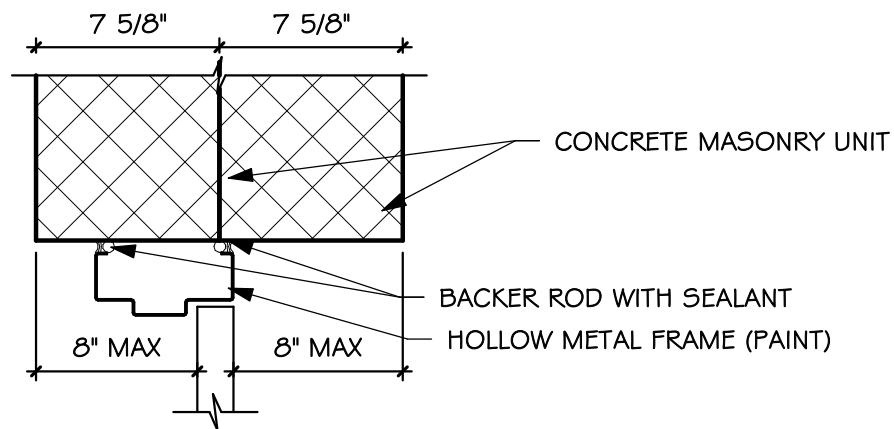

2
SD7

DETAIL 27/4.32

SCALE: 1 1/2" = 1'-0"

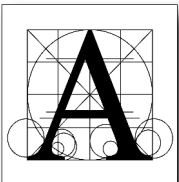

project HARRISBURG HS - 9TH GRADE ACADEMY
 number 1002.2904.20 drawn ZJG checked SRJ
 date 12-10-2021 revision _____

Architecture Incorporated

415 South Main Ave., P.O. Box 2140 Sioux Falls, SD (605) 339-1711

DRAWING

SD7




project HARRISBURG HS - 9TH GRADE ACADEMY
number 1002.2904.20 drawn ZJG checked SRJ
date 12-10-2021 revision _____

Architecture Incorporated
415 South Main Ave., P.O. Box 2140 Sioux Falls, SD (605) 339-1711

DRAWING


SD8

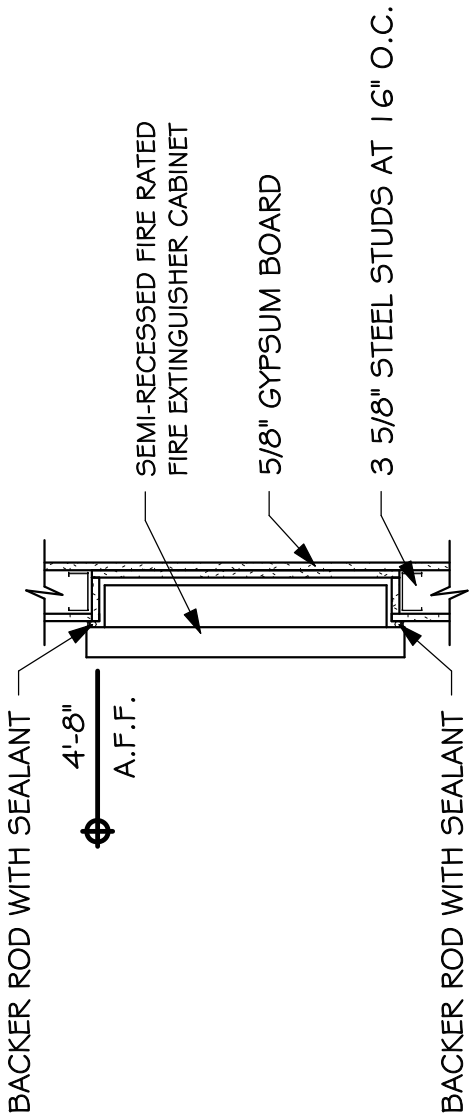

FEC - SEMI RECESSED

SCALE: 3/4" = 1'-0"


1
1.10

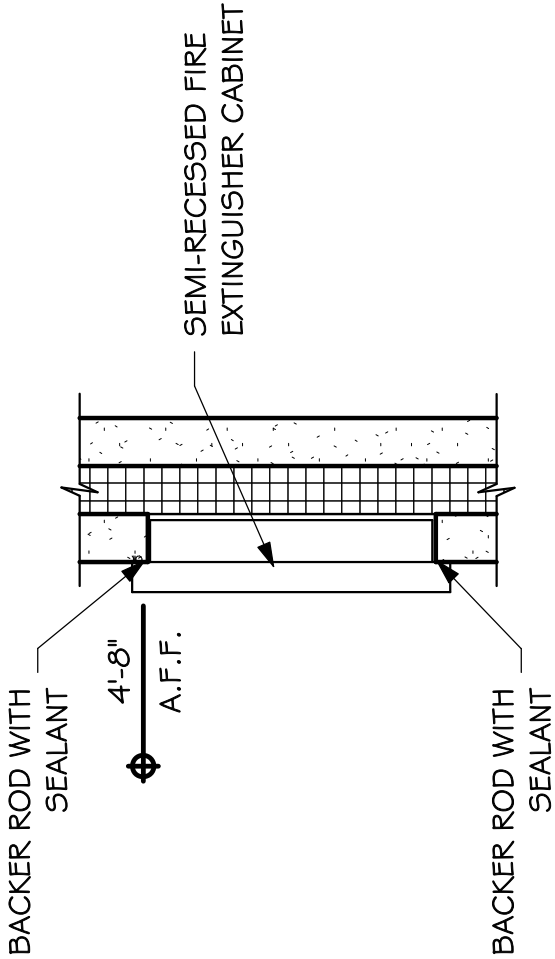

FEC - SEMI RECESSED (PRECAST)

SCALE: 3/4" = 1'-0"


3
1.10

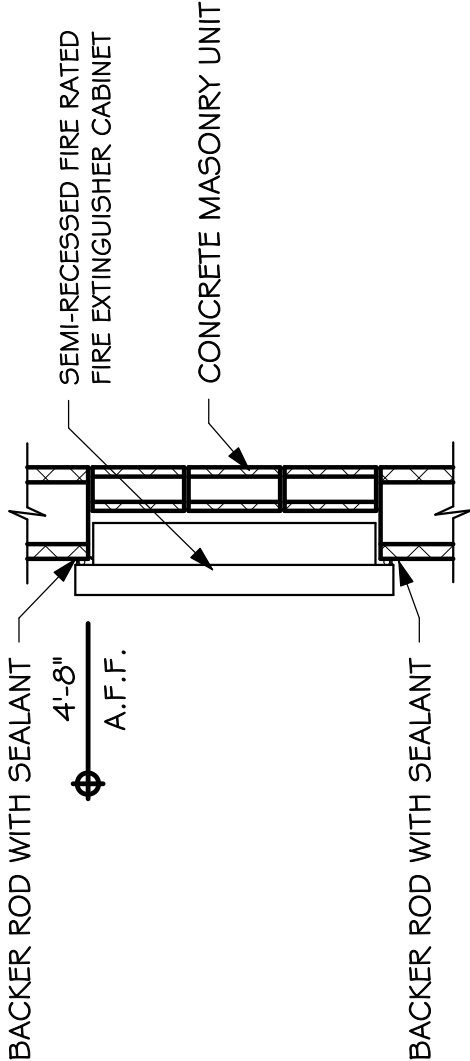

FEC - SEMI RECESSED (CMU)

SCALE: 3/4" = 1'-0"

2
1.10

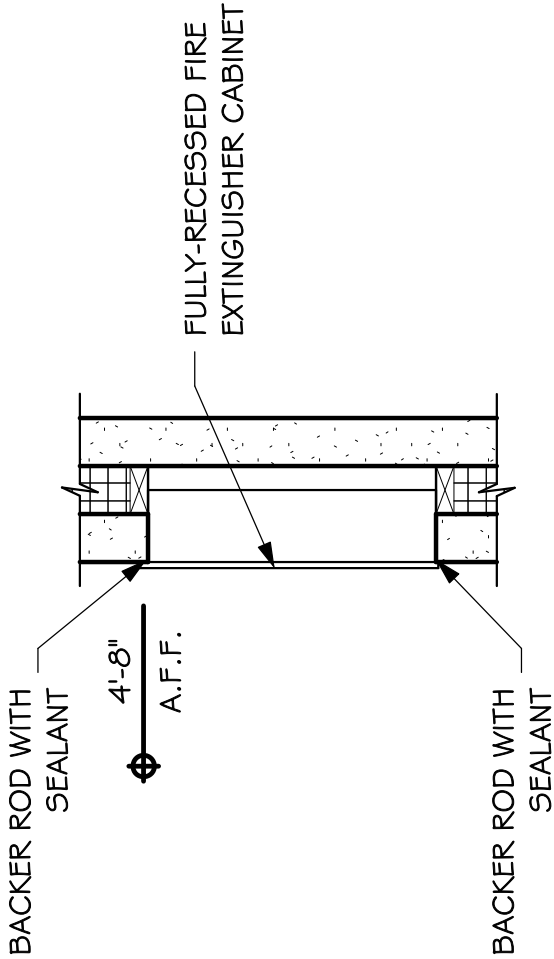

FEC - FULLY RECESSED (PRECAST)

SCALE: 3/4" = 1'-0"

4
1.10

HARRISBURG HS - 9TH GRADE ACADEMY

SECTION DETAILS - Additional


Number 1002.2904.20

NOVEMBER 19, 2021


Date Author checked Checker

DATE	DESCRIPTION

5.57

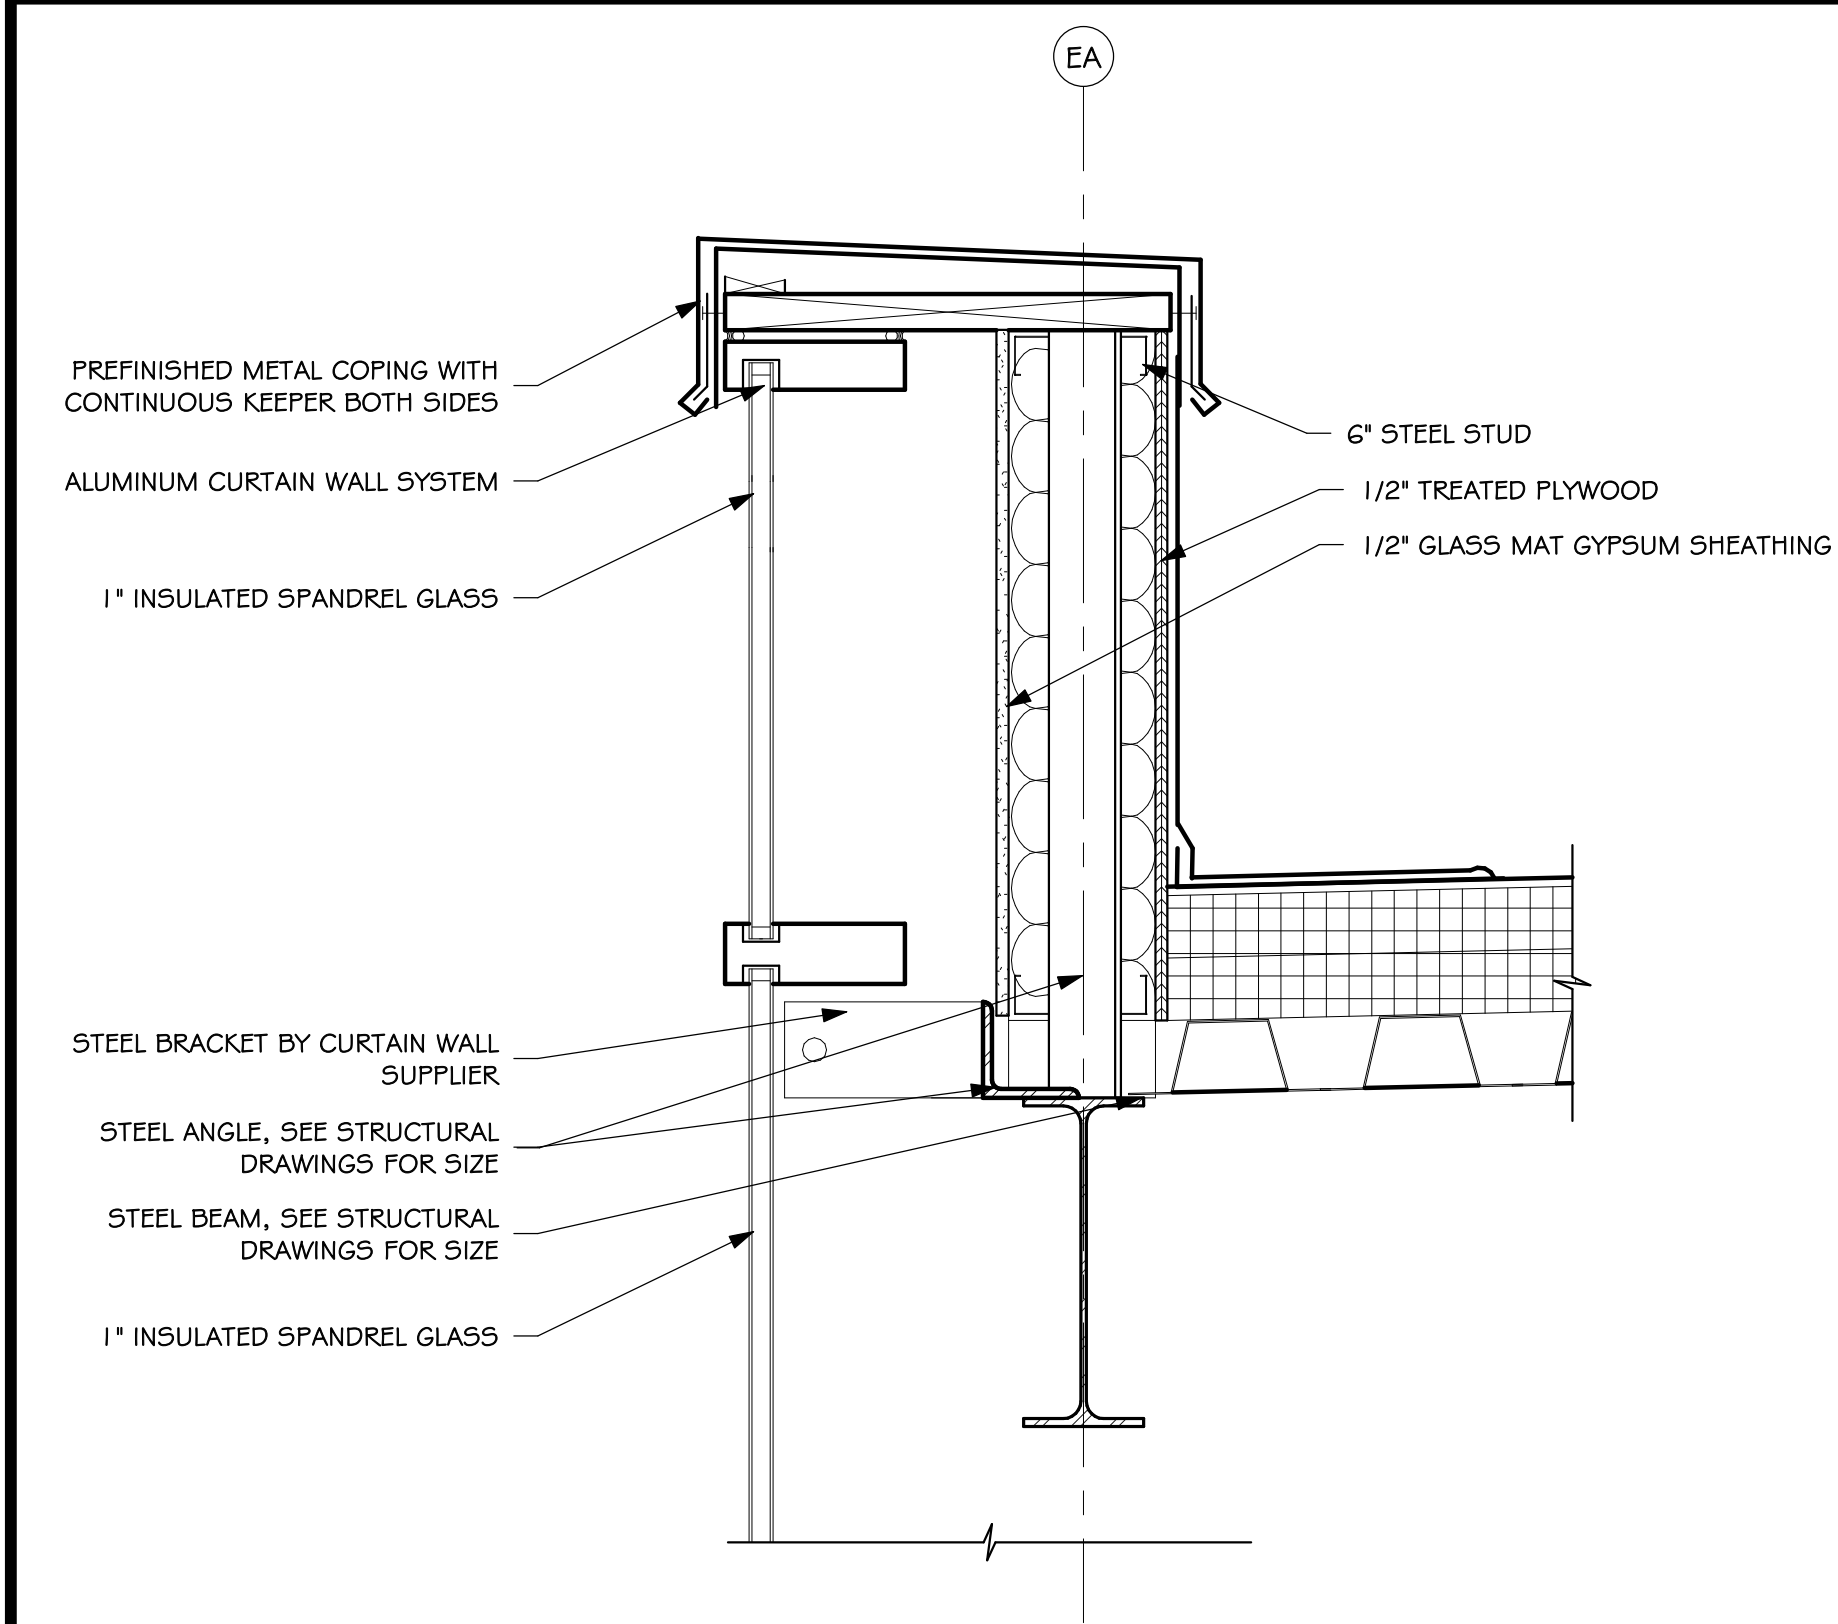



DETAIL
 SCALE: 1 1/2" = 1'-0"

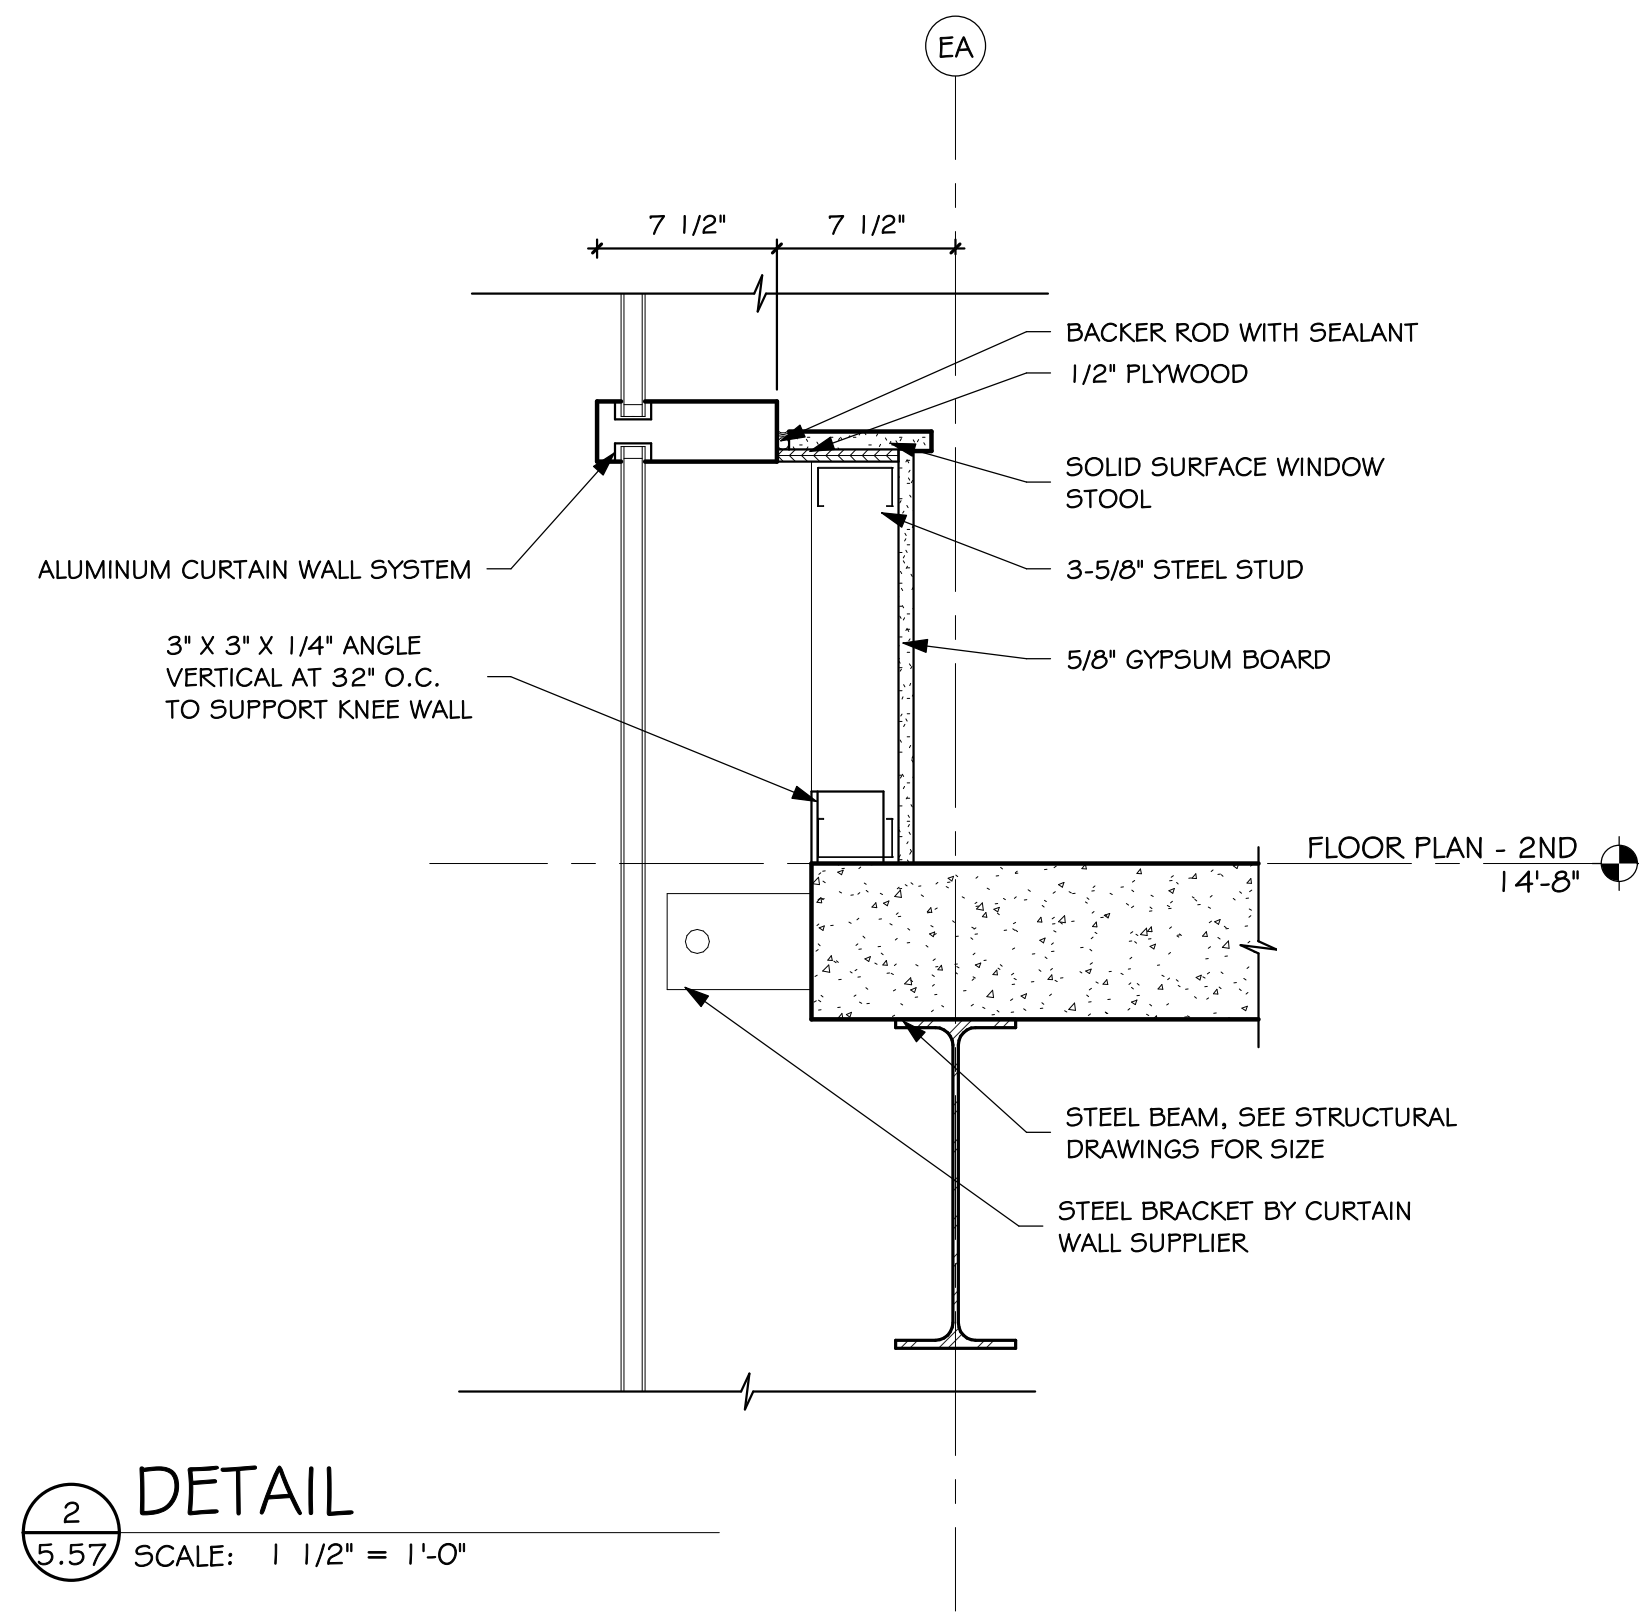


2
5.57

DETAIL

SCALE: 1 1/2" = 1'-0"

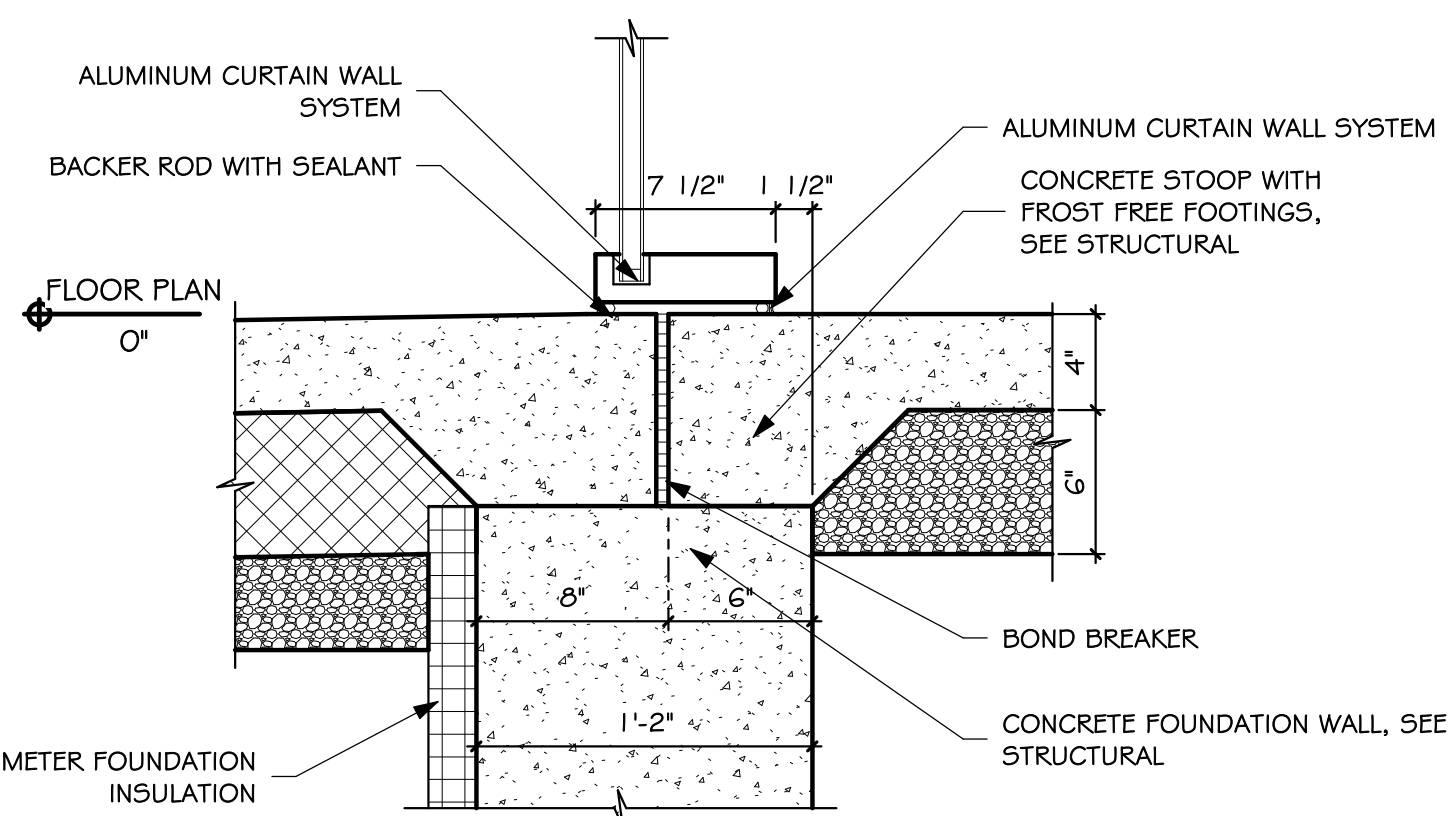


3 CURTAIN WALL SILL
5.57 SCALE: 1 1/2" = 1'-0"

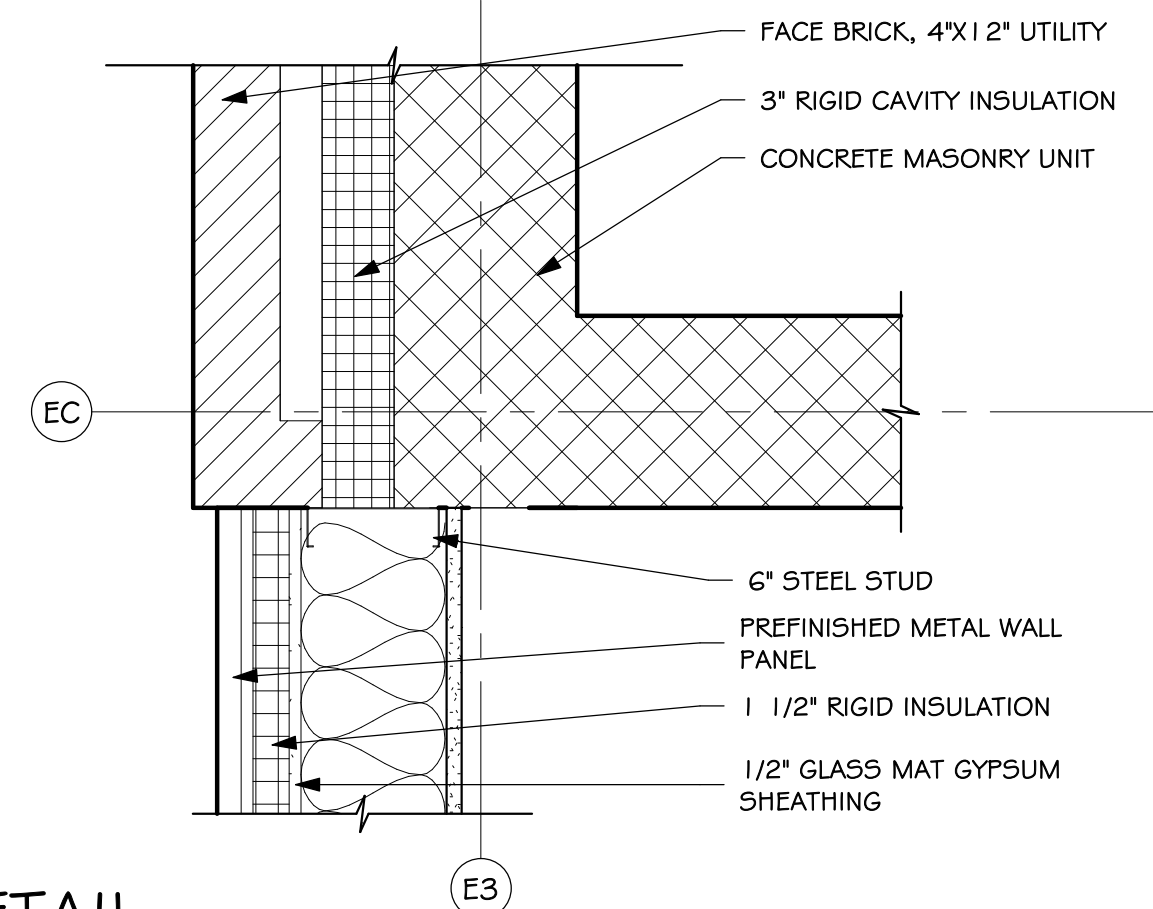

8
5.57

DETAIL


SCALE: 1 1/2" = 1'-0"

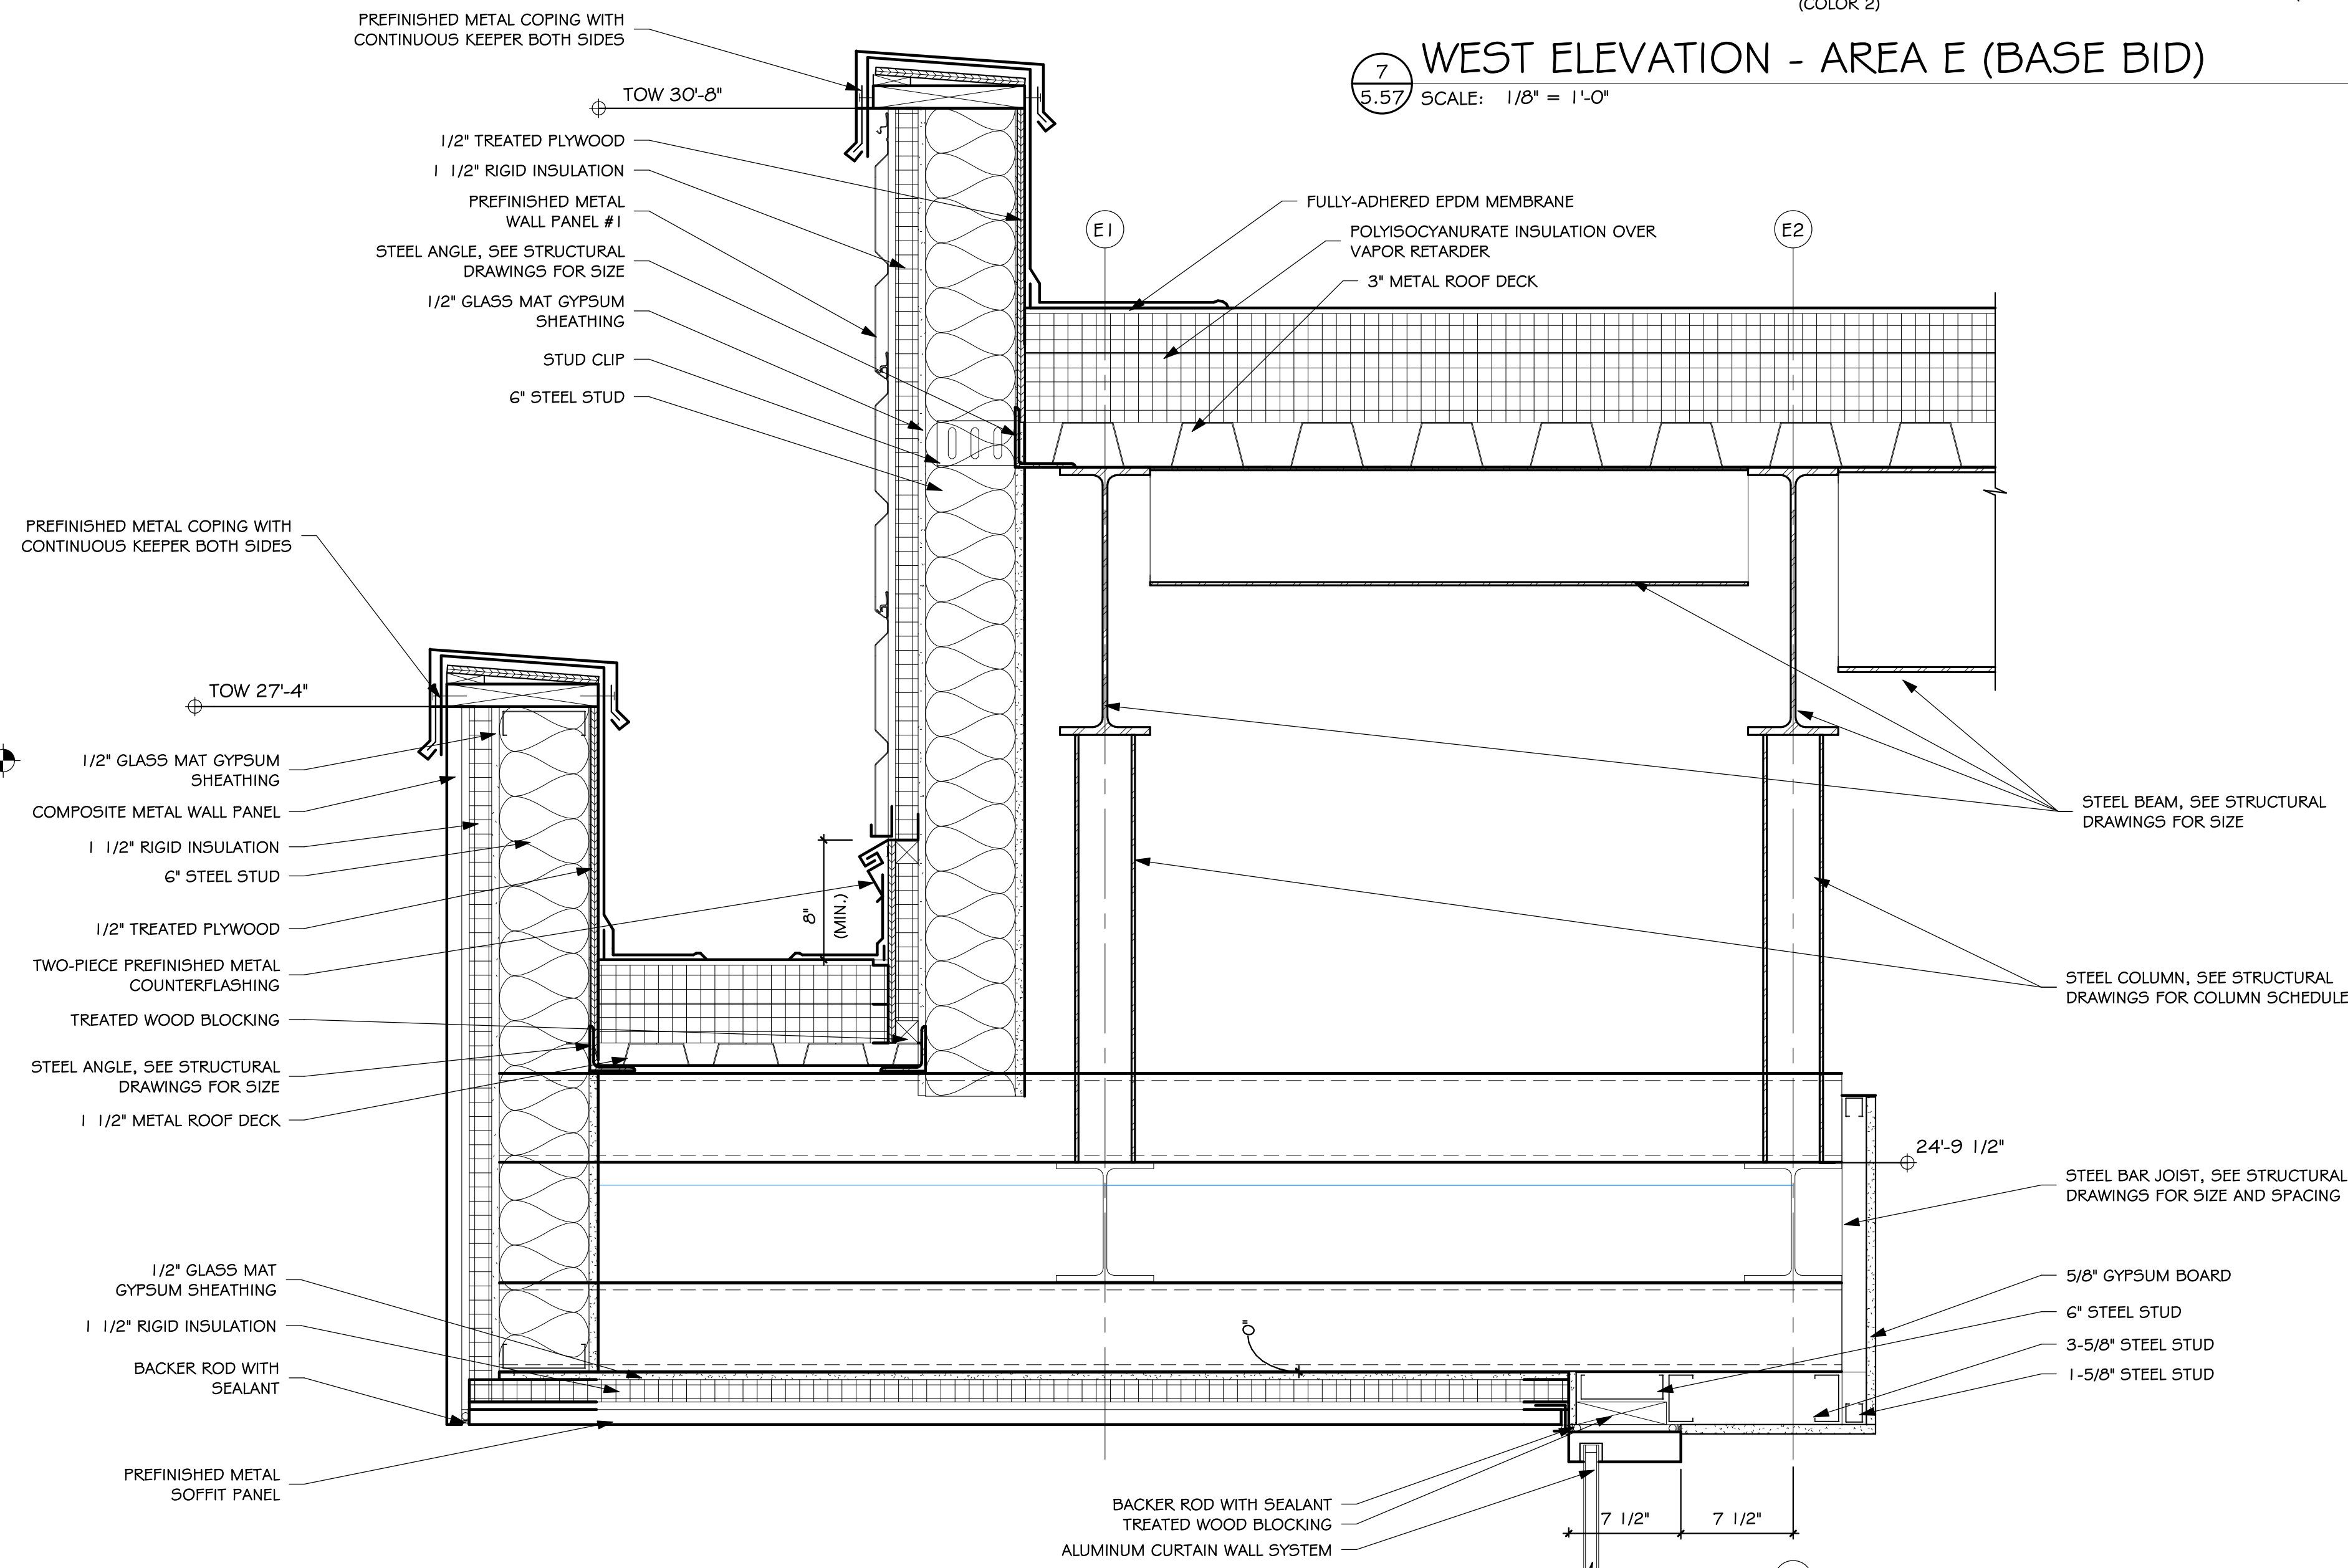


4
5.57

DETAIL - ADD ALT.


SCALE: 1 1/2" = 1'-0"

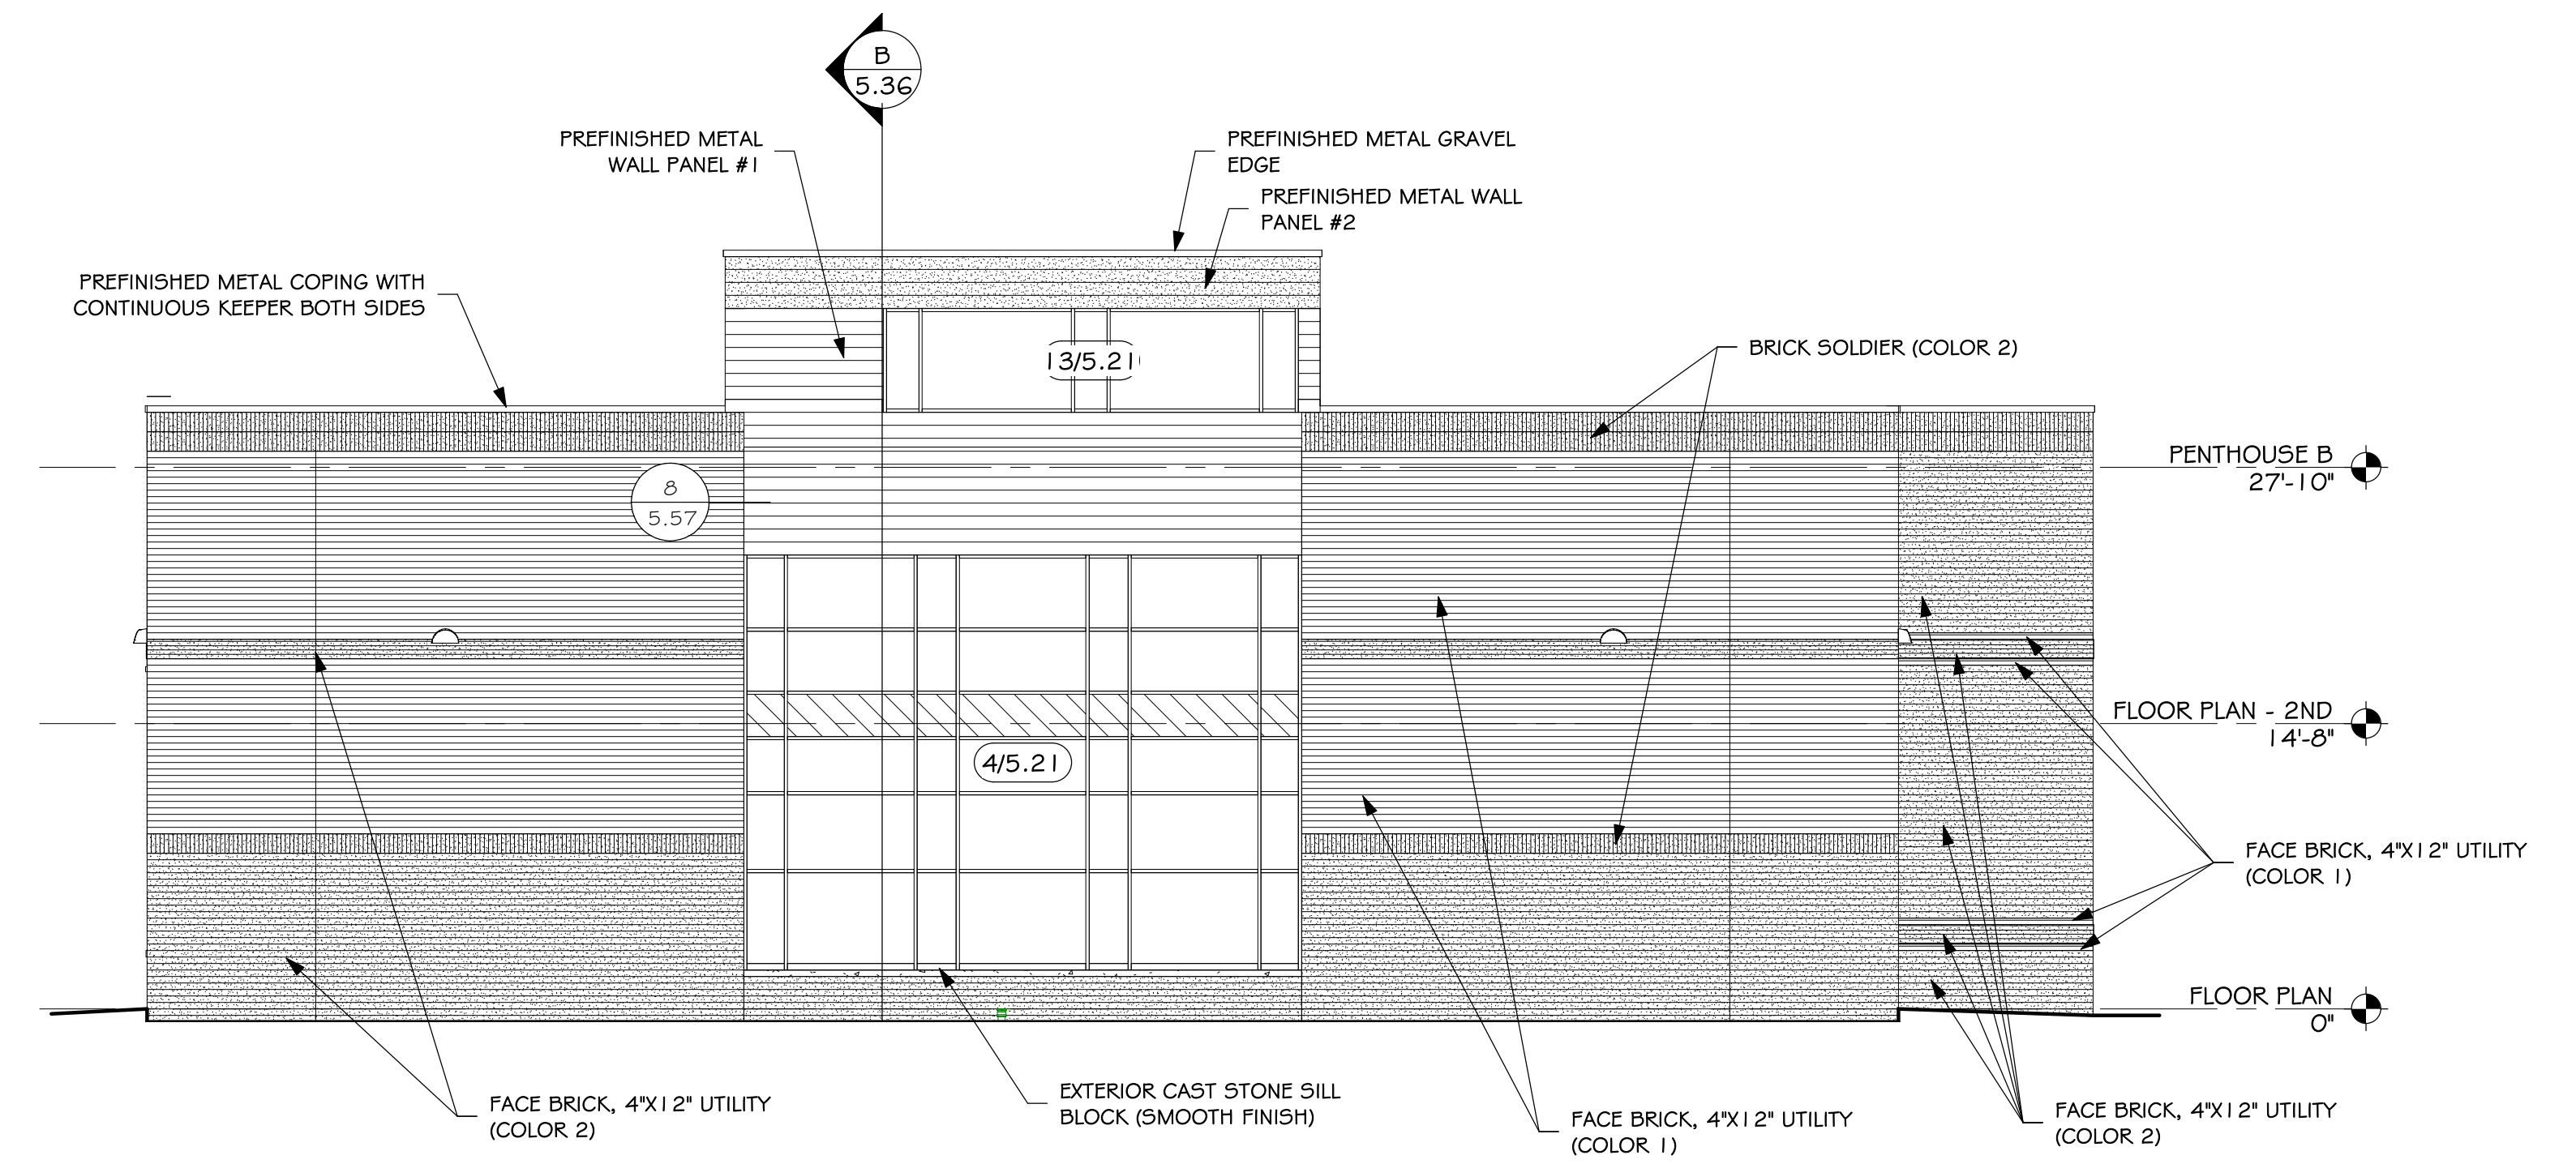

7 WEST ELEVATION - AREA E (BASE BID)
5.57 SCALE: 1/8" = 1'-0"

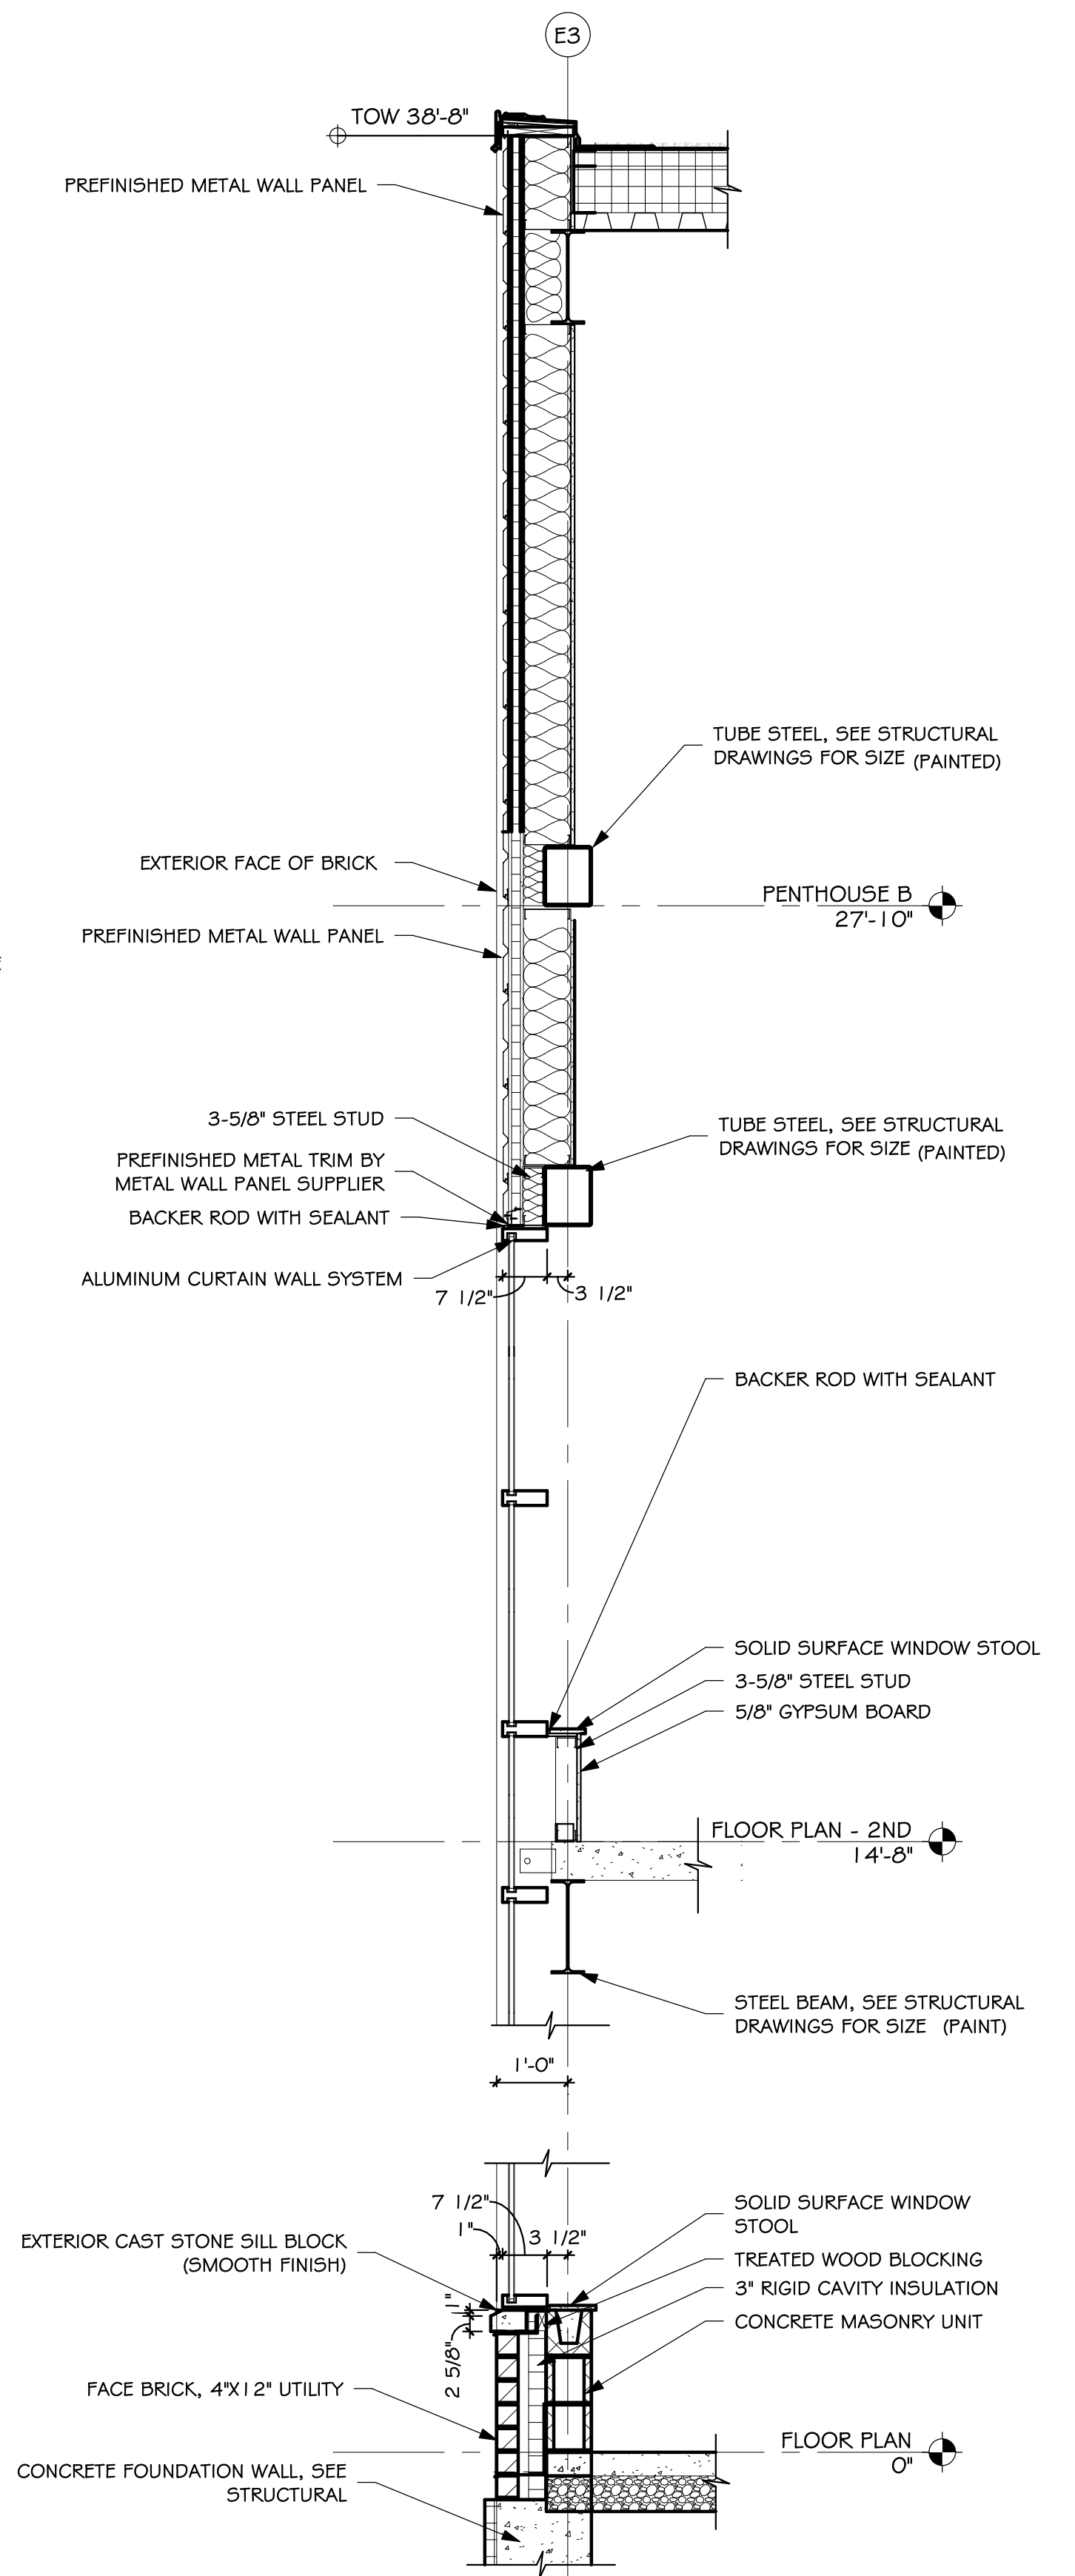


6
5.57 END WALL SECTION - BASE BID
SCALE: 1/2" = 1'-0"

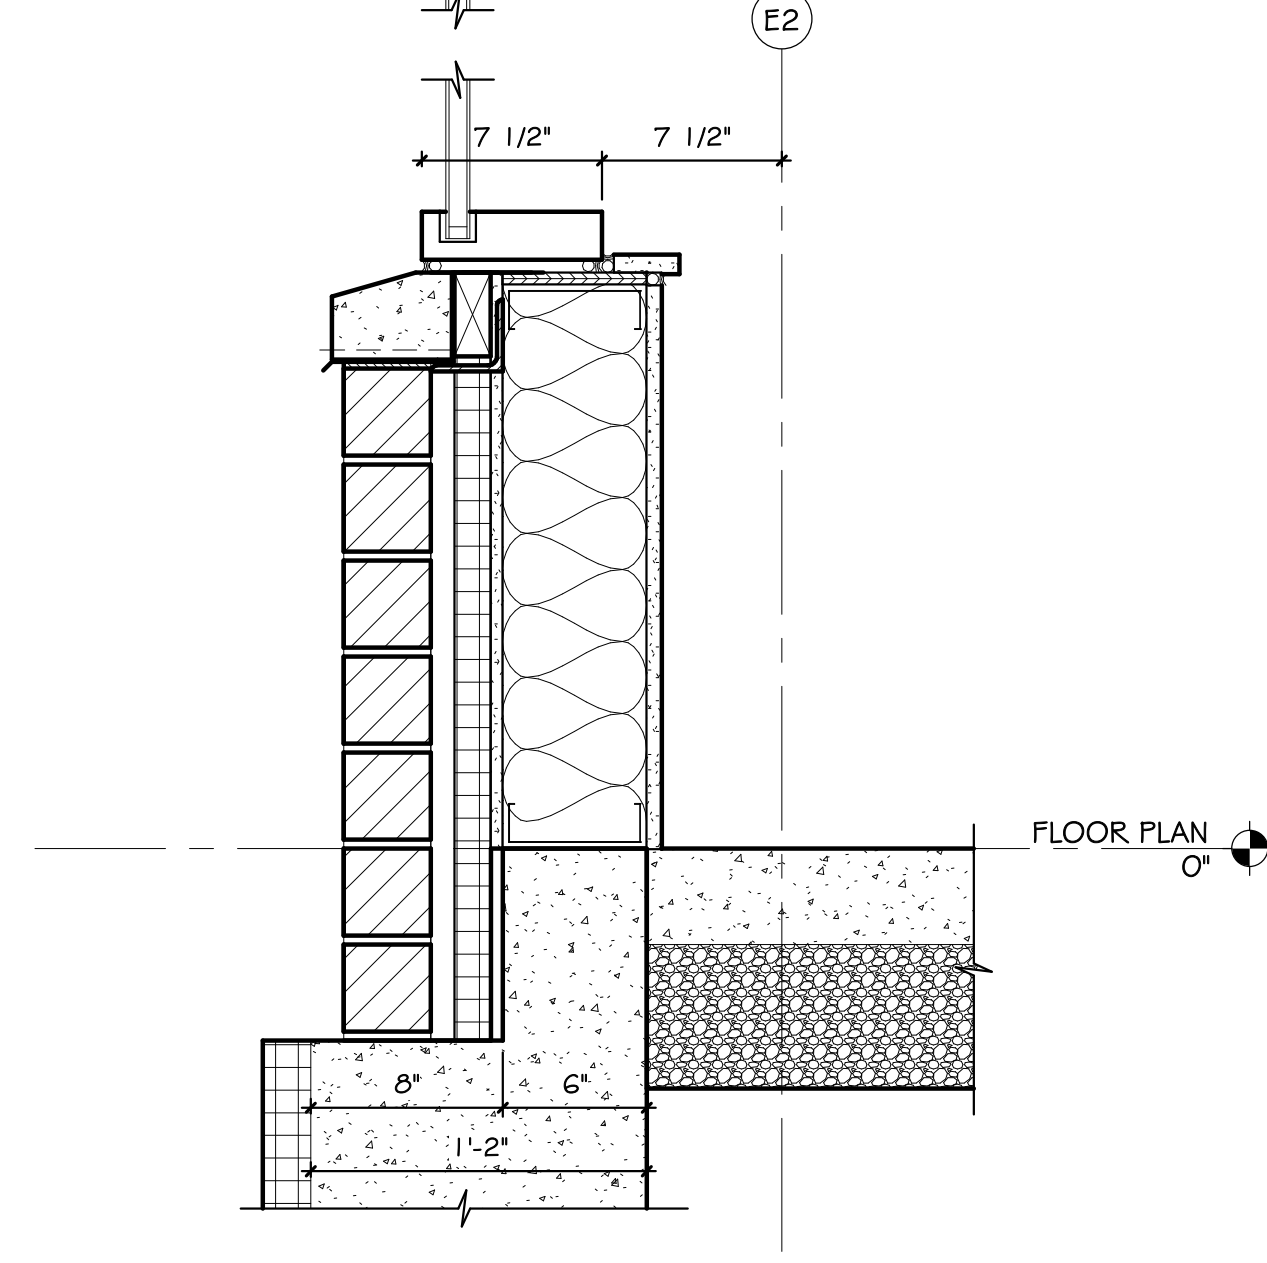


5 CURTAIN WALL SILL - ADD ALT.
5.57 SCALE: 1 1/2" = 1'-0"

12/10/2021 2:17:21 PM

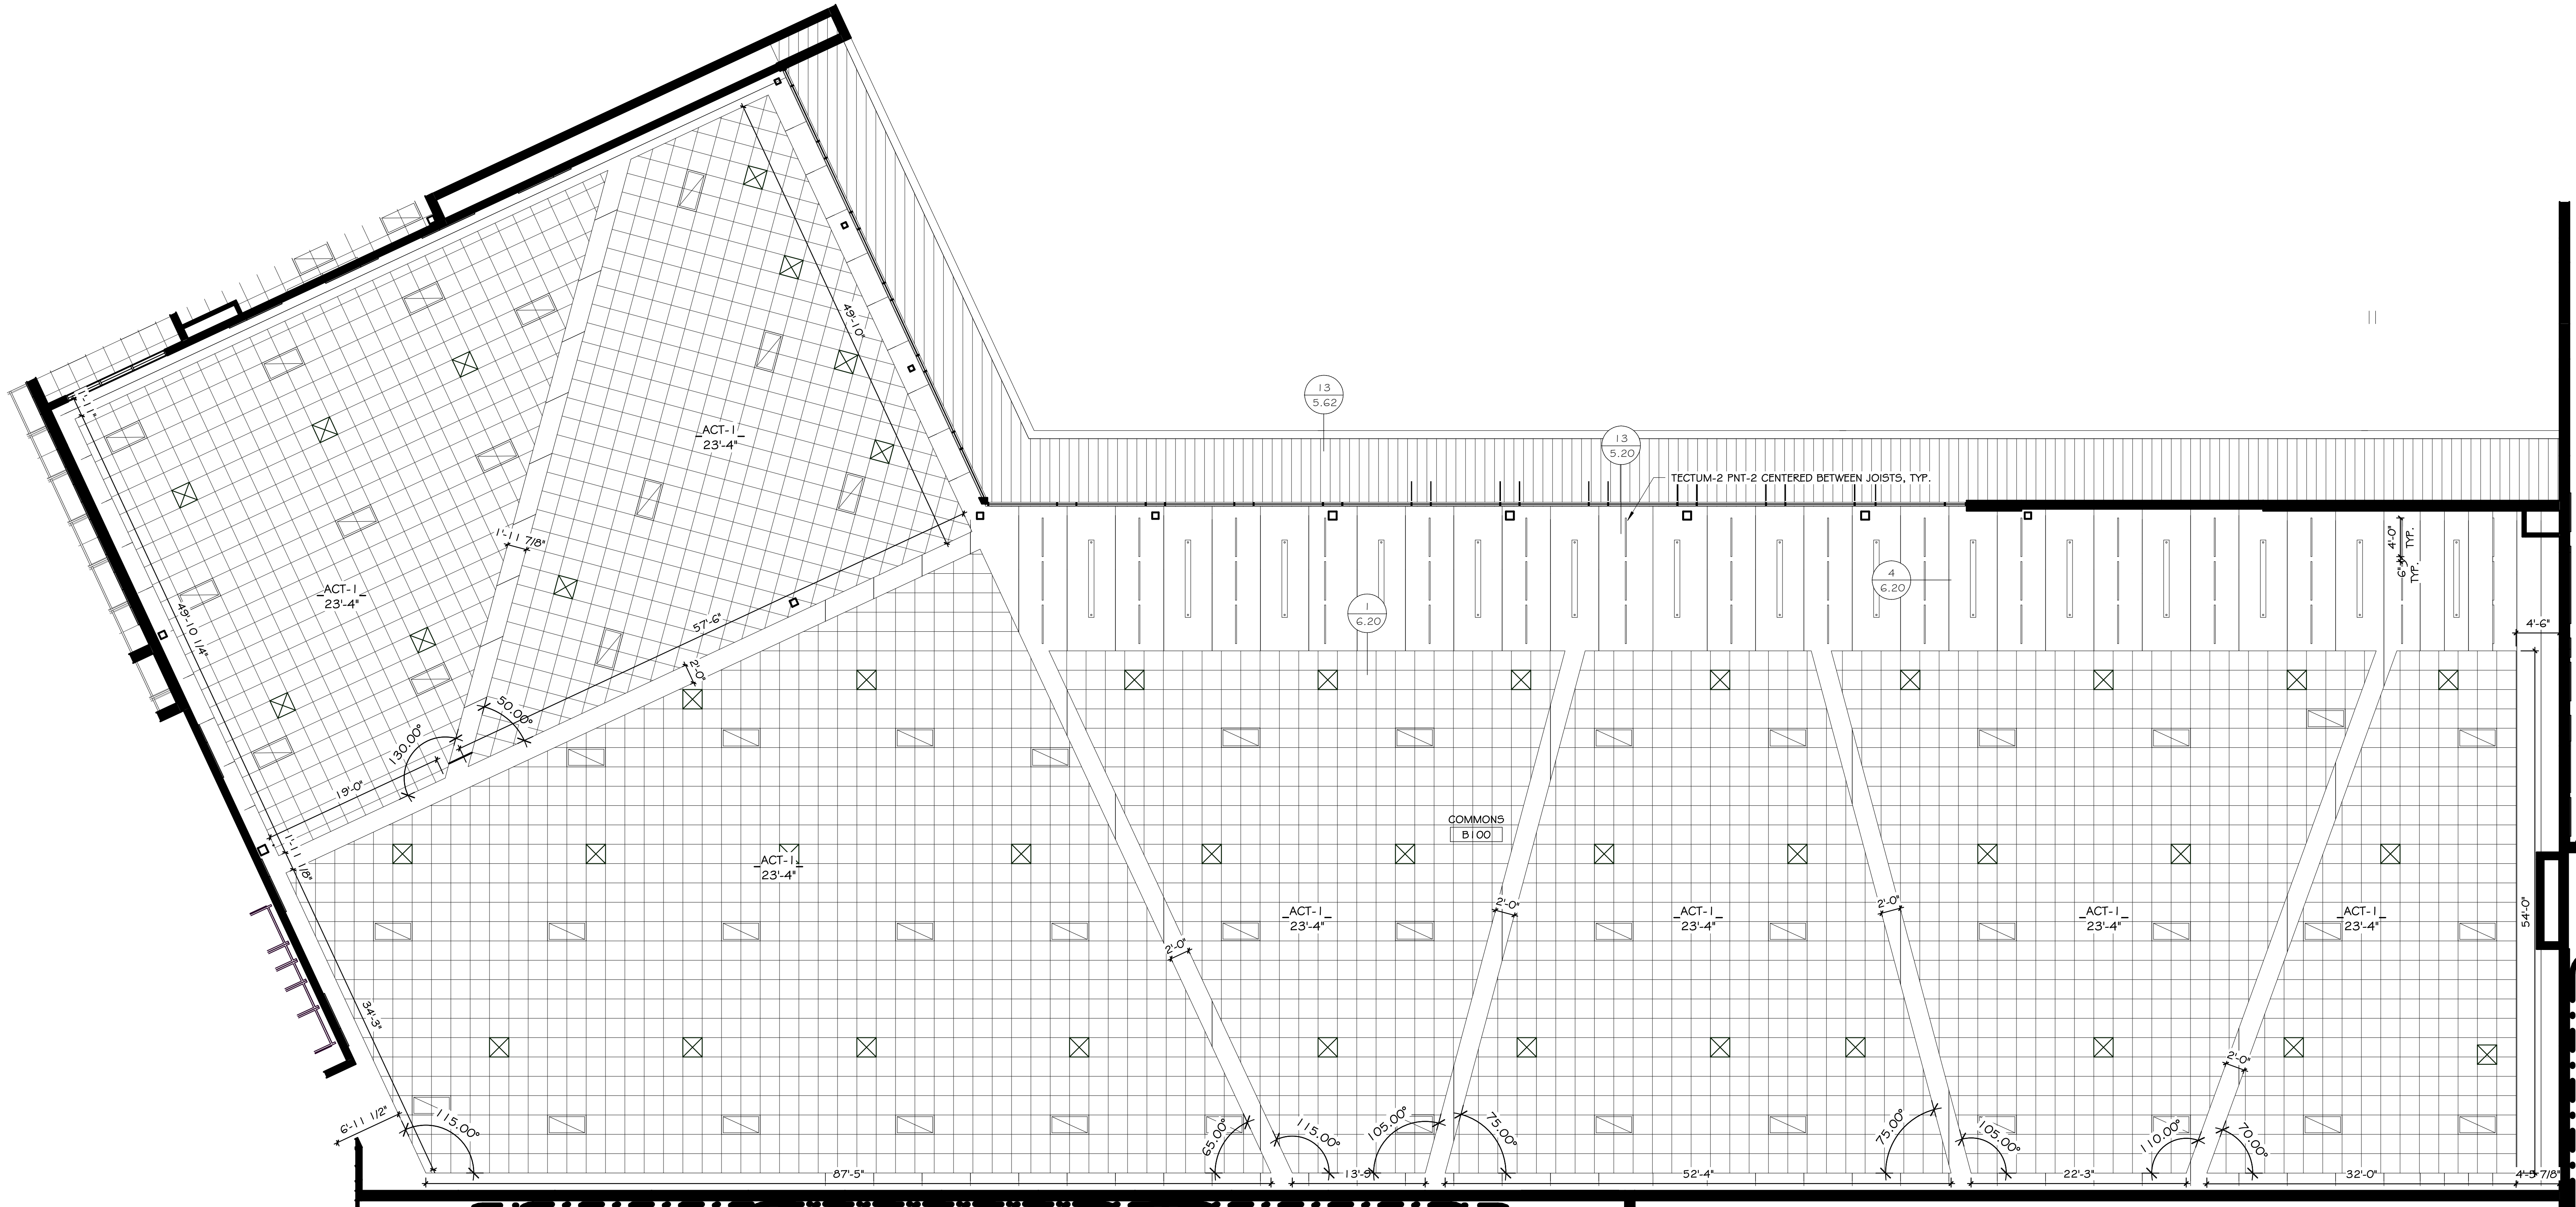


COMMONS HIGH REFLECTED CEILING PLAN


SCALE: 1/8" = 1'-0"

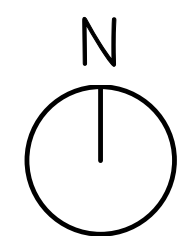

GENERAL NOTES - REFLECTED CEILING PLAN	
A. GENERAL CONTRACTOR SHALL VERIFY DIMENSIONS AND CONDITIONS AT THE JOB SITE AND NOTIFY ARCHITECT OF DISCREPANCIES.	
B. ALL BULKHEAD AND SOFFITS SHALL EXTEND 2 INCHES BELOW ADJACENT CEILING HEIGHT UNLESS NOTED OTHERWISE.	
REFLECTED CEILING PLAN LEGEND	
	RECESSED LIGHT
	SURFACE LIGHT
	RECESSED LIGHT
	SUPPLY GRILLE
	RETURN/EXHAUST GRILLE
	RADIANT HEATING PANEL
	WALL EXTENDED 4' SEALED TO STRUCTURE ABOVE TO PREVENT AIR/SOUND TRANSFER FROM ROOM TO ROOM
	WALL TO ABOVE CEILING
	SPEAKER

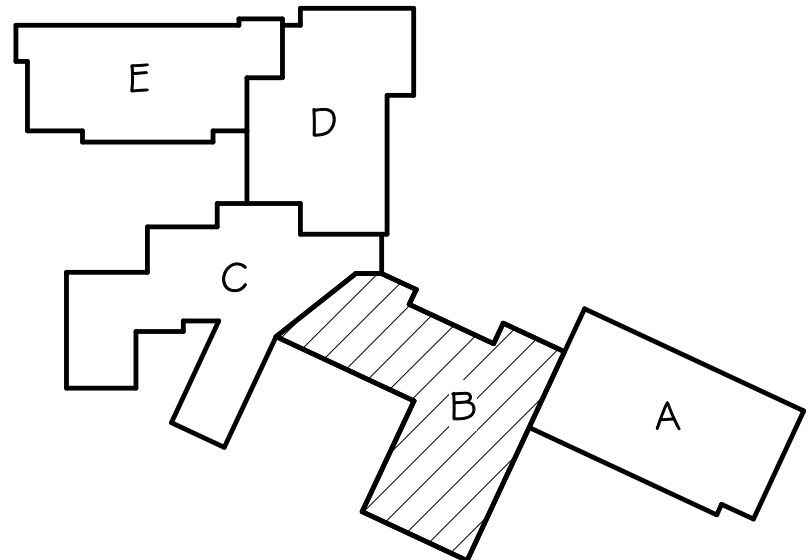

KEYPLAN

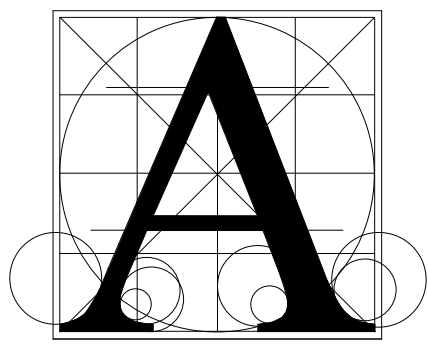

Architecture Incorporated

415 South Main Avenue
P.O. Box 2140
Sioux Falls, South Dakota 57101
Phone: (605) 339-1711

815 St Joseph Street, Suite 203
P.O. Box 8047
Rapid City, South Dakota 57701
Phone: (605) 721-1158






HARRISBURG HS - 9TH GRADE ACADEMY FIRST FLOOR REFLECTED CEILING PLAN - COMMONS

number	1002.2904.20	
date	NOVEMBER 19, 2021	
revision		
drawn	BJO	checked SRJ


NO.	DATE	DESCRIPTION
	12-10-21	ref: Addendum #2

6.10-2B

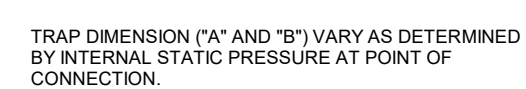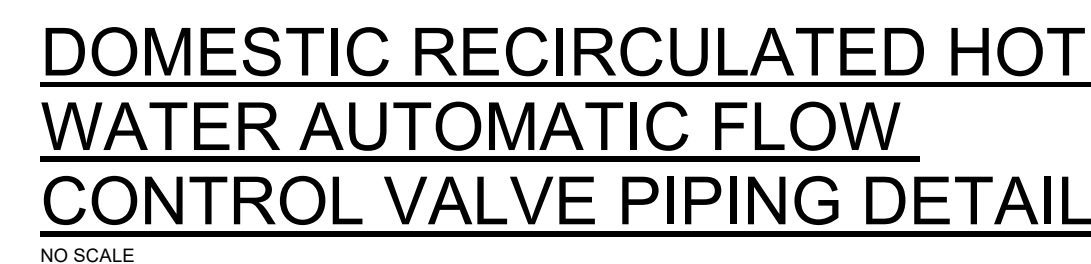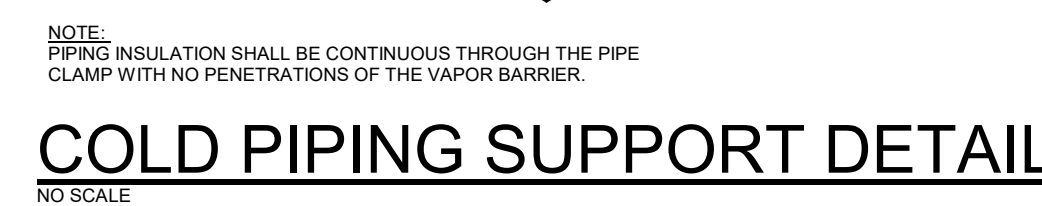

415 South Main Avenue
P.O. Box 2140
Sioux Falls, South Dakota 57101
Phone: (605) 339-1711

815 St Joseph Street, Suite 203
P.O. Box 8047
Rapid City, South Dakota 57701
Phone: (605) 721-1158

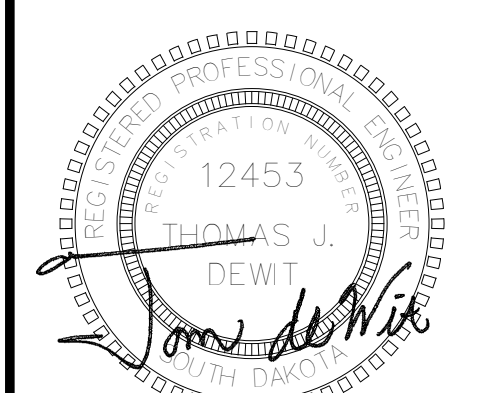

Associated
Consulting
Engineering,
Incorporated

340 S. Phillips Ave.
Sioux Falls, SD 57104
(605) 335-3720
Fax 335-6220
E-mail acei@aceinet.com
ACEI PROJ. #120085

ACEI PROJ. #120085

project

HARRISBURG HS - 9TH GRADE ACADEMY

DETAILS

number 1002.2904.20
date 11-19-21
revision
drawn DK/DM checked Td

NO.	DATE	DESCRIPTION
1	12-10-21	ADD M2

8.11

AIR HANDLING UNIT SCHEDULE

UNIT NO.	MANUF.	MODEL NO.	CFM	MIN O/A CFM	ESP	TSP	FAN HP	BHP	ELEC VOLTS	PH	FAN TYPE/SIZE	COOLING COIL CAPACITY								HEATING COIL CAPACITY								FILTER TYPE	AREA(SF)	MAX FV	APD	THICK	OPER. WT(LBS)	REMARKS				
												MBH	EAT	LAT	FV	APD	EWT	LWT	GPM	WPD	MBH	EAT	LAT	FV	APD	EWT	LWT								GPM	WPD		
AHU-1	DAIKIN	CAH03GDDG	6,500	1,350	2.5	4.5	7.5	1.67	460	3	DD, PLENUM / 20"	1670	241.8	81.666.3	54.353.8	500	0.77	44	56	37	10	55.1	5.2	300	0.55	2	2,500	1,2,3,4										
AHU-2	DAIKIN	CAH03GDDG	9,400	3,780	1.5	3.7	10	7.6	460	3	DD, PLENUM / 22"	1375	265.5	82.167.0	54.353.8	500	0.80	44	56	65	16	56.1	5.2	300	0.55	2	3,045	1,2,3,4										
AHU-3	DAIKIN	CAH03GDDG	10,000	3,600	1.5	3.5	10	7.7	460	3	DD, PLENUM / 22"	1380	311.2	97.189.8	54.353.8	500	0.80	44	56	89	6	100.4	5.6	300	0.53	2	5,000	1,2,3,4										
AHU-4	DAIKIN	CAH03GDDG	6,300	800	1.5	3.4	7.5	4.8	460	3	DD, PLENUM / 22.25"	1630	184.1	76.753.6	54.353.8	500	0.80	44	56	26	6	215.1	65.0	28	500	0.3	160	130	16	5	MERV 8	20.2	300	0.56	2	2,850	1,2,3,4	
AHU-5	DAIKIN	CAH03GDDG	2,500	1,100	1.5	3.7	3	2.3	460	3	DD, PLENUM / 14"	2895	105.1	82.367.3	54.353.8	500	1.00	44	56	19	7	190.1	31.0	105	500	0.3	160	130	14	9	MERV 8	13.9	300	0.53	2	1,800	1,2,3,4	
AHU-6	DAIKIN	CAH03GDDG	17,100	6,410	2.5	4.5	15(X2)	8.5(X2)	460	3	DD, PLENUM / 24.5"	1675	680.1	81.666.7	54.353.8	500	0.80	44	56	98	8	525.1	37.0	65	500	0.2	160	130	35	9	MERV 8	62.9	300	0.55	2	6,640	1,2,3,4,5	
AHU-7	DAIKIN	CAH03GDDG	7,700	1,350	2.5	4.6	10	7.9	460	3	DD, PLENUM / 24.5"	1641	248.1	78.164.5	54.353.8	500	0.90	44	56	44	9	122.1	50.0	65	500	0.2	160	130	9	5	MERV 8	34.1	300	0.54	2	3,260	1,2,3,4	
AHU-8	DAIKIN	CAH03GDDG	19,700	6,840	2.5	4.6	15(X2)	10.2(X2)	460	3	DD, PLENUM / 24.5"	1780	760.1	81.166.4	54.353.8	500	0.90	44	56	134	12	550.1	40.0	65	500	0.2	160	130	38	14	MERV 8	65.5	300	0.56	2	7,200	1,2,3,4,5	
AHU-9	DAIKIN	CAH03GDDG	29,800	10,210	2.5	4.6	20(X2)	15.6(X2)	460	3	DD, PLENUM / 30"	1475	1,150.1	81.066.3	54.353.8	500	0.90	44	56	200	12	813.6	40.0	65	500	0.2	160	130	57	6	MERV 8	104.1	300	0.55	2	10,300	1,2,3,4,5	
AHU-10	DAIKIN	CAH03GDDG	4,250	1,960	1.5	3.7	5	3.5	460	3	DD, PLENUM / 18.25"	2050	183.5	83.367.6	54.353.8	500	1.0	44	56	32	7	270.1	26.0	85	500	0.3	160	130	19	5	MERV 8	17.6	300	0.54	2	2,450	1,2,3,4	
AHU-11	DAIKIN	LAH01SA	6,000	---	0.75	1.17	7.5	2.45	460	3	DD, PLENUM / 20"	1670	---	---	---	---	---	---	---	---	---	---	376.6	25.0	85.5	500	0.2	160	130	22	2	MERV 8	16.9	300	0.22	2	900	1,2,3,4

REMARKS:

- HEATING AND COOLING COIL CAPACITIES ARE BASED ON 70% WATER/30% PROPYLENE GLYCOL.
- DIRECT DRIVE PLENUM FAN CONTROLLED BY VFD.
- ESP INCLUDES AN ALLOWANCE OF 0.5" FOR DIRTY FILTERS.
- ACCESS SHALL BE PROVIDED INTO THE FILTER SECTION, BLENDER SECTION, BETWEEN THE HEATING AND COOLING COILS AND FAN SECTION. PROVIDE 18 INCH (MIN.) DOORS AND 18 INCH (MIN.) SPACE BETWEEN COILS. PROVIDE HEAVY DUTY 18 GAUGE STAINLESS STEEL DRAIN PANS FOR COMPLETE DRAINAGE AND WALKING TRAFFIC.
- AIR HANDLER MANUFACTURER SHALL PROVIDE AND MOUNT CONDUIT AND WIRING FROM EACH FAN TERMINATED AT AN EXTERNAL JUNCTION BOX. TO CONTRACTOR TO PROVIDE AND INSTALL A SINGULAR VFD FOR DUAL FAN ARRANGEMENT CONTROL.

FAN POWERED VAV TERMINAL SCHEDULE

UNIT NO.	MANUF.	MODEL NO.	INLET SIZE	CFM	MIN CFM	TERM. S.P.	EXT. S.P.	RAD NC	DISCH NC	MOTOR HP	MOTOR VOLT	PH	FLA	EAT	MBH	GPM	WPD	EWT	LWT	REMARKS
FP-B101	PRICE	FDVLP	10	990	300	0.25"	0.5"	29	26	1/2	277	1	2.9	64	28.8	2.0	5	160	130	1,2,3,4,5,6
FP-C100	PRICE	FDVLP	10	1400	420	0.25"	0.5"	33	34	1/2	277	1	2.9	64	49.7	4.4	5	160	130	1,2,3,4,5,6
FP-C105	PRICE	FDV	12	1130	340	0.25"	0.5"	33	34	1/2	277	1	4.0	64	46.5	3.2	5	160	130	1,2,3,4,5
FP-C109	PRICE	FDV	16	1730	520	0.25"	0.5"	40	35	1	277	1	5.9	64	59.8	4.2	5	160	130	1,2,3,4,5
FP-C116A	PRICE	FDV	14	1700	510	0.25"	0.5"	33	39	1	277	1	5.9	64	29.3	2.0	5	160	130	1,2,3,4,5
FP-C116B	PRICE	FDV	14	1700	510	0.25"	0.5"	33	39	1	277	1	5.9	64	29.3	2.0	5	160	130	1,2,3,4,5
FP-C120	PRICE	FDV	10	880	270	0.25"	0.5"	29	26	1/2	277	1	4.0	64	21.5	1.5	5	160	130	1,2,3,4,5
FP-C126	PRICE	FDV	16	2740	830	0.25"	0.5"	40	35	1	277	1	5.9	64	110.9	7.7	5	160	130	1,2,3,4,5
FP-C127	PRICE	FDV	12	1170	360	0.25"	0.5"	33	34	1/2	277	1	4.0	64	52.9	3.7	5	160	130	1,2,3,4,5
FP-D137A	PRICE	FDV	16	1930	580	0.25"	0.5"	40	35	1	277	1	5.9	64	57.4	4.0	5	160	130	1,2,3,4,5
FP-D137B	PRICE	FDV	16	1930	580	0.25"	0.5"	40	35	1	277	1	5.9	64	57.4	4.0	5	160	130	1,2,3,4,5
FP-D137C	PRICE	FDV	16	1930	580	0.25"	0.5"	40	35	1	277	1	5.9	64	57.4	4.0	5	160	130	1,2,3,4,5
FP-D137D	PRICE	FDV	16	1930	580	0.25"	0.5"	40	35	1	277	1	5.9	64	57.4	4.0	5	160	130	1,2,3,4,5
FP-D138	PRICE	FDV	14	1690	510	0.25"	0.5"	33	39	1/2	277	1	4.0	64	39.9	2.8	5	160	130	1,2,3,4,5
FP-D141	PRICE	FDV	10	825	250	0.25"	0.5"	29	26	1/2	277	1	4.0	64	20.1	1.4	5	160	130	1,2,3,4,5
FP-D142	PRICE	FDV	12	1285	390	0.25"	0.5"	33	34	1/2	277	1	4.0	64	34.2	2.4	5	160	130	1,2,3,4,5
FP-D143	PRICE	FDV	6	260	80	0.25"	0.5"	25	20	1/3	277	1	2.1	64	7.4	0.5	5	160	130	1,2,3,4,5
FP-D200	PRICE	FDV	12	1340	410	0.25"	0.5"	33	34	1/2	277	1	4.0	64	29.2	2.0	5	160	130	1,2,3,4,5
FP-D201	PRICE	FDV	8	680	210	0.25"	0.5"	28	22	1/3	277	1	2.1	64	17.0	1.2	5	160	130	1,2,3,4,5
FP-D205	PRICE	FDV	8	670	210	0.25"	0.5"	28	22	1/3	277	1	2.1	64	17.0	1.2	5	160	130	1,2,3,4,5
FP-D208	PRICE	FDV	12	1165	350	0.25"	0.5"	29	26	1/2	277	1	4.0	64	40.5	2.8	5	160	130	1,2,3,4,5
FP-D210	PRICE	FDV	10	750	230	0.25"	0.5"	33	34	1/2	277	1	4.0	64	18.4	1.3	5	160	130	1,2,3,4,5
FP-D211	PRICE	FDV	12	1370	420	0.25"	0.5"	33	34	1/2	277	1	4.0	64	29.7	2.1	5	160	130	1,2,3,4,5
FP-D212	PRICE	FDV	10	865	260	0.25"	0.5"	29	26	1/2	277	1	4.0	64	20.5	1.4	5	160	130	1,2,3,4,5
FP-D213	PRICE	FDV	10	750	230	0.25"	0.5"	29	26	1/2	277	1	4.0	64	18.6	1.4	5	160	130	1,2,3,4,5
FP-E106	PRICE	FDV	8	665	200	0.25"	0.5"	28	22	1/3	277	1	2.1	64	18.6	1.3	5	160	130	1,2,3,4,5
FP-E109	PRICE	FDV	8	665	200	0.25"	0.5"	28	22	1/3	277	1	2.1	64	18.6	1.3	5	160	130	1,2,3,4,5
FP-E110	PRICE	FDV	8	665	200	0.25"	0.5"	28	22	1/3	277	1	2.1	64	18.6	1.3	5	160	130	1,2,3,4,5
FP-E111	PRICE	FDV	8	665	200	0.25"	0.5"	28	22	1/3	277	1	2.1	64	18.6	1.3	5	160	130	1,2,3,4,5
FP-E112	PRICE	FDV	10	745	230	0.25"	0.5"	29	26	1/2	277	1	4.0	64	22.7	1.6	5	160	130	1,2,3,4,5
FP-E114	PRICE	FDV	10	830	250	0.25"	0.5"	29	26	1/2	277	1	4.0	64	31.1	2.2	5	160	130	1,2,3,4,5
FP-E115A	PRICE	FDV	14	1990	600	0.25"	0.5"	33	39	1	277	1	5.9	64	44.4	3.1	5	160	130	1,2,3,4,5
FP-E115B	PRICE	FDV	14	1790	540	0.25"	0.5"	33	39	1	277	1	5.9	64	31.2	2.2	5	160	130	1,2,3,4,5
FP-E115C	PRICE	FDV	14	1790	540	0.25"	0.5"	33	39	1	277	1	5.9	64	31.2	2.2	5	160	130	1,2,3,4,5
FP-E118	PRICE	FDV	10	950	290	0.25"	0.5"	29	26	1/2	277	1	4.0	64	31.3	2.2	5	160	130	1,2,3,4,5
FP-E122	PRICE	FDV	10	885	300	0.25"	0.5"	29	26	1/2	277	1	4.0	64	29.3	2.0	5	160	130	1,2,3,4,5
FP-E125	PRICE	FDV	10	1015	310	0.25"	0.5"	29	26	1/2	277	1	4.0	64	22.9	1.6	5	160	130	1,2,3,4,5
FP-E127	PRICE	FDV	12	1060	320	0.25"	0.5"	33	34	1/2	277	1	4.0	64	20.5	2.0	5	160	130	1,2,3,4,5
FP-E128	PRICE	FDV	10	885	270	0.25"	0.5"	29	26	1/2	277	1	4.0	64	21.3	1.5	5	160	130	1,2,3,4,5
FP-E130	PRICE	FDV	8	665	200	0.25"	0.5"	28	22	1/3	277	1	2.1	64	17.8	1.2	5	160	130	1,2,3,4,5
FP-E208	PRICE	FDV	8	700	210	0.25"	0.5"	28	22	1/3	277	1	2.1	64	18.7	1.3	5	160	130	1,2,3,4,5
FP-E209	PRICE	FDV	8	700	210	0.25"	0.5"	28	22	1/3	277	1	2.1	64	18.7	1.3	5	160	130	1,2,3,4,5
FP-E210	PRICE	FDV	8	700	210	0.25"	0.5"	28	22	1/3	277	1	2.1	64	18.7	1.3	5	160	130	1,2,3,4,5
FP-E211	PRICE	FDV	8	700	210	0.25"	0.5"	28	22	1/3	277	1	2.1	64	18.7	1.3	5	160	130	1,2,3,4,5
FP-E212	PRICE	FDV	10	785	240	0.25"	0.5"	29	26	1/2	277	1	4.0	64	22.7	1.6	5	160	130	1,2,3,4,5
FP-E214	PRICE	FDV	10	860	260	0.25"	0.5"	29	26	1/2	277	1	4.0	64	30.9	2.2	5	160	130	1,2,3,4,5
FP-E215A	PRICE	FDV	16	2310	700	0.25"	0.5"	40	35	1	277	1	5.9	64	65.4	4.6	5	160	130	1,2,3,4,5
FP-E215B	PRICE	FDV	16	2310	700	0.25"	0.5"	40	35	1	277	1	5.9	64	65.4	4.6	5	160	130	1,2,3,4,5
FP-E215C	PRICE	FDV	16	2310	700	0.25"	0.5"	40	35	1	277	1	5.9	64	65.4	4.6	5	160	130	1,2,3,4,5
FP-E218	PRICE	FDV	10	970	300	0.25"	0.5"	29	26	1/2	277	1	4.0	64	29.7	2.1	5	160	130	1,2,3,4,5
FP-E219	PRICE	FDV	10	1050	320	0.25"	0.5"	29	26	1/2	277	1	4.0	64	23.1	1.7	5	160	130	1,2,3,4,5
FP-E223	PRICE	FDV	10	1010	310	0.25"	0.5"	29	26	1/2	277	1	4.0	64	25.2	1.8	5	160	130	1,2,3,4,5
FP-E225	PRICE	FDV	12	1100	330	0.25"	0.5"	33	34	1/2	277	1	4.0	64	29.3	2.0	5	160	130	1,2,3,4,5
FP-E226	PRICE	FDV	10	800	270	0.25"	0.5"	29	26	1/2	277	1	4.0	64	21.0	1.5	5	160	130	1,2,3,4,5
FP-E229	PRICE	FDV	8	620	190	0.25"	0.5"	28	22	1/3	277	1	2.1	64	10.7	0.7	5	160	130	1,2,3,4,5

WATER COOLED CHILLER SCHEDULE

UNIT NO.	MANUF.	MODEL NO.	TONS	EVAP. BUNDLE EWT	LWT	WPD	GPM	COND. BUNDLE EWT	LWT	WPD	GPM	ELECTRICAL VOLTS	PH	TOTAL KW	KW/TON	NPLV/IP KW/TON	MCA	MFS	SOUND (dB)	OPER. WT. (LBS)	REMARKS
CH-1-6A	DAIKIN	WVM040R035NA	275	56	44	23.9	575	85	94.3	16.9	845	460	3	169.8	0.6174	0.3238	275	560	84	18,170	1.2,3
CH-1-6B	TRANE	RTH040CIF	275	56	44	8.0	575	85	94.3	7.21	845	460	3	172.3	0.6208	0.3767	280	500	83	21,500	1,2,4
CH-1-6C	CARRIER	23XRVS337NQVA51	275	56	44	25.3	576.1	85	94.3	15.2	845	460	3	183.7	0.6680	0.3595	303	500	84	18,170	1,2,5

- REMARKS:
1. PROVIDE 66KA SCOR RATING AND SINGLE POINT POWER CONNECTION WITH DISCONNECT SWITCH.
 2. CAPACITIES BASED ON 75% WATER/25% PROPYLENE GLYCOL.
 3. PROVIDE UNDER ALTERNATE 6A.
 4. PROVIDE UNDER ALTERNATE 6B.
 5. PROVIDE UNDER ALTERNATE 6C.

BOILER SCHEDULE

BOILER NO.	MANUF.	MODEL NO.	AGA INPUT (MBH)	AGA OUTPUT (MBH)	OPERATING EFFICIENCY (%)	ELECTRICAL VOLT	PH	FLA	MCA	MCCP	OPERATING WEIGHT (LBS)	REMARKS
B-1	HURST	S1-125	5,231	4,184	80	460	3	9.7	---	---	10,200	1,2,3,4,6
B-2	HURST	S1-125	5,231	4,184	80	460	3	9.7	---	---	10,200	1,2,3,4,6
B-3	HURST	S1-125	5,231	4,184	80	460	3	9.7	---	---	10,200	1,2,3,4,5

- REMARKS:
1. BOILER VENT SHALL DISCHARGE HORIZONTALLY OUT OF UNIT.
 2. PROVIDE EMERGENCY SHUT-OFF MUSHROOM SWITCH.
 3. PROVIDE BURNER INTAKE SOUND ATTENUATOR.
 4. ELECTRICAL CONTRATOR TO PROVIDE DISCONNECTS.
 5. FUTURE.
 6. PROVIDE 5K SCOR RATING.

PUMP SCHEDULE

PUMP NO.	MANUF.	MODEL NO.	DESCRIPTION	STYLE	SIZE	GPM	MOTOR HEAD (FT)	MHP	BHP	RPM	ELEC. VOLT	PH	SUCT. SIZE	DISCH. SIZE	REMARKS
P-1	BELL & GOSSETT	S-80	PRIMARY HEATING	INLINE	5X30X.58	475	50	10	8.0	1200	460	3	6	6	1,2
P-2	BELL & GOSSETT	S-80	PRIMARY HEATING	INLINE	5X30X.58	475	50	10	8.0	1200	460	3	6	6	1,2
P-3	BELL & GOSSETT	E-1532	SECONDARY HEATING	BASE	4GC	815	150	50	38.4	1800	460	3	5	4	1,2
P-4	BELL & GOSSETT	E-1532	SECONDARY HEATING	BASE	4GC	815	150	50	38.5	1800	460	3	5	4	1,2
P-5	BELL & GOSSETT	E-1532	PRIMARY CHILLED	BASE	3BD	600	65	15	12.1	1800	460	3	4	3	1,2
P-6	BELL & GOSSETT	E-1532	PRIMARY CHILLED	BASE	3BD	600	65	15	12.1	1800	460	3	4	3	1,2,5
P-7	BELL & GOSSETT	E-1532	SECONDARY CHILLED	BASE	4GC	900	150	50	43.4	1800	460	3	5	4	1,2
P-8	BELL & GOSSETT	E-1532	SECONDARY CHILLED	BASE	4GC	900	150	50	43.4	1800	460	3	5	4	1,2,5
P-9	BELL & GOSSETT	E-1532	COOLING TOWER	BASE	5GB	850	45	15	12.8	1200	460	3	6	5	1,2
P-10	BELL & GOSSETT	E-1532	COOLING TOWER	BASE	5GB	850	45	15	12.8	1200	460	3	6	5	1,2,5
P-11	BELL & GOSSETT	PL-55	110 HW RECIRC	INLINE	---	35	25	2/5	---	3250	115	1	1	1	3
P-12	BELL & GOSSETT	PL-30	140 HW RECIRC	INLINE	---	12	15	1/12	---	2650	115	1	3/4	3/4	3
P-13	BELL & GOSSETT	PL-30	HW STORAGE TANK PUMP	INLINE	---	12	15	1/12	---	2650	115	1	3/4	3/4	---
P-14	BELL & GOSSETT	NRF-36	INFLOOR	INLINE	---	6	20	270W	---	3300	115	1	3/4	3/4	---
P-15	BELL & GOSSETT	NRF-36	INFLOOR	INLINE	---	6	20	270W	---	3300	115	1	3/4	3/4	---
P-16	BELL & GOSSETT	NRF-36	INFLOOR	INLINE	---	6	20	270W	---	3300	115	1	3/4	3/4	---
P-17	BELL & GOSSETT	NRF-36	INFLOOR	INLINE	---	6	20	270W	---	3300	115	1	3/4	3/4	---
P-18	BELL & GOSSETT	NRF-36	INFLOOR	INLINE	---	6	20	270W	---	3300	115	1	3/4	3/4	---
P-19	BELL & GOSSETT	NRF-36	INFLOOR	INLINE	---	6	20	270W	---	3300	115	1	3/4	3/4	---
P-20	BELL & GOSSETT	NRF-36	INFLOOR	INLINE	---	6	20	270W	---	3300	115	1	3/4	3/4	---
P-21	STANCOR	SE40-0M-ELV	ELEVATOR SUMP	SUBMERS	---	50	11	0.4	---	115	1	---	---	---	4
P-22	BELL & GOSSETT	PL-30	AHU-11 COIL	INLINE	---	22	8	1/12	---	2650	115	1	1 1/2	1 1/2	---

- REMARKS:
1. PUMPS SHALL BE NON-OVERLOADING.
 2. PROVIDE VFD.
 3. BRONZE BODY.
 4. OIL MINDER PUMP WITH CONTROL PANEL.
 5. FUTURE.

GAS FIRED WATER HEATER SCHEDULE

UNIT NO.	MANUF.	MODEL NO.	INPUT (MBH)	STORAGE TANK (GAL)	EFF.	RECOVERY GPH @ 90°F	ELECTRICAL VOLT	PH	AMPS	REMARKS
WHTR-1	HTP	PH198-19	199	119	96	263	120	1	8	1,2
WHTR-2	HTP	PH198-19	199	119	96	263	120	1	8	1,2
WHTR-3	HTP	PH198-19	199	119	96	263	120	1	8	1,2,3

- REMARKS:
1. ASME T & P RELIEF VALVE.
 2. DIRECT VENT/SEALED COMBUSTION.
 3. FUTURE.

COOLING TOWER SCHEDULE

UNIT NO.	MANUF.	MODEL NO.	MBH			AMB. AIR			TOWER WATER FLOW			AIRFLOW CFM	SOUND (dB)	FAN HP	ELECTRICAL HEAT	ELECTRICAL		OPERATING WEIGHT (LBS)	REMARKS
			CAP	DB	WB	EWT	LWT	GPM	VOLT	PH									
CT-1	BAC	S3E-8518-0SL	4,123	95	78	95	85	825	77,350	95	15	(2) 6KW	460	3	15,170	1,2,3,4			
CT-2	BAC	S3E-8518-0SL	4,123	95	78	95	85	825	77,350	95	15	(2) 6KW	460	3	15,170	1,3,4,5			

- REMARKS:
1. SEE SPECIFICATION FOR MORE DETAIL.
 2. PROVIDE AMADREP MODEL TC-27X3X4-8P1-GRN OPAL DISC FILTRATION SYSTEM OR EQUAL. 7.5 HP FILTRATION PUMP. PROVIDE 5K SCOR RATING ON FILTRATION PUMP.
 3. PROVIDE VFD.
 4. COOLING TOWER MAKE-UP WATER VALVE SHALL BE LOCATED INSIDE THE BUILDING.
 5. FUTURE.

REGISTER GRILLE & DIFFUSER SCHEDULE

SYMBOL	MANUF.	CONSTR	MODEL NO.	MAX CFM	OVERALL SIZE	THROAT SIZE	NC	THROW	TOTAL PD (IN W.G.)	FRAME	PATTERNS	REMARKS
D1	KRUEGER	S	PLQ	230	24/24	6"ø	26	12	0.06	LAY-IN/SURFACE	4-WAY	---
D2	KRUEGER	S	PLQ	430	24/24	10"ø	26	17	0.08	LAY-IN/SURFACE	4-WAY	---
D3	KRUEGER	S	PLQ	575	24/24	12"ø	30	20	0.10	LAY-IN/SURFACE	4-WAY	---
D4	KRUEGER	A	56500	450	24/24	12"ø	25	24	0.07	LAY-IN	PERFORATED	---
D5	KRUEGER	S	PLQ	100	12/12	6"ø	---	8	0.06	LAY-IN	4-WAY	---
D6	KRUEGER	S	PLQ	110	24/24	6"ø	26	9	0.08	LAY-IN	4-WAY	---
G1	KRUEGER	A	EGC5	620	24/12	22/19	25	---	0.03	LAY-IN/SURFACE	1/2" GRID	---
G2	KRUEGER	A	EGC5	1400	24/24	22/22	15	---	0.03	LAY-IN/SURFACE	1/2" GRID	---
G3	KRUEGER	A	EGC5	150	10/10	8/8	---	---	0.02	LAY-IN/SURFACE	1/2" GRID	---
G4	KRUEGER	A	EGC5	300	18/10	16/8	---	---	0.02	SURFACE	1/2" GRID	---
G5	KRUEGER	S	PLQ	5400	28/20	30/26	48/24	29	0.06	SURFACE	SD	1
G6	KRUEGER	S	PLQ	5400	28/20	30/26	48/24	29	0.06	SURFACE	SD	1
G8	KRUEGER	S	S80	965	26/18	24/16	19	---	0.02	SURFACE	SD	---
R1	KRUEGER	S	S80	770	26/10	24/8	26	51	0.07	SURFACE	DD	---
R2	KRUEGER	S	S80	250	10/10	8/8	22	29	0.08	SURFACE	DD	1
R3	KRUEGER	S	S80	525	18/10	16/8	25	42	0.08	SURFACE	DD	1
R4	KRUEGER	S	S80	7700	44/44	42/42	35	161	0.07	SURFACE	DD	1

- LEGEND:
R - REGISTER
G - GRILLE
D - DIFFUSER
- SD - SINGLE DEFLECTION
DD - DOUBLE DEFLECTION
- A - ALUMINUM CONSTRUCTION.
S - STEEL CONSTRUCTION.
- GENERAL NOTES:
1. THROWS ARE BASED ON TERMINAL VELOCITIES AT 50 FPM.
2. NC VALUES ARE BASED UPON A 10dB ROOM ATTENUATION.
3. SEE SPECIFICATIONS FOR OPPOSED BLADE DAMPER REQUIREMENTS.

- REMARKS:
1. COLOR BY ARCHITECT.

LOUVER SCHEDULE

LVR NO.	MANUF.	MODEL NO.	SIZE W X H X D	FREE AREA S.F.	CFM	VEL FPM	PD IN. WG	REMARKS
LVR-1	GREENHECK	ESD-635	84X132X6	50.9	---	---	---	1
LVR-2	GREENHECK	ESD-635	116X108X6	56.8	38,000	665	0.07	1
LVR-3	GREENHECK	ESD-635	174X72X6	54.4	27,200	500	0.04	1
LVR-4	GREENHECK	ESD-635	72X72X6	22.4	11,000	491	0.036	1
LVR-5	GREENHECK	ESD-635	102X72X6	31.9	16,000	502	0.038	1
LVR-6	GREENHECK	ESD-635	102X72X6	31.9	16,000	502	0.038	1
LVR-7	GREENHECK	ESD-635	144X72X6	44.9	22,000	490	0.036	1
LVR-8	GREENHECK	ESD-635	126X72X6	39	20,000	513	0.039	1
LVR-9	GREENHECK	ESD-635	180X72X6	56.3	28,000	497	0.037	1
LVR-10	GREENHECK	ESD-635	48X60X6	12.19	2,500	199	0.01	1
LVR-11	GREENHECK	ESD-635	120X60X6	---	---	---	---	1,2

- REMARKS:
1. COLOR BY ARCHITECT.
 2. LOUVER USED AS FUTURE DUCT ROUTING BLOCK-OUT. CAP AND INSULATE WITH 2" RIGID INSULATION AND SEAL WATER TIGHT.

CABINET UNIT HEATER SCHEDULE

UNIT NO.	MANUFACTURER	UNIT SIZE	TYPE	INTAKE LOCATION	DISCHARGE LOCATION	CFM	FAN MOTOR(S) RPM	FAN HP-1	FAN HP-2	V/PH	HEATING CAPACITY MBH	EWT	LWT	GPM	WPD	REMARKS
CUH-B103	BEACONMORRIS	06	SRWI	FT	FB	630	1050	1/10	---	115/1	29.7	160	130	2.8	5'	1,2
CUH-B103	BEACONMORRIS	08	SRWI	FT	FB	845	1050	1/15	1/10	115/1	54.2	160	130	2.8	5'	1,2,3
UH-A101	BEACONMORRIS	HB-72	HP	R	F	1100	1000	1/20	---	115/1	32.3	160	130	3.1	5'	1,4
UH-B118	BEACONMORRIS	HB-72	HP	R	F	1100	1000	1/20	---	115/1	32.3	160	130	3.1	5'	1,4

MODEL TYPE: F - FLOOR; FI - FLOOR INVERTED FLOW; W - WALL; WI - WALL INVERTED FLOW; FRW - FULLY RECESSED WALL
FRWI - FULLY RECESSED WALL INVERTED FLOW; SRW - SEMI RECESSED WALL; SRWI - SEMI RECESSED WALL INVERTED FLOW
C - CEILING; RC - RECESSED CEILING; HP - HORIZONTAL PROPELLER UNIT

LOCATIONS: F - FRONT; R - REAR; B - BOTTOM; T - TOP


- REMARKS:
1. HEATING CAPACITY BASED ON 70% WATER/30% PROPYLENE GLYCOL.
 2. PROVIDE TAMPER RESISTANT FASTENERS FOR ACCESS DOOR.
 3. UNIT SHALL HAVE TWO ROW COIL.
 4. UNIT HEATER HUNG FROM STRUCTURE.

PLUMBING FIXTURE SCHEDULE


FIXTURE SYMBOL	TYPE	MANUFACTURER	MODEL NO.	TRIM	SUPPLIES	WASTE	REMARKS
WC-1	WATER CLOSET FLUSH VALVE FLOOR MOUNTED ELONG	AMERICAN STANDARD	2234.001	SLOAN 8111-1.6	---	---	CHURCH 9500SSCT SEAT BATTERY OPERATOR
WC-2	WATER CLOSET FLUSH VALVE FLOOR MOUNTED ELONG HANDI	AMERICAN STANDARD	3043.001	SLOAN 8111-1.6	---	---	CHURCH 9500SSCT SEAT BATTERY OPERATOR
WC-3	WATER CLOSET FLUSH VALVE WALL HUNG	AMERICAN STANDARD	2634.101	SLOAN 152-1.6 ES-S	---	---	CHURCH 9500SSCT SEAT JOSAM SERIES 12000 CARRIER MNT. HEIGHT ON ARCH. PLANS BACK SPUD, SOLENOID OPERATOR
UR-1	URINAL WASHOUT WALL HUNG	SLOAN	SU-7019	SLOAN 195-1-ES-S	---	---	JOSAM SERIES 17000 CARRIER MNT. HEIGHT ON ARCH. PLANS BACK SPUD, SOLENOID OPERATOR
L-1	LAVATORY WALL HUNG HANDI	AMERICAN STANDARD	0355.421	ZURN Z86100-XL-16M SINGLE HOLE LAWLER TMM-1070	BRASSCRAFT OCR192	GRID DRAIN	17 GA. C.P. P-TRAP JOSAM SERIES 17000 CARRIER MNT. HEIGHT ON ARCH. PLANS W/TRUBRO WASTE & WATER PIPE PROTECTOR, OFFSET WASTE ARM
L-2	LAVATORY 3-PERSON SEMICIRCULAR	WILLOUGHBY INDUSTRIES	WAF-3603- PFB1	---	BRASSCRAFT OCR192	---	17 GA. C.P. P-TRAP MNT. HEIGHT ON ARCH. PLANS
L-3	LAVATORY 3-PERSON	WILLOUGHBY INDUSTRIES	WAW-2333- PFB1	---	BRASSCRAFT OCR192	---	17 GA. C.P. P-TRAP MNT. HEIGHT ON ARCH. PLANS
L-4	LAVATORY WALL HUNG HANDI KITCHEN	AMERICAN STANDARD	0355.421	CHICAGO 895-317 LAWLER TMM-1070	BRASSCRAFT OCR192	GRID DRAIN	17 GA. C.P. P-TRAP JOSAM SERIES 17000 CARRIER MNT. HEIGHT ON ARCH. PLANS W/TRUBRO WASTE & WATER PIPE PROTECTOR, OFFSET WASTE ARM
MSK	MOP SINK FLOOR MOUNTED	FIAT	TSBC1610 -832AA -889CC	ZURN Z843M1-RC-CS W/VACUUM BREAKER	---	---	CW HB MTD 5'-0" AFF
SK-1	SINK-STAINLESS STEEL, SINGLE COMPARTMENT	ELKAY	PSR-1919	CHICAGO 2302	BRASSCRAFT OCR192	LK-35 STRAINER	17 GA. C.P. P-TRAP
SK-2	SINK-STAINLESS STEEL DOUBLE COMPARTMENT	ELKAY	PSR-3319	CHICAGO 2302 GNBAJKABCP SPOUT	BRASSCRAFT OCR192	LK-35 STRAINER LK-53 CONT WASTE	17 GA. C.P. P-TRAP
SK-3	SINK-STAINLESS STEEL, SINGLE COMPARTMENT ART ROOM	ELKAY	PSR-1919	CHICAGO 2302	BRASSCRAFT OCR192	LK-35 STRAINER	STRIEM "SIDEKICK" SOLIDS INTERCEPTOR 17 GA. C.P. P-TRAP
SK-4	SINK-STAINLESS STEEL, SINGLE COMPARTMENT HANDI ART ROOM	ELKAY	LRAD-1919 -0CD	CHICAGO 2302	BRASSCRAFT OCR192	LK-35 STRAINER	STRIEM "SIDEKICK" SOLIDS INTERCEPTOR MAX AFF IN REAR OF CASEWORK, OFFSET WASTE, TRUBRO WASTE & WATER & INTERCEPTOR PROTECTOR 17 GA. C.P. P-TRAP
SK-5	UTILITY SINK WALL HUNG	MUSTEE	28CF	---	BRASSCRAFT OCR192	STRAINER	17 GA. C.P. P-TRAP
SK-6	SINK-STAINLESS STEEL DOUBLE COMPARTMENT FACS LAB	ELKAY	PSR-3319	CHICAGO 2302 GNBAJKABCP SPOUT	BRASSCRAFT OCR192	LK-35 STRAINER LK-53 CONT WASTE	17 GA. C.P. P-TRAP
SK-7	SINK-STAINLESS STEEL DOUBLE COMPARTMENT HANDI FACS LAB	ELKAY	LRAD-3319 -0CD	CHICAGO 2302 GNBAJKABCP SPOUT	BRASSCRAFT OCR192	LK-35 STRAINER LK-53 CONT WASTE	17 GA. C.P. P-TRAP OFFSET WASTE ARM, TRUBRO WASTE & WATER PIPE PROTECTOR
SK-8	SINK-STAINLESS STEEL DOUBLE COMPARTMENT FACS LAB / DISHWASHER	ELKAY	PSR-3319	CHICAGO 2302 GNBAJKABCP SPOUT	BRASSCRAFT OCR192	LK-35 STRAINER LK-53 CONT WASTE	17 GA. C.P. P-TRAP PROVIDE WASTE & WATER CONNECTIONS TO DISHWASHER
SK-9	SINK-INTEGRAL BOWL SCIENCE SINK	BY OTHERS	---	CHICAGO 930-369	BRASSCRAFT OCR192	BASKET STRAINER	ACID RESISTANT P-TRAP
SK-10	SINK-INTEGRAL BOWL SCIENCE SINK	BY OTHERS	---	CHICAGO 930-369	BRASSCRAFT OCR192	BASKET STRAINER	ACID RESISTANT P-TRAP PROVIDE WASTE & WATER CONNECTIONS TO DISHWASHER
SH-1	SHOWER	TILE	---	BRADLEY WS-1F-6" AST-SX15-ST-RSD-VS	---	2" FLOOR DRAIN	ALL METAL TRIM, THERMOSTATIC MIXING VALVE, FIXED SHOWER HEAD
SH-2	SHOWER - ADA	TILE	---	BRADLEY HN200-6" AST-QSX15-ST-RSD -VS	---	2" FLOOR DRAIN	ALL METAL TRIM, THERMOSTATIC MIXING VALVE, 2 FIXED SHOWER HEADS
ESH-1	COMBINATION EYEWASH & SHOWER HANDI	BRADLEY	S19- 120SSBF S19-224SC	---	---	---	17 GA. C.P. P-TRAP, MIXING VALVE, LAWLER MODEL NO. 911 E INLET CHECK VALVES
EW-1	ELECTRIC WATER COOLER WALL MTD DUAL HEIGHT W/ BOTTLE FILL	ELKAY	LZST18WSSP	---	BRASSCRAFT OCR192	---	17 GA. C.P. P-TRAP MNT. HEIGHT ON ARCH. PLANS
CW-1	CAN WASH FAUCET & FSK	T&S BRASS	B-0167	---	---	---	FLOOR SINK WITH BUCKET JOSAM MODEL #37830-69
UB-1	DRAIN BOX	SIoux CHIEF	696-3	---	---	---	P-TRAP
UB-2	WASHER BOX	SIoux CHIEF	696- Q2313MF	---	---	---	P-TRAP, SHOCK ABSORBERS
UB-3	ICEMAKER BOX	SIoux CHIEF	696- G1010MF	---	---	---	MOUNT AT 36" AFF SHOCK ABSORBERS
GT-1	GAS TURRET, DOUBLE	CHICAGO	982-909- 957-3KAGV	---	---	---	GAS SERVICE



1	8" DS UP
2	8" DS DN W/ICO 24" AFF
3	6" DS UP TO 6" RD
4	6" DS DN W/ICO 24" AFF
5	HYDRONIC PROP TYPE UNIT HEATER HUNG FROM STRUCTURE SEE UNIT
6	HEATER PIPING DETAIL
7	HYDRONIC CABINET UNIT HEATER. SEE CABINET UNIT HEATER PIPING DETAIL
8	3/4" HWS & 3/4" HWR DN TO CUH
9	2" CW CAPPED 24" BELOW GRADE FOR FUTURE CONCESSION BUILDING
10	6" DS UP/DN W/ICO 24" AFF
11	PIPING CAPPED FOR FUTURE ADDITION
12	INFLORHEAT HEAT ZONE PUMP. SEE INFLORHEAT PUMP PIPING DETAIL.
13	INFLORHEAT HEAT ZONE #7 PIPING MANIFOLD. SEE INFLORHEAT MANIFOLD PIPING DETAIL.
14	2" V UP
15	3/4" HWS & 3/4" HWR DN TO INFLORHEAT MANIFOLD
16	1 1/2" CW DN TO ICE MAKER WITH EXPOSED ESCUTHEON & SHUTOFF VALVE
17	2" V DN
18	1 1/2" HW DN, 1 1/2" V/2" W DN, 1 1/2" CW DN
19	MECHANICAL PENETRATIONS INTO OR OUT OF A STORM SHEDDING SHALL BE DERIVED FROM DRAINING PROJECTILES BY CONCRETE BAFRLES PER ICC 500. VERIFY AND COORDINATE BAFRLE/OPENING DIMENSIONS STRUCTURAL

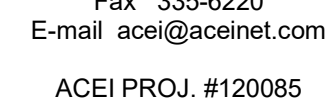

8.20-1A

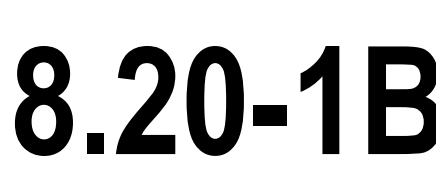



1' 6" DS UP TO RD.
 6" DS DN W/ CO #2 AFF.
 3' CONNECT TO 4" WATER SERVICE STUBBED UP TO BLIND FLANGE BY SITE UTILITY CONTRACTOR. SEE SITE UTILITY DRAWINGS
 4' WATER METER (M) 1/2" REDUCED PRESSURE BACKFLOW PREVENTER
 EXTEND RPZ TO FSK
 5' CONNECT TO 6" FIRE PROTECTION SERVICE STUBBED UP TO BLIND FLANGE BY SITE UTILITY CONTRACTOR. SEE SITE UTILITY DRAWINGS
 6' WATER SOFTENER & BRINE TANK WITH 3-WAY BYPASS. EXTEND DRAIN TO HUB DRAIN
 7' WATER HEATER, INLINE PUMPS AND MASTER MIXING VALVE. SEE WATER HEATER PIPING DETAIL. EXTEND INTAKE & EXHAUST PIPING UP THRU ROOF TO EXTERIOR. RECORD 12" MIN. CLEARANCE FROM IN-TAKE LOUVERS IN MECH ROOM ABOVE. EXTEND DRAIN TO NEUTRALIZER. EXTEND DRAIN FROM NEUTRALIZER TO FSK
 10' HOT WATER STORAGE TANK & PUMP. SEE WATER HEATER PIPING DETAIL.
 15' HYDRONIC BOILER SET ON CONCRETE HOUSEKEEPING PAD. PAD BY G.C.
 15' EXTEND DRAIN WITH SHUTOFF VALVE TO FSK. SEE BOILER PIPING DETAIL
 18' STACK ECONOMIZER. EXTEND CPVC DRAIN TO NEUTRALIZER (NEUTRALIZER TO EXTERIOR). EXTEND WATER PUMP DRAIN FROM NEUTRALIZER TO FSK
 19' INLINE BOILER CIRC. PUMP. SEE BOILER PIPING DETAIL
 21' HYDRONIC CHILLER SET ON CONCRETE HOUSEKEEPING PAD. PAD BY G.C.
 21' EXTEND DRAIN WITH SHUTOFF VALVE TO FSK. SEE CHILLER PIPING DETAIL
 22' CHEMICAL TREATMENT
 24' COOLING TOWER FILLER. EXTEND DRAIN WITH SHUTOFF VALVE TO FSK
 25' BASE MOUNTED CONDENSER WATER PUMP SET ON CONCRETE HOUSEKEEPING PAD. PAD BY G.C. SEE BASE MOUNTED PUMP DETAIL.
 26' BASE MOUNTED WATER PUMP SET ON CONCRETE HOUSEKEEPING PAD. PAD BY G.C. SEE BASE MOUNTED PUMP DETAIL
 27' BASE MOUNTED CHILLED WATER PUMP SET ON CONCRETE HOUSEKEEPING PAD. PAD BY G.C. SEE BASE MOUNTED PUMP DETAIL
 28' CHILLED WATER SYSTEM AIR SEPARATOR. SEE AIR SEPARATOR PIPING DETAIL
 29' HEATING WATER SYSTEM AIR SEPARATOR. SEE AIR SEPARATOR PIPING DETAIL
 30' CHILLED WATER SYSTEM VERTICAL EXPANSION TANK SET ON CONCRETE HOUSEKEEPING PAD. PAD BY G.C. SEE EXPANSION TANK PIPING DETAIL
 31' CHILLED WATER SYSTEM VERTICAL EXPANSION TANK SET ON CONCRETE HOUSEKEEPING PAD. PAD BY G.C. SEE EXPANSION TANK PIPING DETAIL
 32' 3" IRRIGATION TIE IN TO 3" REDUCED PRESSURE BACKFLOW PREVENTER
 32' 1/2" S/S RPZ (M) WITH 3" THRU WALL & CAP FOR CONTINUATION BY SITE IRRIGATION CONTRACTOR
 33' COOLING TOWER. SEE SPECIFICATION AND COOLING TOWER PIPING DETAIL FOR MORE INFORMATION. PROVIDE PAD & EQUIPMENT SUPPORTS AS REQUIRED TO RAISE LOWEST POINT OF COOLING TOWER BASIN 4" ABOVE THE INLET OF THE CONDENSER WATER PUMP
 34' 2" V DN
 25' 1" V UP 4" VTR
 26' 1/4" G DN WITH GAS COCK. PRESSURE REDUCING VALVE & UNION TO BOILER
 27' GAS METER & GAS SERVICE. SEE SPECIFICATIONS, GAS PIPING SIZED AT 5 POUND.
 28' 1/4" TRHW UP, 2" HW UP, 4" CW UP, 8" HWS UP, 8" HWR UP, 8" CHS UP, 8" CHR UP
 29' PIPING CAPPED FOR FUTURE FIXTURES
 30' 2" W PIPING CAPPED ABOVE FLOOR FOR FUTURE FIXTURES
 31' 4" W PIPING CAPPED ABOVE FLOOR FOR FUTURE FIXTURES
 32' 1/2" DN, 1/2" DN, 1/2" W DN, 1/2" CW DN. PIPING TO BE ROUGHED IN FOR FUTURE FIXTURES
 33' 1/2" V/W DN, 2" CW DN
 34' 2" W DN WICO 24" AFF
 35' 1/2" DN TO HUB TO MSK, 1/2" DN TO MSK, 2" V DN, 2" V DN. INSTALL PIPING VERTICAL PIPING ON UNISTRUT SUPPORT
 36' 3" FILTER SUPPLY & 3" FILTER RETURN DN TO FILTER WITH SHUTOFF VALVES 1" CW, 7" CHEMICAL FEED RETURN & 1" CHEMICAL SUPPLY DN TO CHEMICAL TREATMENT SYSTEM
 37' 3/4" CW DN WITH SHUTOFF VALVE TO HB





Project: **HARRISBURG HS - 9TH GRADE ACADEMY**
 Description: **ENLARGED BOILER & TOILET ROOM PLAN
 - PLUMBING & HEATING**

number 1002.2904.20
date 11-19-21
revision
drawn DWM checked Td

NO.	DATE	DESCRIPTION
1	12-10-21	ADD M2

8.20-1BA

12/9/2021 5:13:28 PM

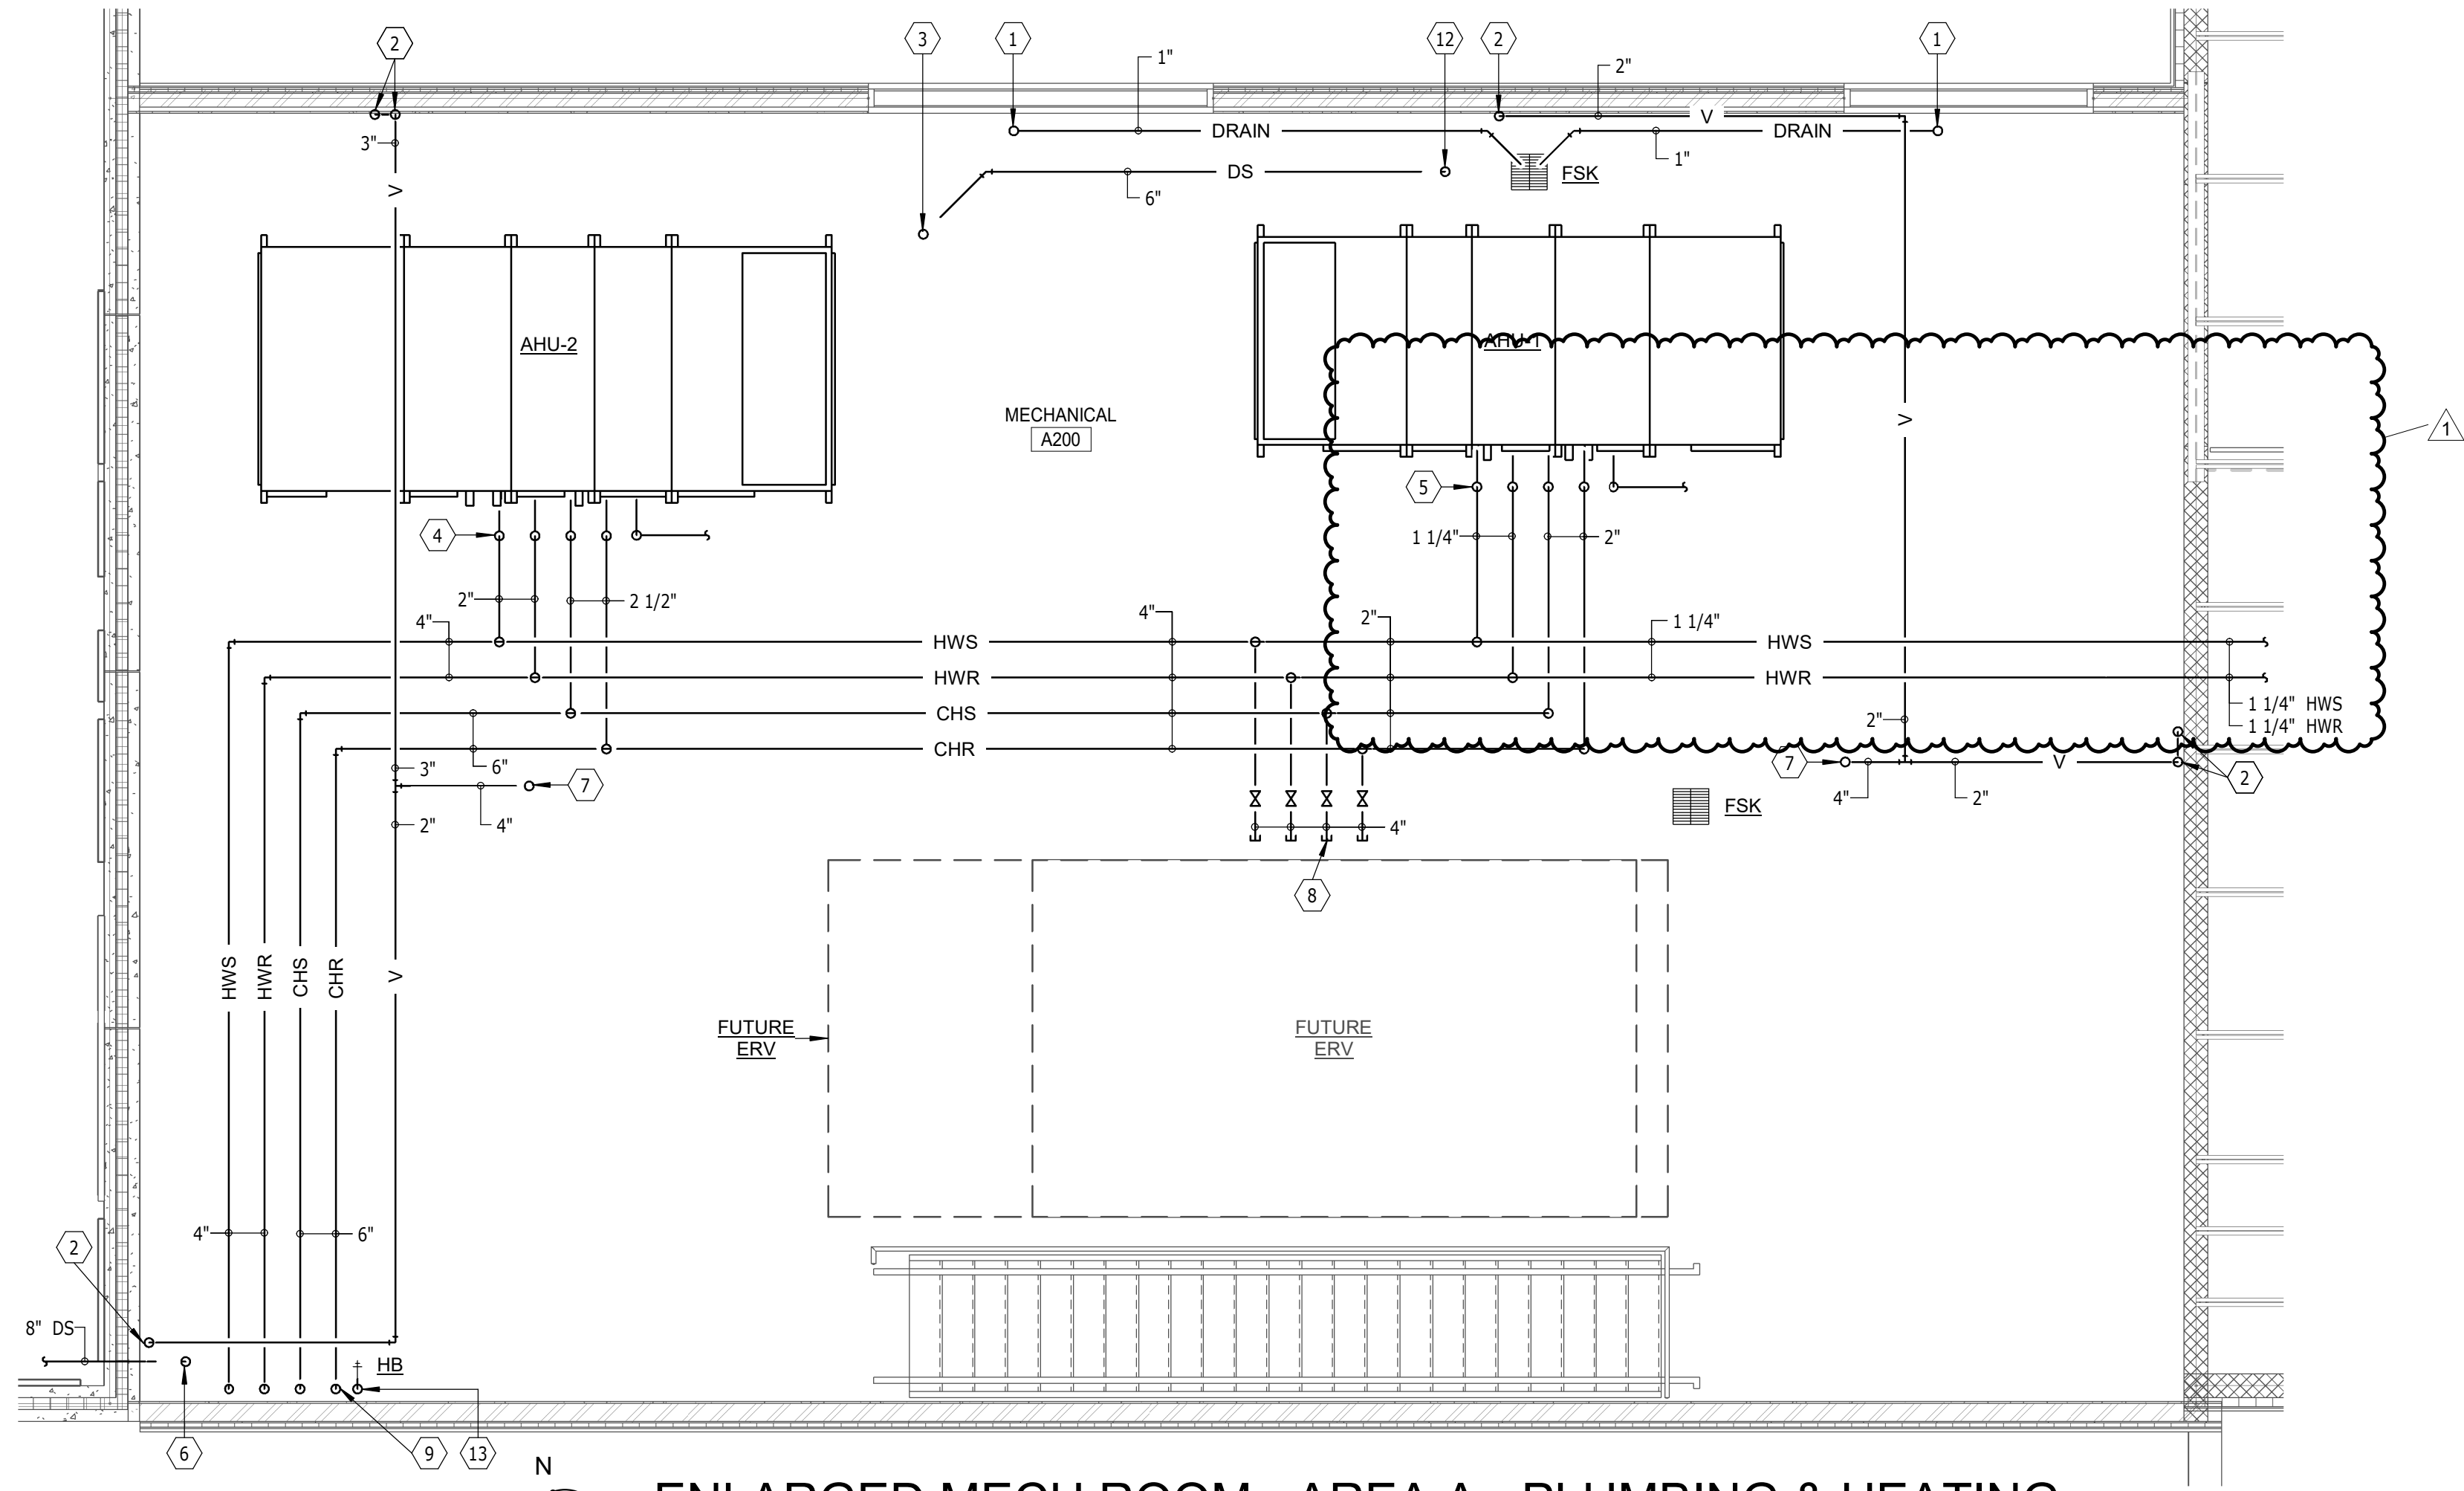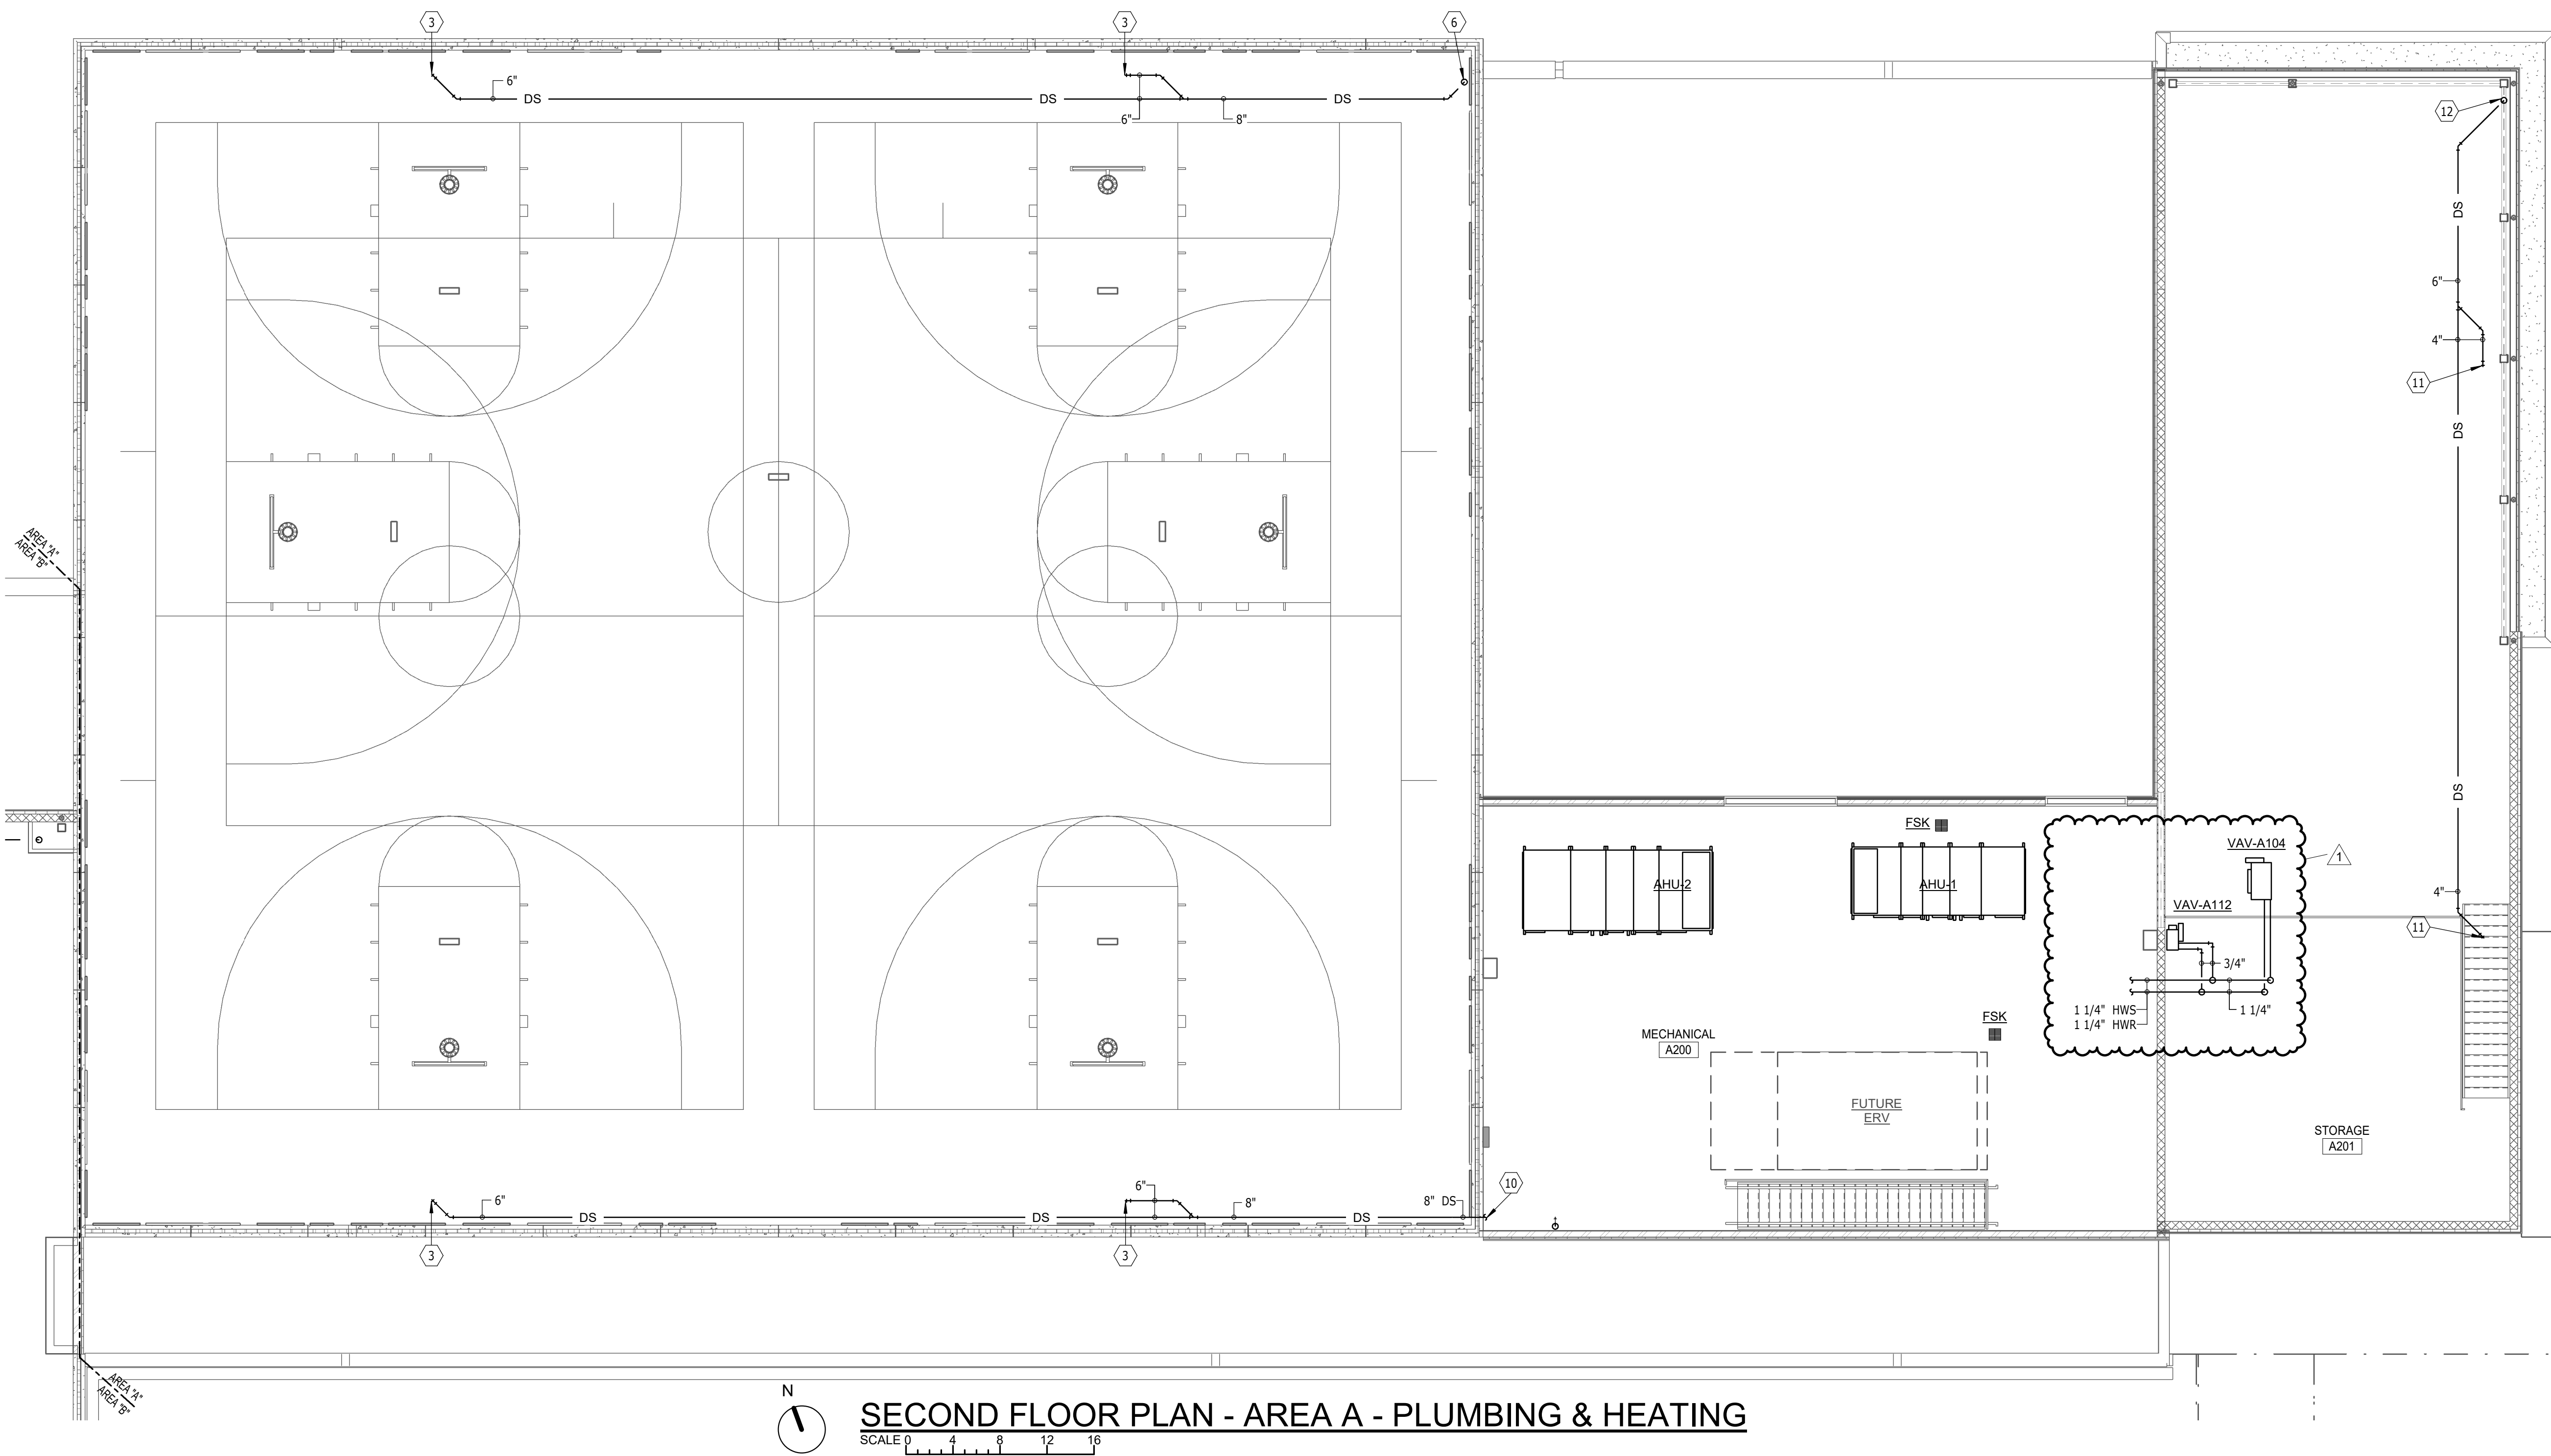


GENERAL SHEET NOTES

A THE CEILING SPACE AVAILABLE REQUIRES COORDINATION WITH OTHER TRADES. THE CONTRACTORS SHALL PROVIDE ALL OFFSETS AND RELOCATE AS REQUIRED TO COORDINATE THE INSTALLATION OF ALL MATERIALS AND EQUIPMENT WITH OTHER TRADES.

PLUMBING & HEATING NOTES



- 1 EXTEND 1" DRAIN FROM LOUVER DRAIN PAN TO FSK
- 2 2" V DN
- 3 6" DS UP TO 6" RD
- 4 2" HWS, 2" HWR, 2 1/2" CHS & 2 1/2" CHR DN TO AHU. EXTEND COND TO FSK
- 5 1 1/4" HWS, 1 1/4" HWR, 2" CHS & 2" CHR DN TO AHU. EXTEND COND TO FSK
- 6 6" DS DN
- 7 4" V UP (4" VTR)
- 8 PIPING CAPPED FOR FUTURE ADDITION
- 9 4" HWS DN, 4" HWR DN, 6" CHS DN, 6" CHR DN
- 10 SEE ENLARGED MECHANICAL ROOM AREA A FOR CONTINUATION
- 11 4" DS UP TO 4" RD
- 12 6" DS DN
- 13 3/4" CW DN WITH SHUTOFF VALVE TO HB

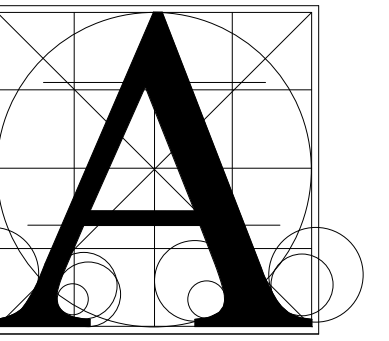

**Architecture
Incorporated**

415 South Main Avenue
P.O. Box 2140
Sioux Falls, South Dakota 57101
Phone: (605) 339-1711

815 St Joseph Street, Suite 203
P.O. Box 8047
Rapid City, South Dakota 57701
Phone: (605) 721-1158

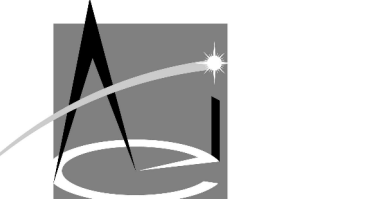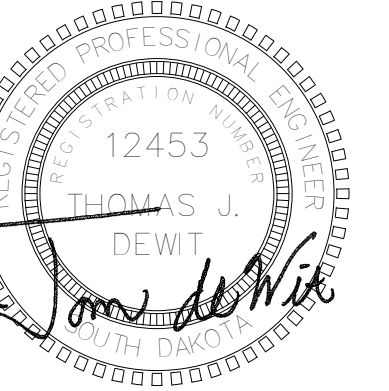

**A
ssociated
C
onsulting
E
ngineering,
I
ncorporated**

340 S. Phillips Ave.
Sioux Falls, SD 57104

(605) 335-3720 Fax: 335-6220

E-mail: acei@acenet.com


ACEI PROJ. #120085

HARRISBURG HS - 9TH GRADE ACADEMY
SECOND FLOOR PLAN - AREA A - PLUMBING & HEATING



number	1002.2904.20		
date	11-19-21		
revision			
drawn	DWM	checked	Td
	DATE	DESCRIPTION	
	12-10-21	ADD M2	

8.20-2A

12/10/2021 8:05:37 AM

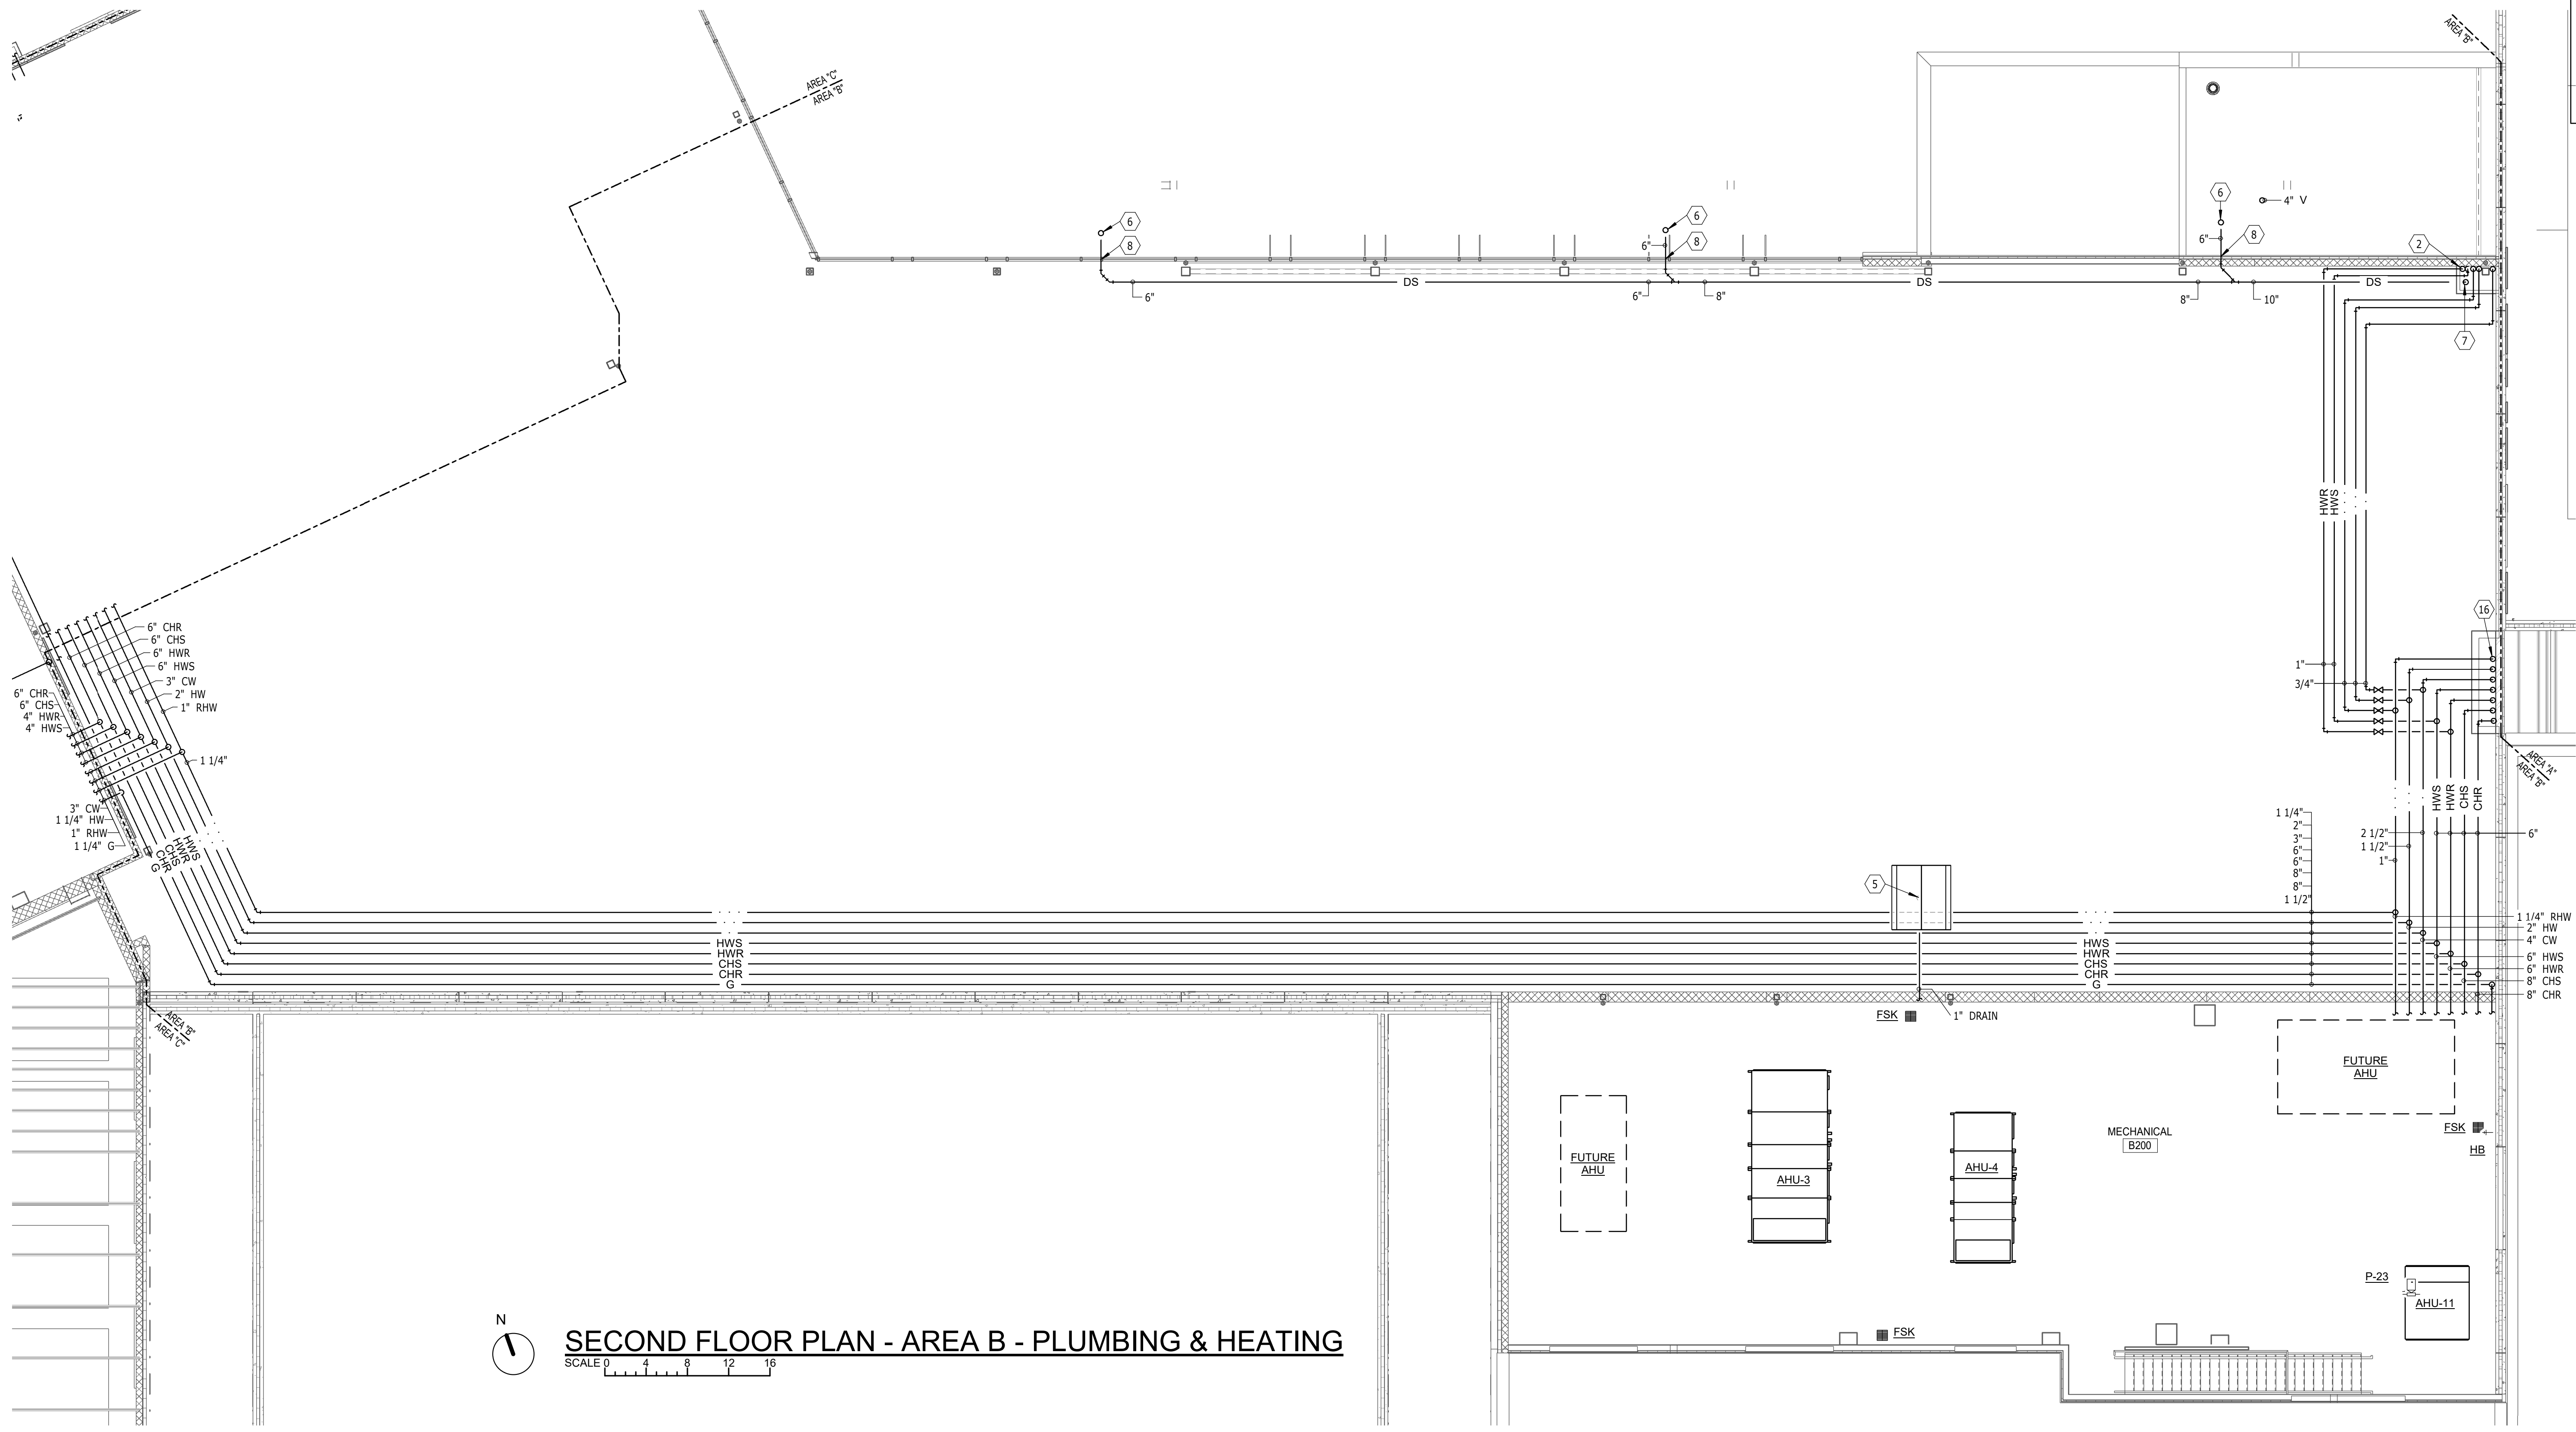

SECOND FLOOR PLAN - AREA B - PLUMBING & HEATING
SCALE 0 4 8 12 16

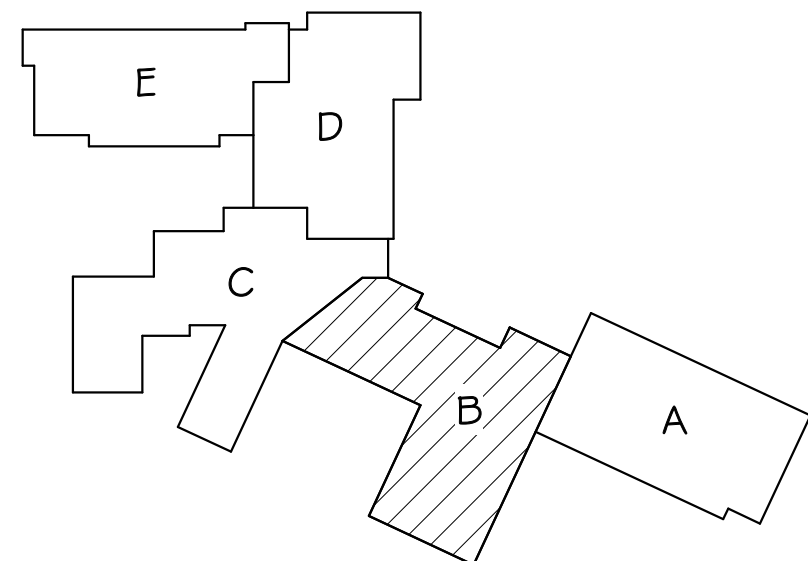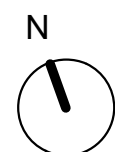


KEYPLAN

GENERAL SHEET NOTES

A THE CEILING SPACE AVAILABLE REQUIRES COORDINATION WITH OTHER TRADES. THE CONTRACTORS SHALL PROVIDE ALL OFFSETS AND RELOCATE AS REQUIRED TO COORDINATE THE INSTALLATION OF ALL MATERIALS AND EQUIPMENT WITH OTHER TRADES.

PLUMBING & HEATING NOTES


- 3" V DN.
- 1 1/4" HWS DN, 1 1/4" HWR DN, 3/4" RHW DN, 3/4" HW DN, 3/4" CW DN
- 4" DS UP TO 4" RD
- 6" DS DN
- EXTEND 1" DRAIN FROM LOUVER DRAIN PAN TO FSK
- 6" DS UP TO 6" RD
- 10" DS DN
- COORDINATE PIPING PENETRATION THRU BEAM WITH G.C.
- 2" V DN
- 4" V UP (4" VTR)
- 2 1/2" HWS DN, 2 1/2" HWR DN, 3" CHS DN, 3" CHR DN, EXTEND COND TO FSK
- 1 1/2" HWS DN, 1 1/2" HWR DN, 2" CHS DN, 2" CHR DN, EXTEND COND TO FSK
- 1 1/2" HWS DN, 1 1/2" HWR DN
- 1 1/2" HWS DN, 1 1/2" HWR DN, 2" CHS DN, 2" CHR DN, 8" HWS DN, 8" HWR DN, 8" CHS DN, 8" CHR DN, 1 1/2" G DN
- 3/4" CW DN WITH SHUTOFF VALVE TO HB
- 1" RHW DN, 1 1/2" HW DN, 2 1/2" CW DN, 6" HWS DN, 6" HWR DN, 6" CHS DN, 6" CHR DN
- AHU-11 HEATING COIL INLINE PUMP. SEE AHU-11 PIPING DETAIL

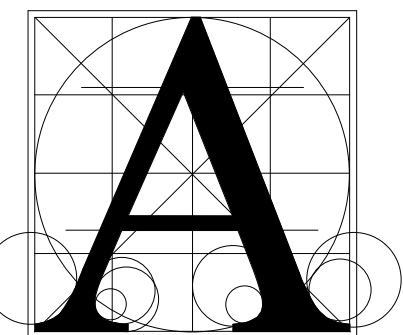

**Architecture
Incorporated**

415 South Main Avenue
P.O. Box 2140
Sioux Falls, South Dakota 57101
Phone: (605) 339-1711

815 St Joseph Street, Suite 203
P.O. Box 8047
Rapid City, South Dakota 57701
Phone: (605) 721-1158

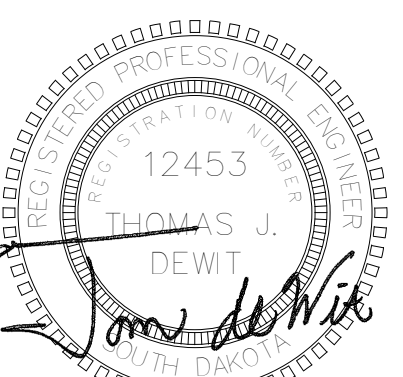

**Associated
Consulting
Engineering,
Incorporated**

340 S. Phillips Ave.
Sioux Falls, SD 57104

(605) 335-3720
Fax: 335-6220

E-mail: acei@acenet.com

ACEI PROJ. #120085

HARRISBURG HS - 9TH GRADE ACADEMY
SECOND FLOOR PLAN - AREA B - PLUMBING & HEATING

Project

number: 1002.2904.20

date: 11-19-21

revision:



drawn: DWM checked: Td

NO. DATE DESCRIPTION

1 12-10-21 ADD M2


8.20-2B

12/9/2021 5:15:02 PM

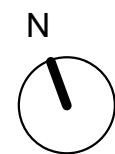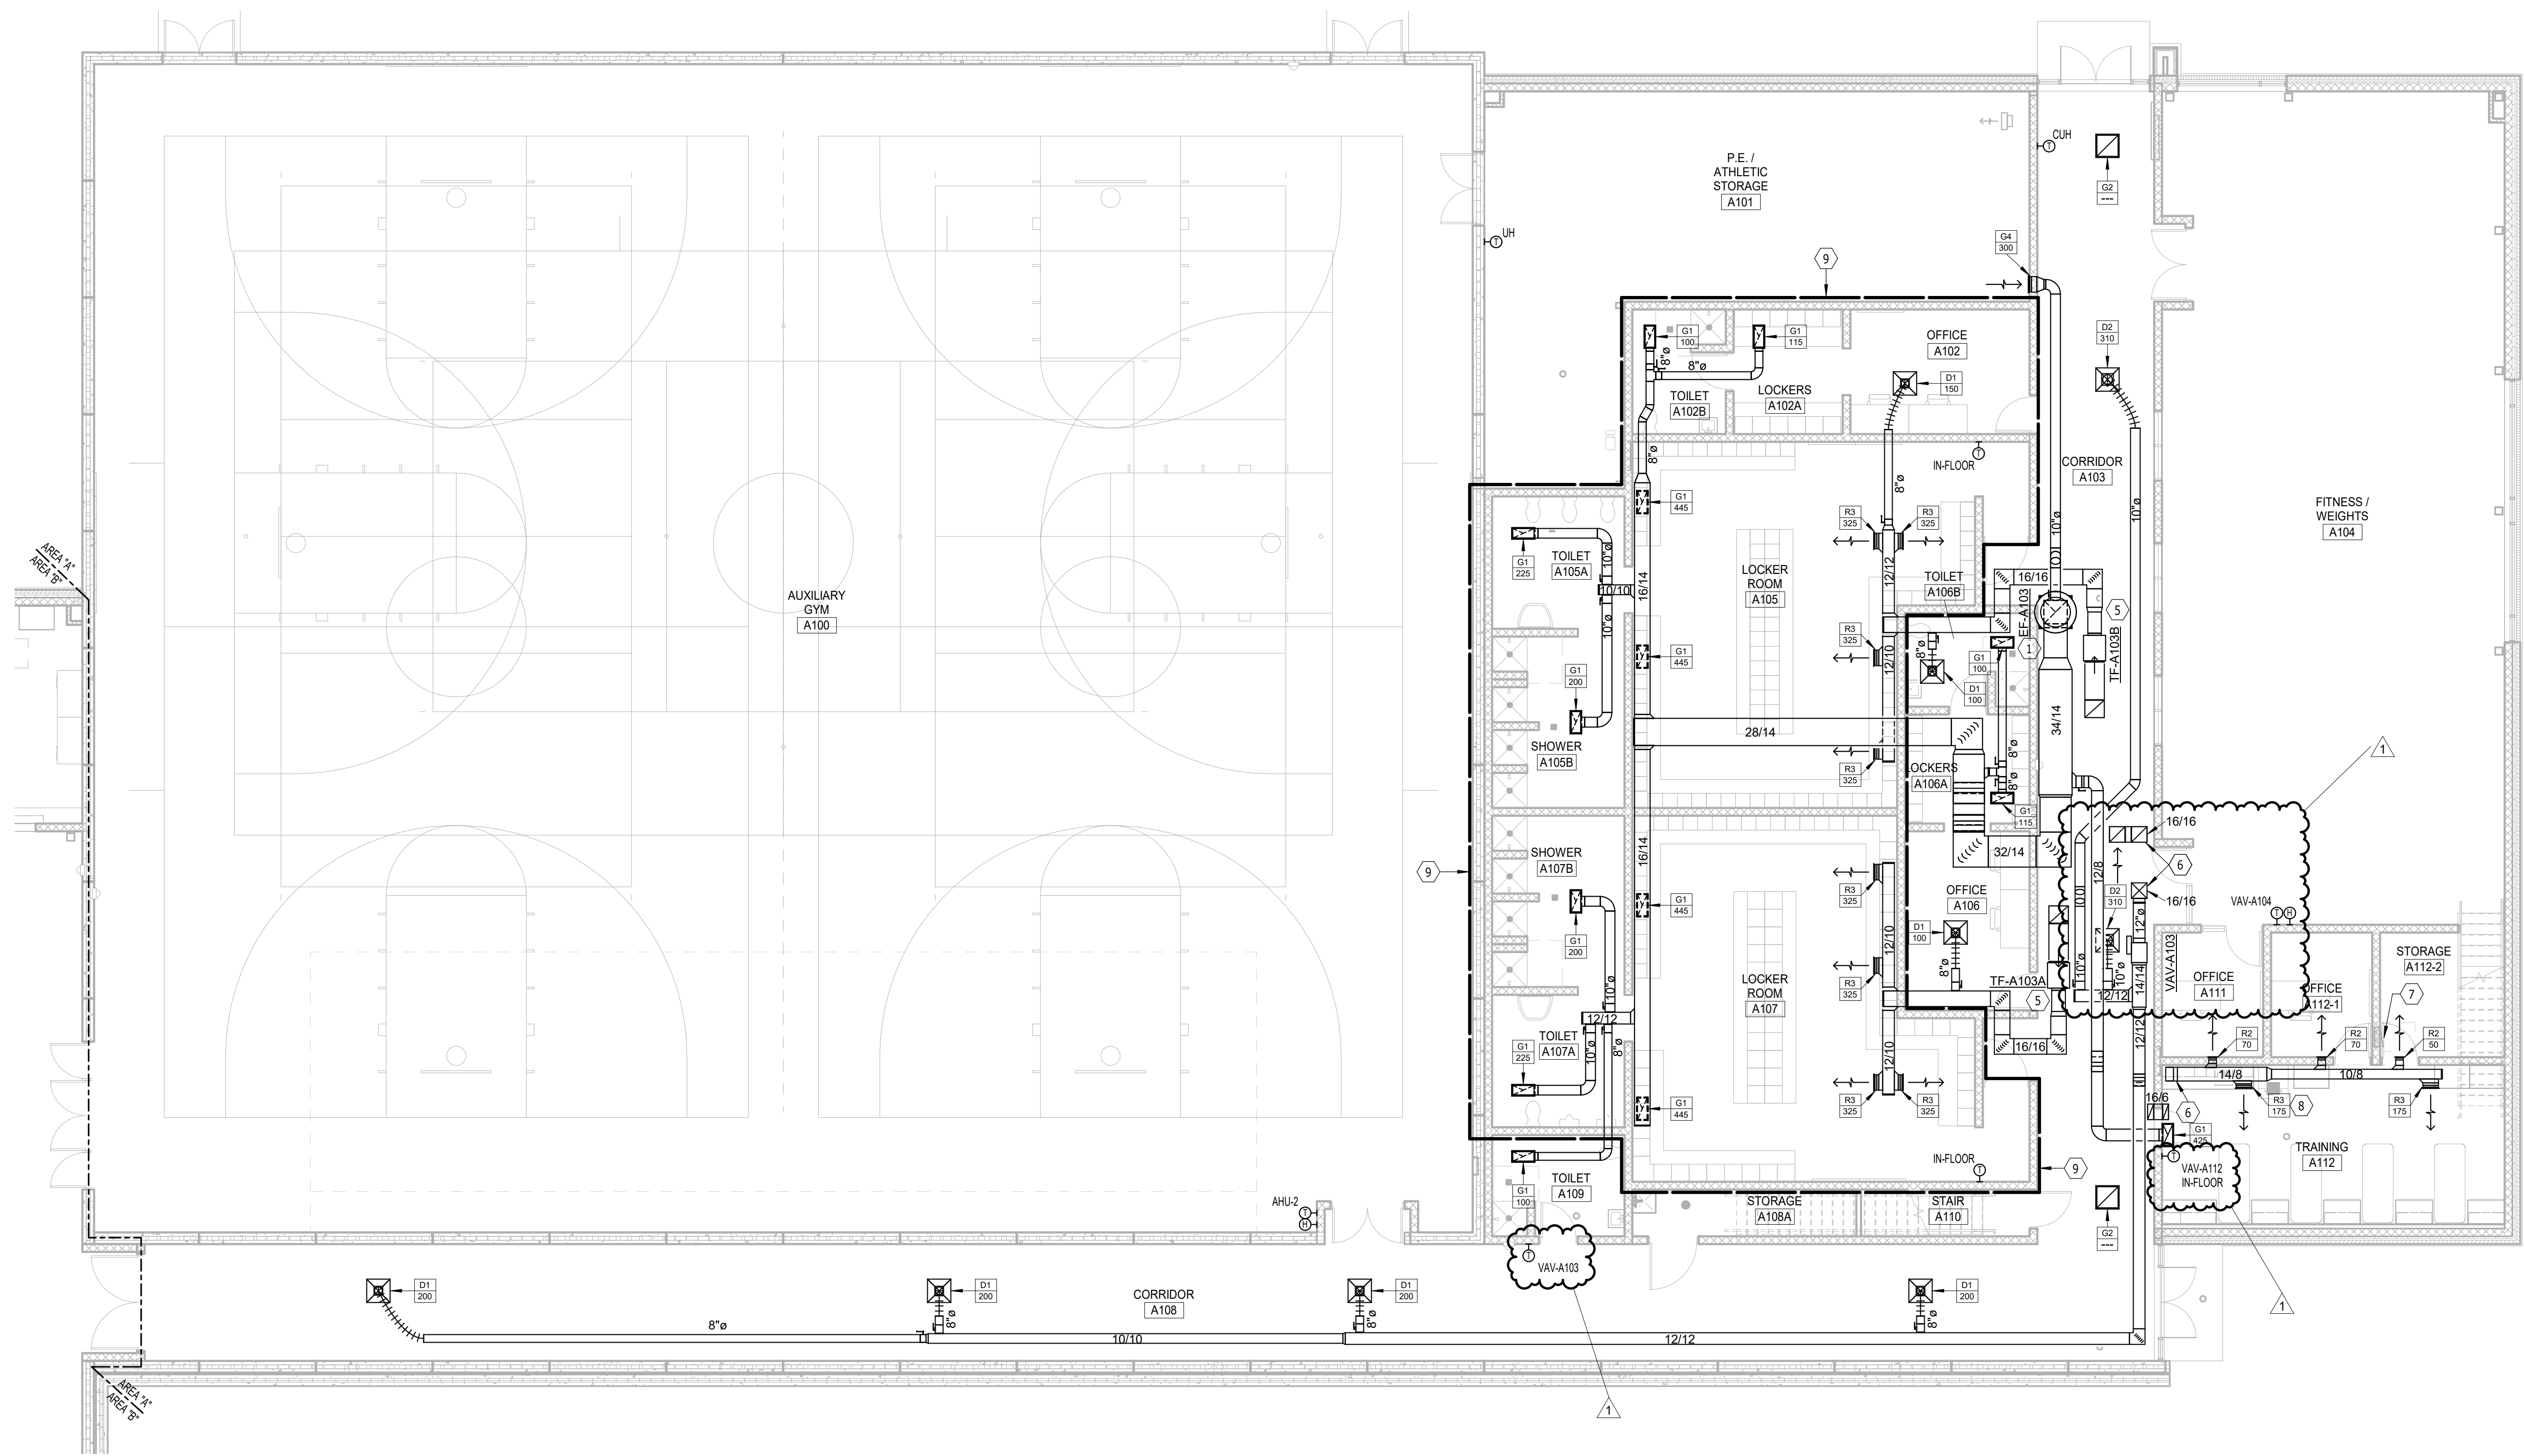

FIRST FLOOR PLAN - AREA A - VENTILATION & A/C

SCALE 0 4 8 12 16

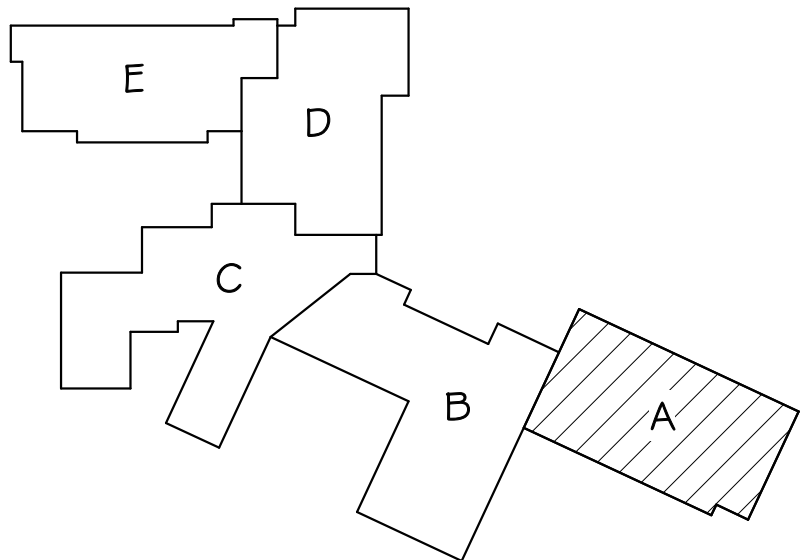


KEYPLAN

GENERAL SHEET NOTES

- A. THE CEILING SPACE AVAILABLE REQUIRES COORDINATION WITH OTHER TRADES. THE CONTRACTORS SHALL PROVIDE ALL OFFSETS AND RELOCATE AS REQUIRED TO COORDINATE THE INSTALLATION OF ALL MATERIALS AND EQUIPMENT WITH OTHER TRADES.
- B. ALL EXPOSED DUCTWORK SHALL BE DUCTMATE OR TDC. EXPOSED DUCTWORK SHALL BE PAINT GRIP TYPE EXCEPT IN MECHANICAL ROOMS. COORDINATE THERMOSTAT LOCATIONS WITH OTHER TRADES AND OWNER. THERMOSTATS IN COMMON AREAS SHALL BE FLAT PLATE STAINLESS STEEL SENSOR.
- C. RETURN AIR BOOTS SHALL BE CONSTRUCTED OF 24 GAUGE INSULATED DUCTWORK. SEE DETAIL. PROVIDE ON ALL RA AND TRANSFER AIR GRILLES.

VENTILATION NOTES


1. PRV INSTALLED ON ROOF WITH FULLY INSULATED ROOF CURB.
2. 60" OF FABRIC DUCT INSTALLED BELOW BAR JOISTS WITH BOTTOM OF DUCT AT 15' - 5" AFF. 4,200 CFM.
3. HATCHED AREA SHOWS COMPLETE FABRIC DUCT SYSTEM DESIGNED BY FABRIC DUCT MANUFACTURER. 9,400 CFM TOTAL.
4. PROVIDE OPENING IN TOP OF DUCT.
5. IN-LINE TRANSFER FAN INSTALLED ABOVE CEILING WITH ANTI-VIBRATION HANGING KIT. PROVIDE WITH FLEXIBLE DUCT CONNECTIONS.
6. SEE SECOND FLOOR PLAN TO CONTINUATION.
7. ELECTRICAL EQUIPMENT SPACE. MAINTAIN REQUIRED CLEARANCES.
8. 48"X24" SAFETY MONITORING FILTER FOR AIR BEING RETURNED TO THE SHOP FROM THE DUST COLLECTOR.
9. MECHANICAL PENETRATIONS INTO OR OUT OF A STORM SHELTER SHALL BE PROTECTED FROM INCOMING PROJECTILES. BY CONCRETE BAFFLES PER ICC 500. VERIFY AND COORDINATE BAFFLE/OPENING DIMENSIONS WITH STRUCTURAL.

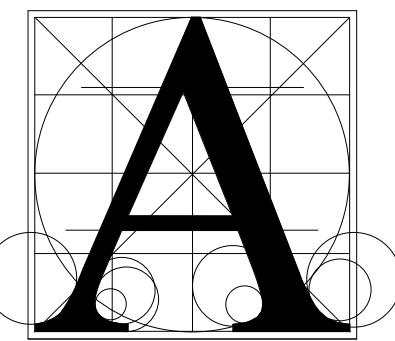

Architecture
Incorporated

415 South Main Avenue
P.O. Box 2140
Sioux Falls, South Dakota 57101
Phone: (605) 339-1711

815 St Joseph Street, Suite 203
P.O. Box 8047
Rapid City, South Dakota 57701
Phone: (605) 721-1158

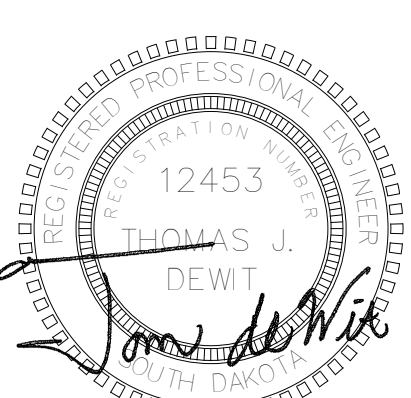

Associated
Consulting
Engineering,
Incorporated

340 S. Phillips Ave.
Sioux Falls, SD 57104
(605) 335-3720
Fax: 335-6220
E-mail: acei@aceinet.com
ACEI PROJ. #120085

Project
HARRISBURG HS - 9TH GRADE ACADEMY


Sheet Contents
FIRST FLOOR PLAN - AREA A - VENTILATION & A/C

number	1002.2904.20
date	11-19-21
revision	
drawn	DDK
checked	Td


NO.	DATE	DESCRIPTION
1	12-10-21	ADD M2

8.40-1A

12/10/2021 8:09:40 AM

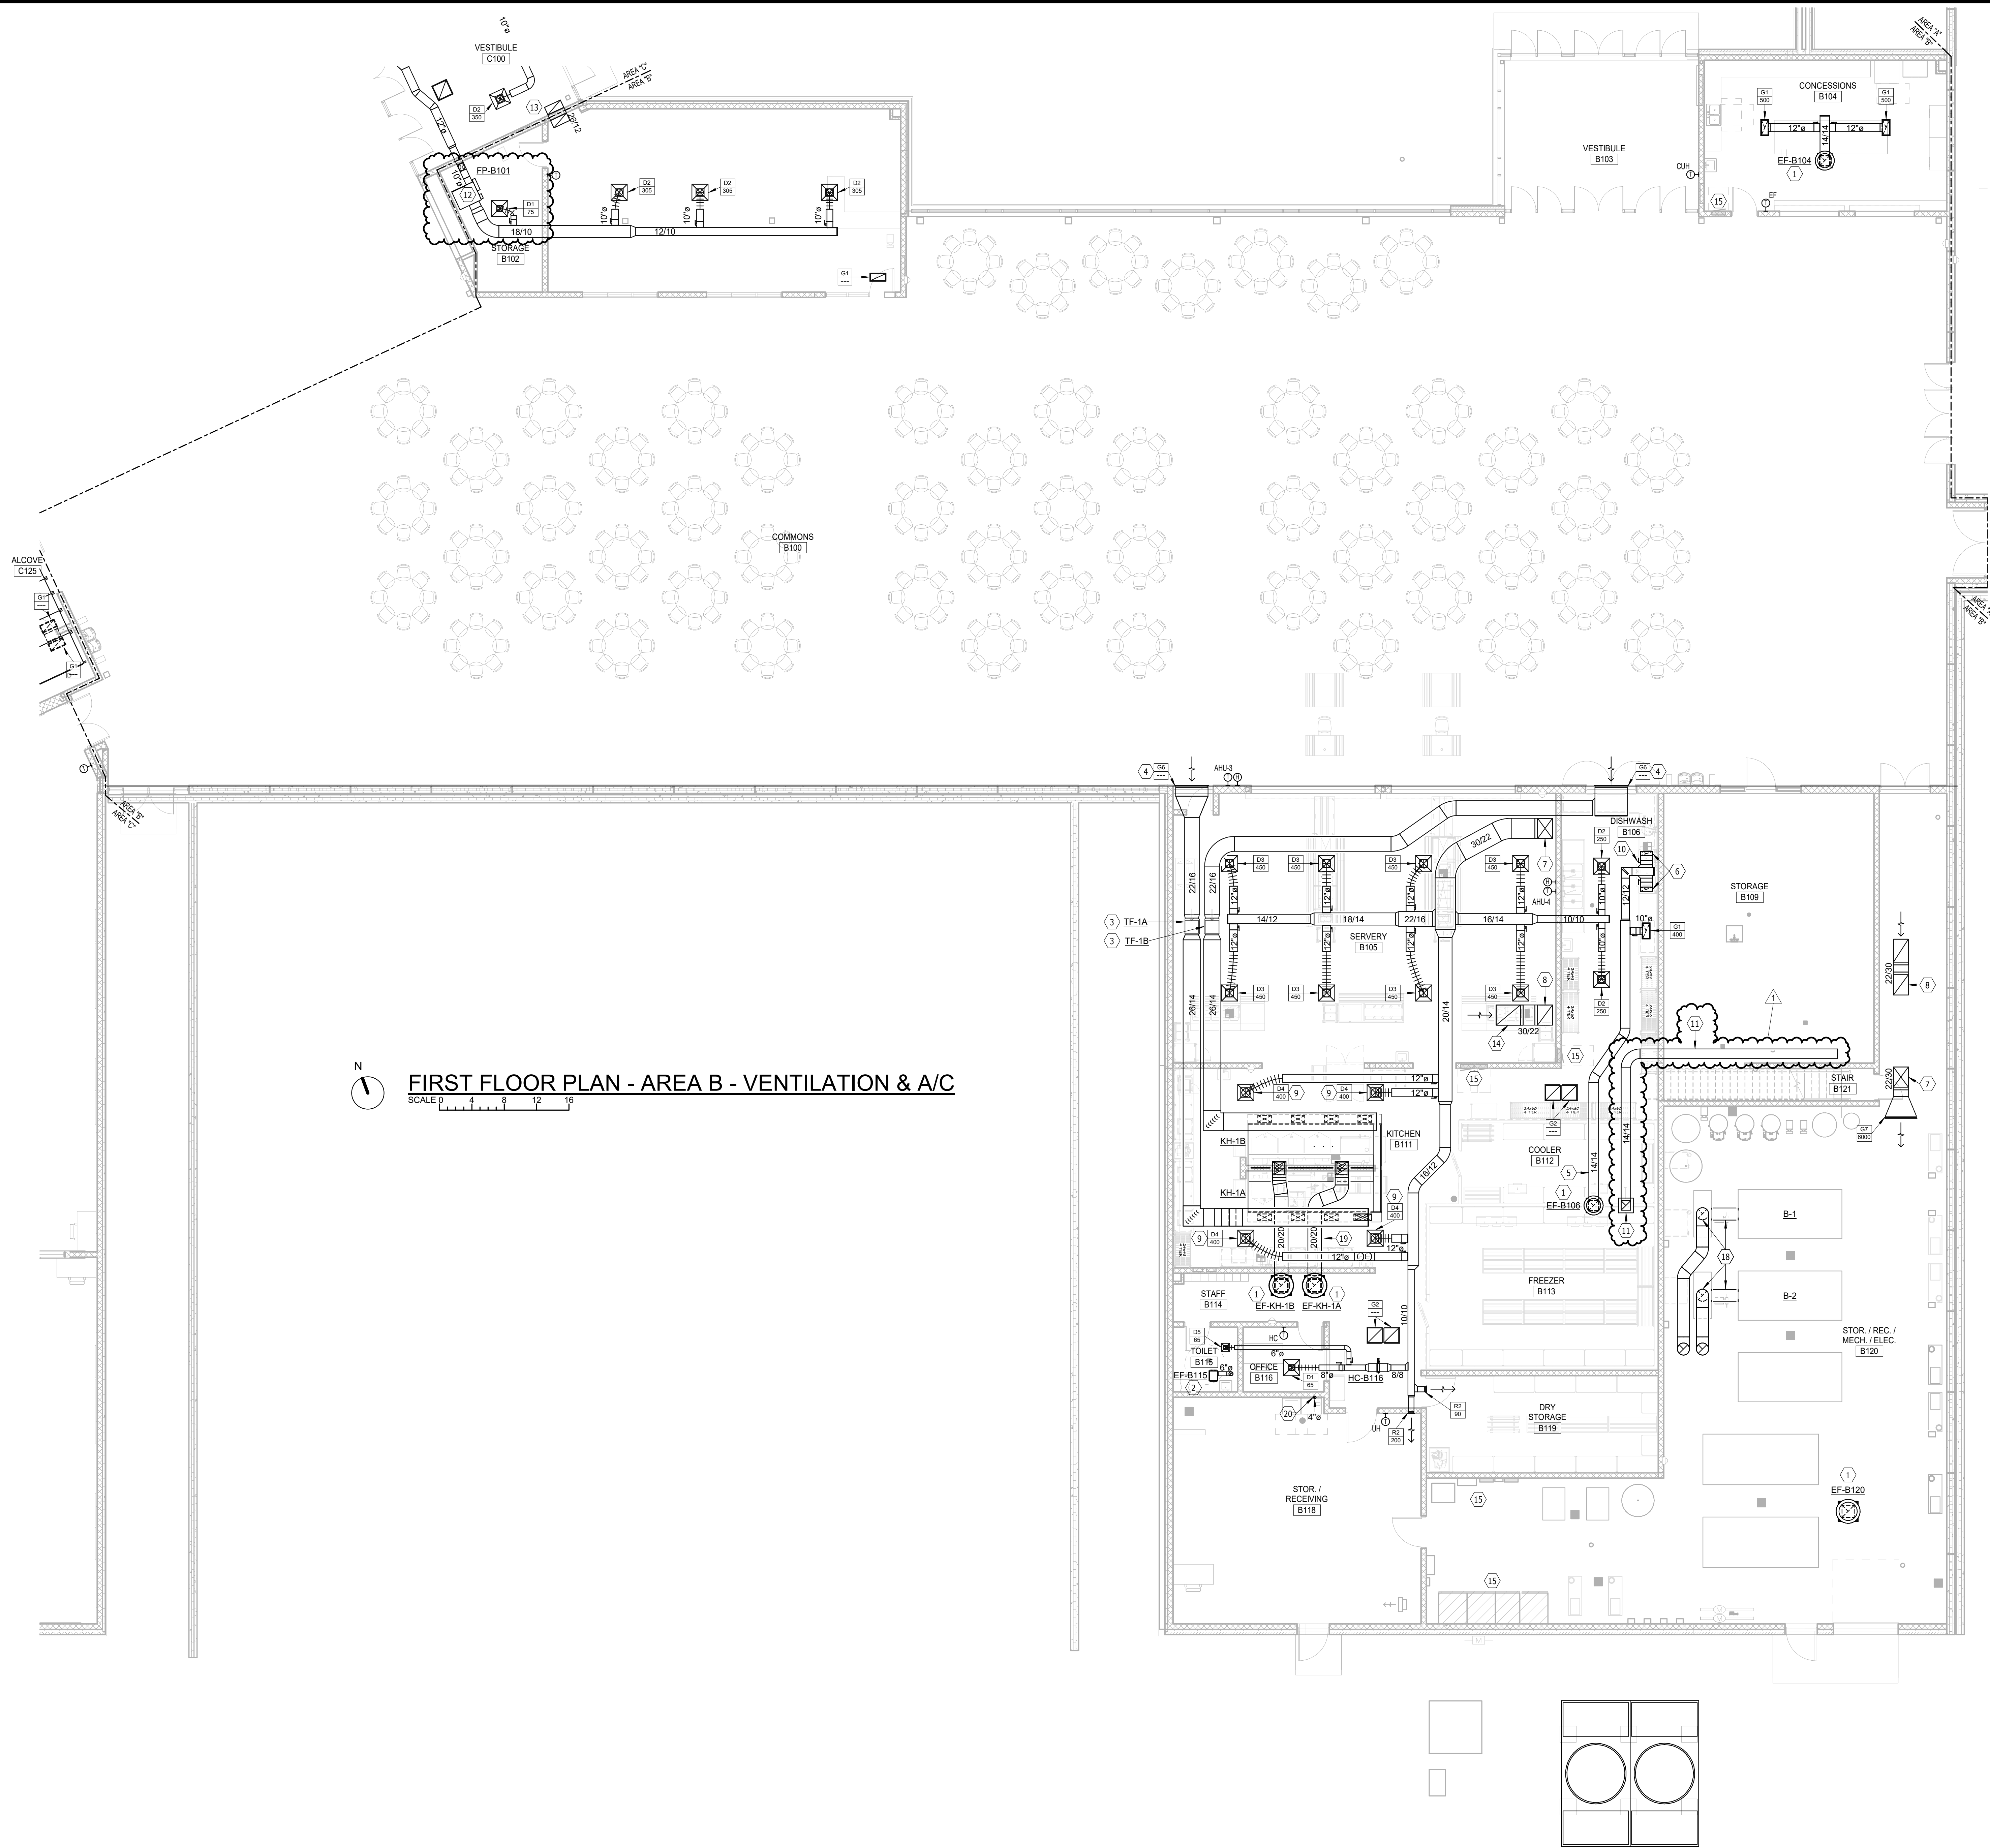

N
SCALE 0 4 8 12 16
FIRST FLOOR PLAN - AREA B - VENTILATION & A/C

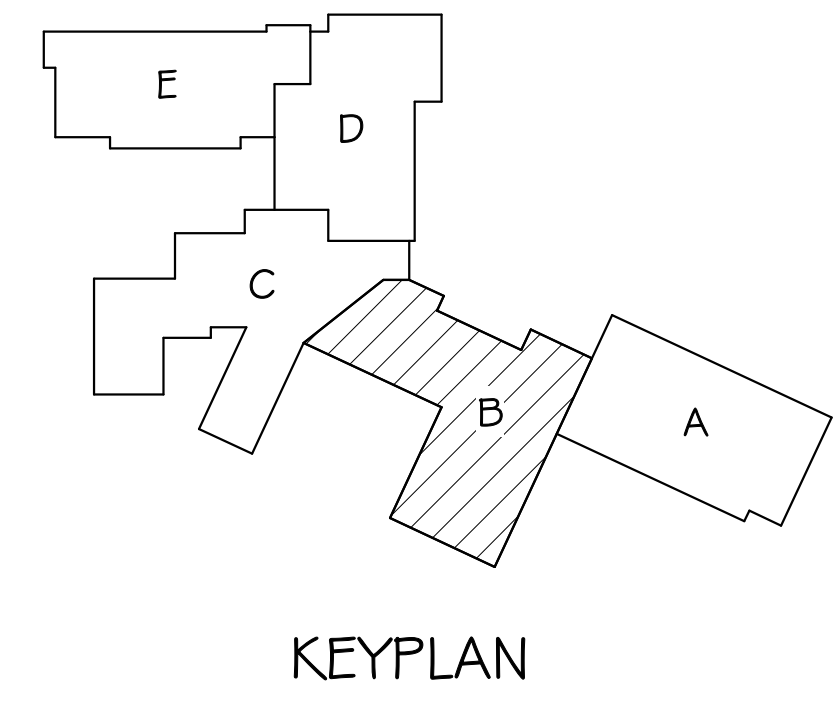

KEYPLAN

GENERAL SHEET NOTES

A. THE CEILING SPACE AVAILABLE REQUIRES COORDINATION WITH OTHER TRADES. THE CONTRACTORS SHALL PROVIDE ALL OFFSETS AND RELOCATE AS REQUIRED TO COORDINATE THE INSTALLATION OF ALL MATERIALS AND EQUIPMENT WITH OTHER TRADES.

B. ALL EXPOSED DUCTWORK SHALL BE DUCTMATE OR TDC. EXPOSED DUCTWORK SHALL BE PAINT GRIP TYPE EXCEPT IN MECHANICAL ROOMS. COORDINATE THERMOSTAT LOCATIONS WITH OTHER TRADES AND OWNER. THERMOSTATS IN COMMON AREAS SHALL BE FLAT PLATE STAINLESS STEEL SENSOR.

C. RETURN AIR BOOTS SHALL BE CONSTRUCTED OF 24 GAUGE INSULATED DUCTWORK. SEE DETAIL. PROVIDE ON ALL RA AND TRANSFER AIR GRILLES.

VENTILATION NOTES

1. PRV INSTALLED ON ROOF WITH FULLY INSULATED ROOF CURB.

2. CEILING MOUNT EXHAUST FAN. PROVIDE EXHAUST DUCT THRU THE ROOF AND TERMINATE WITH GOOSENECK.

3. IN-LINE TRANSFER FAN INSTALLED ABOVE CEILING WITH ANTI-VIBRATION HANGING KIT. PROVIDE WITH FLEXIBLE DUCT CONNECTIONS.

4. SIDEWALL RETURN GRILLE.

5. DISHWASHER EXHAUST DUCT SHALL BE STAINLESS STEEL.

6. STAINLESS STEEL EXHAUST DUCT TO DISHWASHER DUCT CONNECTIONS. COORDINATE REQUIREMENTS WITH KITCHEN EQUIPMENT SUPPLIER. BALANCE TO 200 CFM ON LOAD END AND 400 CFM ON UNLOAD END.

7. SUPPLY DUCT UP THRU FLOOR TO AIR HANDLING UNIT.

8. RETURN DUCT UP THRU FLOOR TO AIR HANDLING UNIT.

9. PERFORATED TYPE DIFFUSER. ALL DIFFUSERS WITHIN 10' OF KITCHEN HOOD SHALL DIRECT AIRFLOW AWAY FROM HOODS.

10. EXHAUST DUCT FOR FUTURE RESTROOM BUILD OUT. PROVIDE INSULATED ROOF CURB FOR FUTURE FAN LOCATION.

11. EXHAUST DUCT FOR FUTURE RESTROOM BUILD OUT. PROVIDE INSULATED ROOF CURB FOR FUTURE FAN LOCATION.

12. EXHAUST DUCT FOR FUTURE RESTROOM BUILD OUT. PROVIDE INSULATED ROOF CURB FOR FUTURE FAN LOCATION.

13. AIR TRANSFER DUCT WITH OPENINGS ON BOTH SIDES OF WALL. BOTH OPENINGS SHALL BE IN THE TOP OR ON THE SAME SIDE - NO TURN VANES - SIZE AS SHOWN OR AT 500 FPM. (TYP)

14. PROVIDE OPENINGS IN TOP OF DUCT.

15. ELECTRICAL EQUIPMENT SPACE. MAINTAIN REQUIRED CLEARANCES.

16. ROUTE DUCTWORK IN JOIST SPACE.

17. OFFSET DUCTWORK BELOW JOISTS.

18. PROVIDE BOILER VENTING PER MANUFACTURERS INSTRUCTIONS. SEE SPECS AND DETAILS FOR MORE INFORMATION.

19. ALL DUCT ELBOWS ON GREASE DUCT SHALL BE RADIUS.

20. DRYER VENT UP THRU ROOF TO EXHAUST OUTLET. TERMINATE 3' AWAY FROM ANY OPENING INTO THE BUILDING AND 10' AWAY FROM ANY MECHANICAL INTAKE. COORDINATE EXACT LOCATION OF DRYER WITH ARCHITECTURAL PLANS AND OWNER. PROVIDE AN EQUIVALENT LENGTH OF THE EXHAUST DUCT ON A PERMANENT LABEL LOCATED WITHIN 6' OF THE EXHAUST CONNECTION. INSTALL PER MANUFACTURERS RECOMMENDATIONS.

Architecture Incorporated

415 South Main Avenue
P.O. Box 2140
Sioux Falls, South Dakota 57101
Phone: (605) 339-1711

815 St Joseph Street, Suite 203
P.O. Box 8047
Rapid City, South Dakota 57701
Phone: (605) 721-1158

Associated Consulting Engineering, Incorporated

340 S. Phillips Ave.
Sioux Falls, SD 57104
(605) 335-3720
Fax: 335-6220
E-mail: acei@associated.com
ACEI PROJ. #120085



Project **HARRISBURG HS - 9TH GRADE ACADEMY**

Sheet Contents **FIRST FLOOR PLAN - AREA B - VENTILATION & A/C**

number: 1002.2904.20
date: 11-19-21
revision:
drawn: DDK checked: Td
NO. DATE DESCRIPTION
1 12-10-21 ADD M2

8.40-1B

12/9/2021 5:15:23 PM

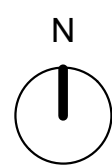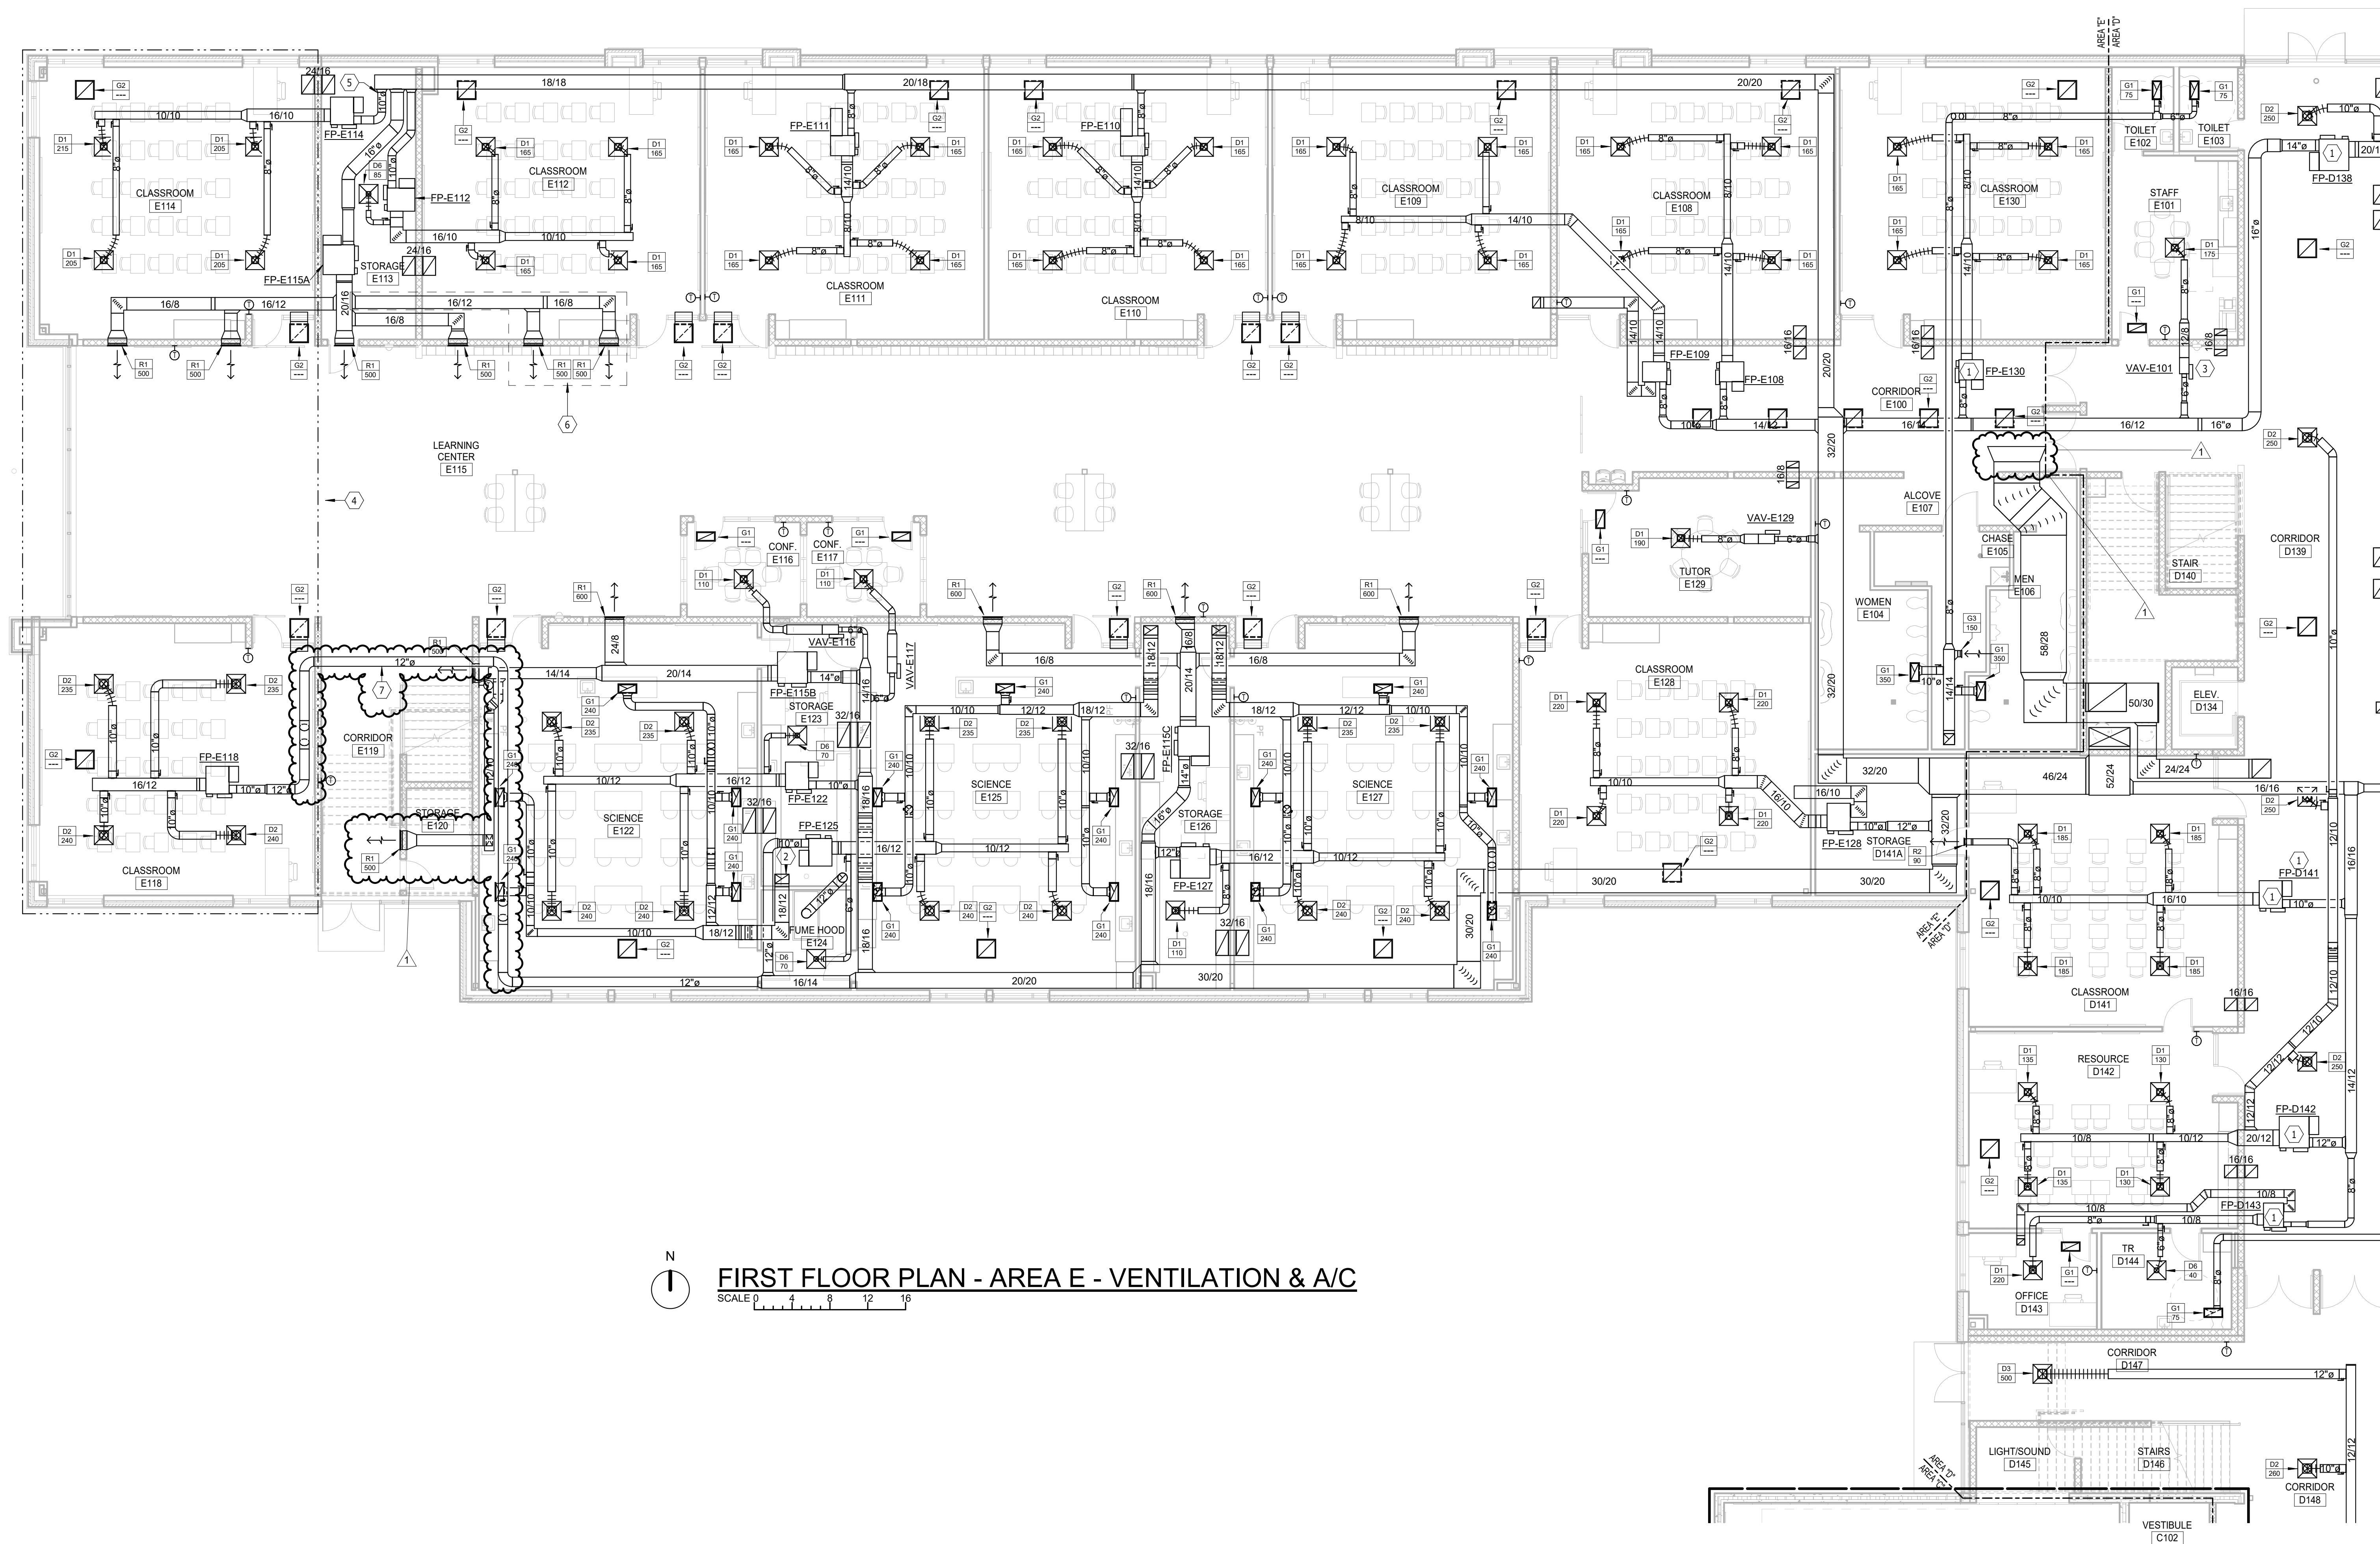

FIRST FLOOR PLAN - AREA E - VENTILATION & A/C


SCALE 1/4" = 1'-0"

GENERAL SHEET NOTES

- THE CEILING SPACE AVAILABLE REQUIRES COORDINATION WITH OTHER TRADES. THE CONTRACTORS SHALL PROVIDE ALL OFFSETS AND RELOCATE AS REQUIRED TO COORDINATE THE INSTALLATION OF ALL MATERIALS AND EQUIPMENT WITH OTHER TRADES.
- ALL EXPOSED DUCTWORK SHALL BE DUCTMATE OR TDC. EXPOSED DUCTWORK SHALL BE PAINT GRIP TYPE EXCEPT IN MECHANICAL ROOMS. COORDINATE THERMOSTAT LOCATIONS WITH OTHER TRADES AND OWNER. THERMOSTATS IN COMMON AREAS SHALL BE FLAT PLATE STAINLESS STEEL SENSOR.
- RETURN AIR BOOTS SHALL BE CONSTRUCTED OF 24 GAUGE INSULATED DUCTWORK. SEE DETAIL. PROVIDE ON ALL RA AND TRANSFER AIR GRILLES.

VENTILATION NOTES


- FAN POWERED VAV TERMINAL UNIT WITH RE-HEAT COIL INSTALLED ABOVE CEILING. PROVIDE SOUND ATTENUATION BOOT. (TYP)
- 18/12 E/A UP INTO CHASE.
- SHUT OFF TYPE VAV TERMINAL WITH RE-HEAT COIL INSTALLED ABOVE CEILING. (TYP)
- MECHANICAL ITEMS INSIDE DASHED AREA ARE PART OF ADD ALT.#1. OMIT FP-E114, FP-E118, FP-E214, FP-E218 AND ASSOCIATED DUCTWORK AND ACCESSORIES FROM BASE BID.
- CAP AT THIS LOCATION FOR BASE BID.
- MECHANICAL ITEMS INSIDE DASHED AREA ARE PART OF BASE BID. OMIT IF EXPOSED SPIRAL DUCT THRU CORRIDOR SHALL BE DOUBLE WALL CONSTRUCTION.

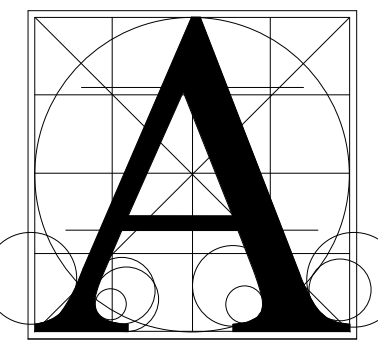

Architecture
Incorporated

415 South Main Avenue
P.O. Box 2140
Sioux Falls, South Dakota 57101
Phone: (605) 339-1711

815 St Joseph Street, Suite 203
P.O. Box 8047
Rapid City, South Dakota 57701
Phone: (605) 721-1158

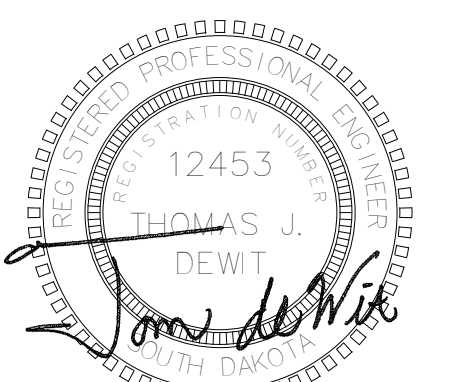

Associated
Consulting
Engineering,
Incorporated

340 S. Phillips Ave.
Sioux Falls, SD 57104

(605) 335-3720 Fax 335-6220

E-mail: acei@acenet.net

ACEI PROJ. #120085

HARRISBURG HS - 9TH GRADE ACADEMY

FIRST FLOOR PLAN - AREA E - VENTILATION & A/C

Project

Number: 1002.2904.20

Date: 11-19-21

Revision:



Drawn: NJH checked: Td

No. DATE DESCRIPTION

1 12-10-21 ADD M2


8.40-1E

12/9/2021 5:15:28 PM

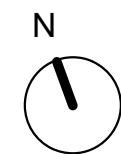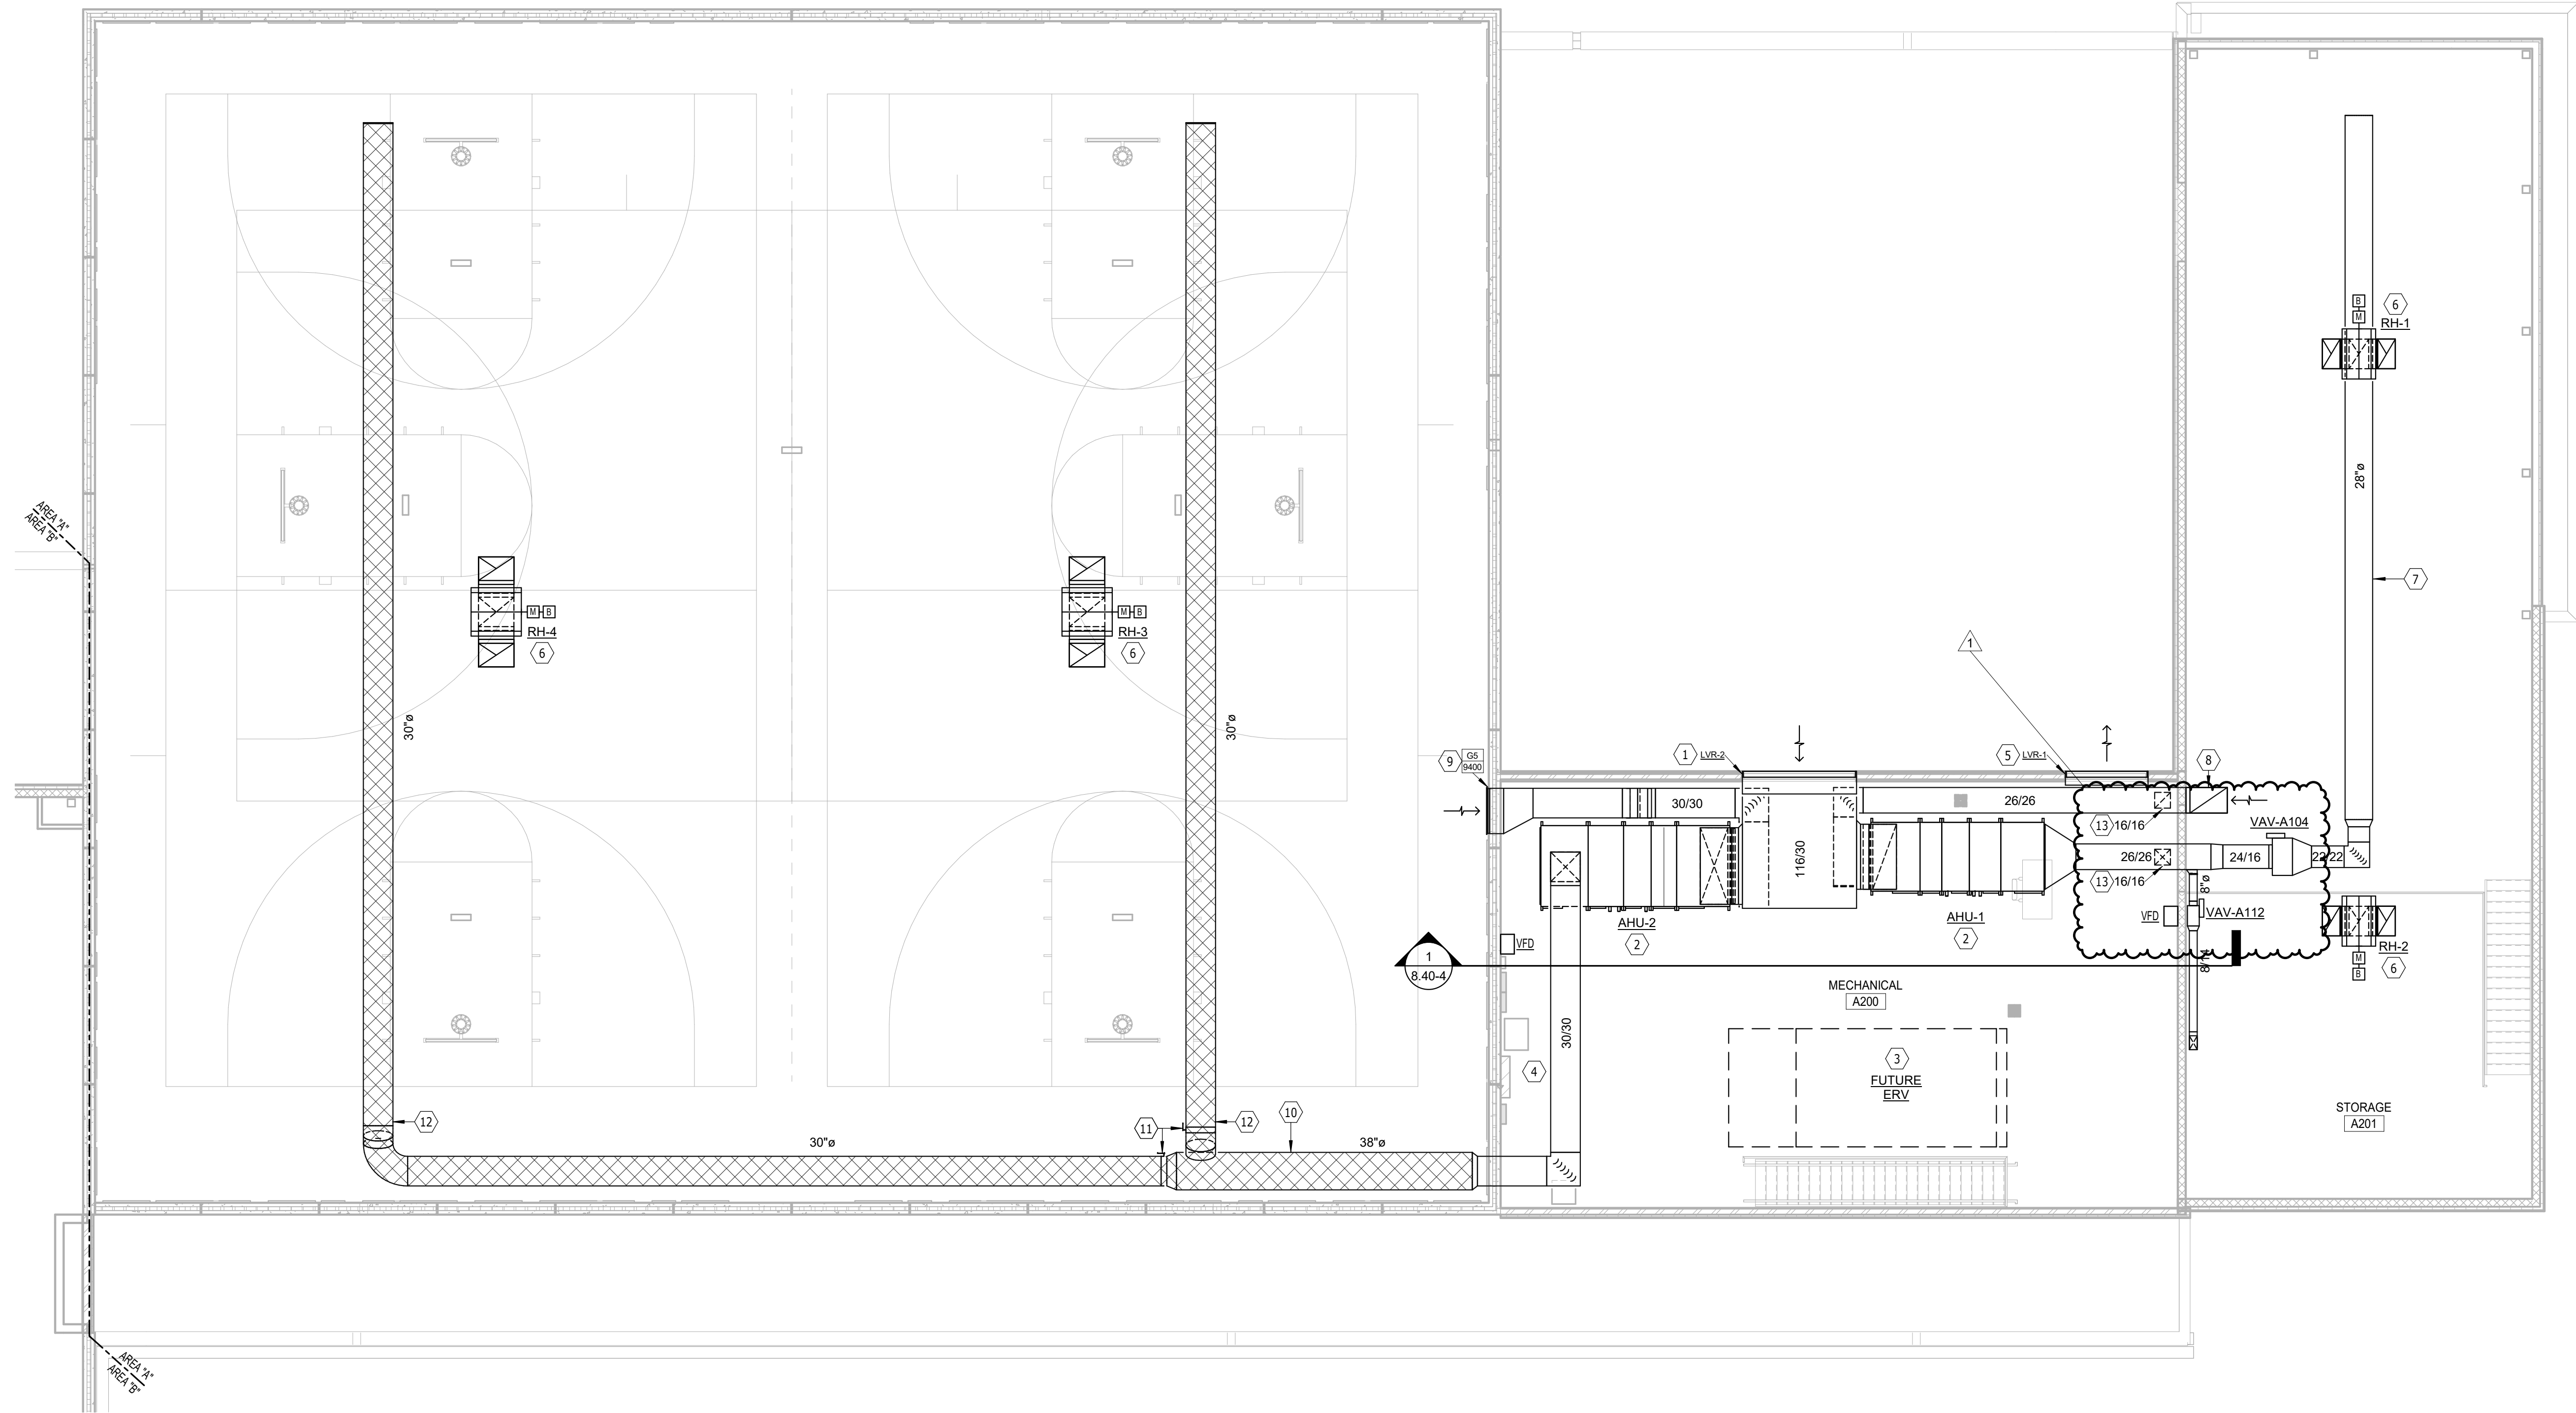

SECOND FLOOR PLAN - AREA A - VENTILATION & A/C

SCALE 0 4 8 12 16

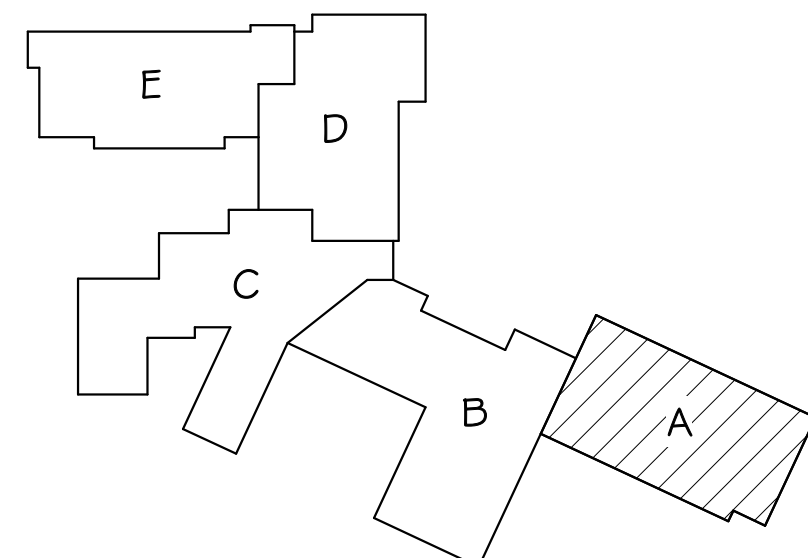


KEYPLAN

GENERAL SHEET NOTES

- A. THE CEILING SPACE AVAILABLE REQUIRES COORDINATION WITH OTHER TRADES. THE CONTRACTORS SHALL PROVIDE ALL OFFSETS AND RELOCATE AS REQUIRED TO COORDINATE THE INSTALLATION OF ALL MATERIALS AND EQUIPMENT WITH OTHER TRADES.
- B. ALL EXPOSED DUCTWORK SHALL BE DUCTMATE OR TDC. EXPOSED DUCTWORK SHALL BE PAINT GRIP TYPE EXCEPT IN MECHANICAL ROOMS.
- C. COORDINATE THERMOSTAT LOCATIONS WITH OTHER TRADES AND OWNER. THERMOSTATS IN COMMON AREAS SHALL BE FLAT PLATE STAINLESS STEEL SENSOR.
- D. RETURN AIR BOOTS SHALL BE CONSTRUCTED OF 24 GAUGE INSULATED DUCTWORK. SEE DETAIL. PROVIDE ON ALL RA AND TRANSFER AIR GRILLES.

VENTILATION NOTES


1. LOUVER WITH EXTENDED SILL WITH END DAMS. SEE DETAIL.
2. AIR HANDLING UNIT INSTALLED ON CONCRETE PAD BY THE GENERAL CONTRACTOR. PROVIDE WITH FLEXIBLE DUCT CONNECTIONS.
3. FUTURE ERV LOCATION.
4. ELECTRICAL EQUIPMENT SPACE. MAINTAIN REQUIRED CLEARANCES.
5. LOUVER FOR FUTURE MECHANICAL EQUIPMENT. CAP LOUVER AND INSULATE WITH 2" RIGID INSULATION.
6. RELIEF HOOD INSTALLED ON ROOF WITH FULLY INSULATED ROOF CURB. SEE DETAIL.
7. 60" OF FABRIC DUCT INSTALLED BELOW BAR JOISTS WITH BOTTOM OF DUCT AT 15' - 5" AFF. 4,200 CFM.
8. PROVIDE OPENINGS IN TOP OF DUCT.
9. SIDEWALL RETURN GRILLE.
10. HATCHED AREA SHOWS COMPLETE FABRIC DUCT SYSTEM DESIGNED BY FABRIC DUCT MANUFACTURER. 9,400 CFM TOTAL.
11. BALANCE DAMPER (TYP).
12. OFFSET FABRIC DUCT UP IN BETWEEN BAR JOISTS WITH BOTTOM OF DUCT AT 23' - 5" AFF.
13. SEE FIRST FLOOR PLAN FOR CONTINUATION.

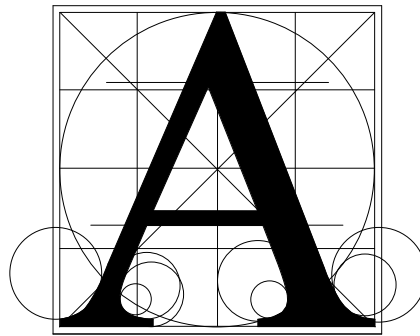

Architecture
Incorporated

415 South Main Avenue
P.O. Box 2140
Sioux Falls, South Dakota 57101
Phone: (605) 339-1711

815 St Joseph Street, Suite 203
P.O. Box 8047
Rapid City, South Dakota 57701
Phone: (605) 721-1158

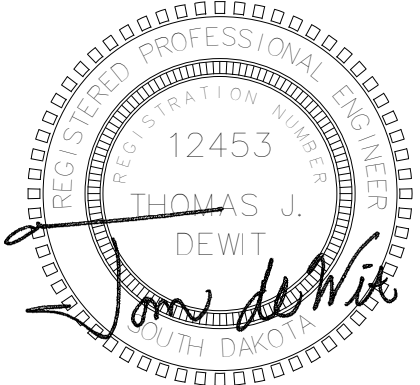

Associated
Consulting
Engineering,
Incorporated

340 S. Phillips Ave.
Sioux Falls, SD 57104

(605) 335-3720 Fax: 335-6220
E-mail: acei@associated.com

ACEI PROJ. #120085

Project
HARRISBURG HS - 9TH GRADE ACADEMY

Sheet Contents
SECOND FLOOR PLAN - AREA A - VENT. & A/C


number: 1002.2904.20
date: 11-19-21
revision:
drawn: DDK checked: Ttd

NO.	DATE	DESCRIPTION
1	12-10-21	ADD M2

8.40-2A




12/10/2021 10:16:01 AM

- GENERAL SHEET NOTES**
- A. THE CEILING SPACE AVAILABLE REQUIRES COORDINATION WITH OTHER TRADES. THE CONTRACTORS SHALL PROVIDE ALL OFFSETS AND RELOCATE AS REQUIRED TO COORDINATE THE INSTALLATION OF ALL MATERIALS AND EQUIPMENT WITH OTHER TRADES.
- B. ALL EXPOSED DUCTWORK SHALL BE DUCTMATE OR TDC. EXPOSED DUCTWORK SHALL BE PAINT GRIP TYPE EXCEPT IN MECHANICAL ROOMS.
- C. COORDINATE THERMOSTAT LOCATIONS WITH OTHER TRADES AND OWNER.
- D. THERMOSTATS IN COMMON AREAS SHALL BE FLAT PLATE STAINLESS STEEL SENSOR.
- E. RETURN AIR ROOTS SHALL BE CONSTRUCTED OF 24 GAUGE INSULATED DUCTWORK. SEE DETAIL. PROVIDE ON ALL R/A AND TRANSFER AIR GRILLES.
- VENTILATION NOTES**
1. UTILITY SET FAN ON ROOF. MOUNT FAN ON ROOF CURB.
2. 9"Ø E/A UP THRU ROOF CURB.
3. 9"Ø SPIRAL PIPE ROUTED DOWN THRU MEZZANINE FLOOR. SEAL JOINTS AIR TIGHT. PROVIDE WITH PAINT GRIP COATING.
4. AIR HANDLING UNIT INSTALLED ON CONCRETE PAD BY THE GENERAL CONTRACTOR. PROVIDE WITH FLEXIBLE DUCT CONNECTIONS.
5. SPIRAL S/A DUCT WITH REGISTERS MOUNTED AT A 35° DOWN ANGLE. SPIRAL DUCT SHALL BE MOUNTED BETWEEN ROOF JOISTS. PROVIDE WITH PAINT GRIP COATING.
6. 16"Ø E/A DUCT WITH ELBOW UP. DUCT SHALL NOT EXTEND BELOW BOTTOM OF ROOF JOIST. PROVIDE WITH PAINT GRIP COATING.
7. PRV INSTALLED ON ROOF WITH FULLY INSULATED ROOF CURB.
8. 8"Ø S/A DOWN FROM ROOF JOISTS TO LOWER LEVEL. PROVIDE WITH PAINT GRIP COATING.
9. LOUVER WITH EXTENDED SILL WITH END DAMS. SEE DETAIL.
10. DUCT SHALL HAVE 2" ACOUSTICAL LINER. DUCT DIMENSIONS CALLED OUT OVERSIZED TO ACCOMMODATE 2" LINER.
11. 7"Ø DN TO WELDING EXHAUST HOOD. SEE DETAIL. TYPICAL OF 11.
12. 4"Ø SPIRAL E/A DN TO DUST COLLECTOR CONNECTION WITH BLAST GATE. PROVIDE RIGID HOSE CONNECTION TO OWNER PROVIDED EQUIPMENT.
13. 6"Ø SPIRAL E/A DN TO FLOOR SWEEP WITH BLAST GATE.
14. 12"Ø SPIRAL DUST COLLECTOR E/A DN TO DUST COLLECTOR.
15. WELDING EXHAUST DUCT SHALL BE MOUNTED BELOW ROOF JOISTS AND CONSTRUCTED TO A MINIMUM -5"WC. PROVIDE WITH PAINT GRIP COATING.
16. DUCTLESS SPLIT SYSTEM CONDENSING UNIT MOUNTED ON ROOF CURB. ROUTE RS/R/L PIPING THRU CURB AND DOWN TO ASSOCIATED INDOOR UNIT.
17. FAN POWERED VAV TERMINAL UNIT WITH RE-HEAT COIL INSTALLED ABOVE CEILING. PROVIDE SOUND ATTENUATION BOOT. (TYP)
18. OFFSET DUCTWORK BELOW JOISTS.
19. 16"Ø SPIRAL ROUTED BETWEEN DOUBLE TEE STRUCTURE. PROVIDE WITH 2" ACOUSTICAL LINER. BALANCE TO 470 CFM.
20. 16"Ø SPIRAL ROUTED BETWEEN DOUBLE TEE STRUCTURE. PROVIDE WITH 2" ACOUSTICAL LINER. BALANCE TO 475 CFM.
21. VFD FOR WELDING EXHAUST FAN EF-C113. COORDINATE EXACT LOCATION WITH EQUIPMENT LAYOUT AND ELECTRICAL CONTRACTOR.
22. VFD FOR TRANSFER FAN TF-C113. COORDINATE EXACT LOCATION WITH EQUIPMENT LAYOUT AND ELECTRICAL CONTRACTOR.
23. 8"Ø SPIRAL DUST COLLECTOR E/A DN TO APPROX. 9' A.F.F. AND MINTD HORIZONTALLY ALONG WALL.
24. MECHANICAL PENETRATIONS INTO OR OUT OF A STORM SHELTER SHALL BE PROTECTED FROM INCOMING PROJECTILES BY CONCRETE Baffles PER ICC 500. VERIFY AND COORDINATE Baffle OPENING DIMENSIONS W/STRUCTURAL.
25. ROUTE DUCTWORK IN JOIST SPACE.
26. DUST COLLECTOR DUCTWORK CONSTRUCTED TO -10 IN WC.
27. FIRE DAMPER. INSTALL PER MANUFACTURERS INSTALLATION INSTRUCTIONS.

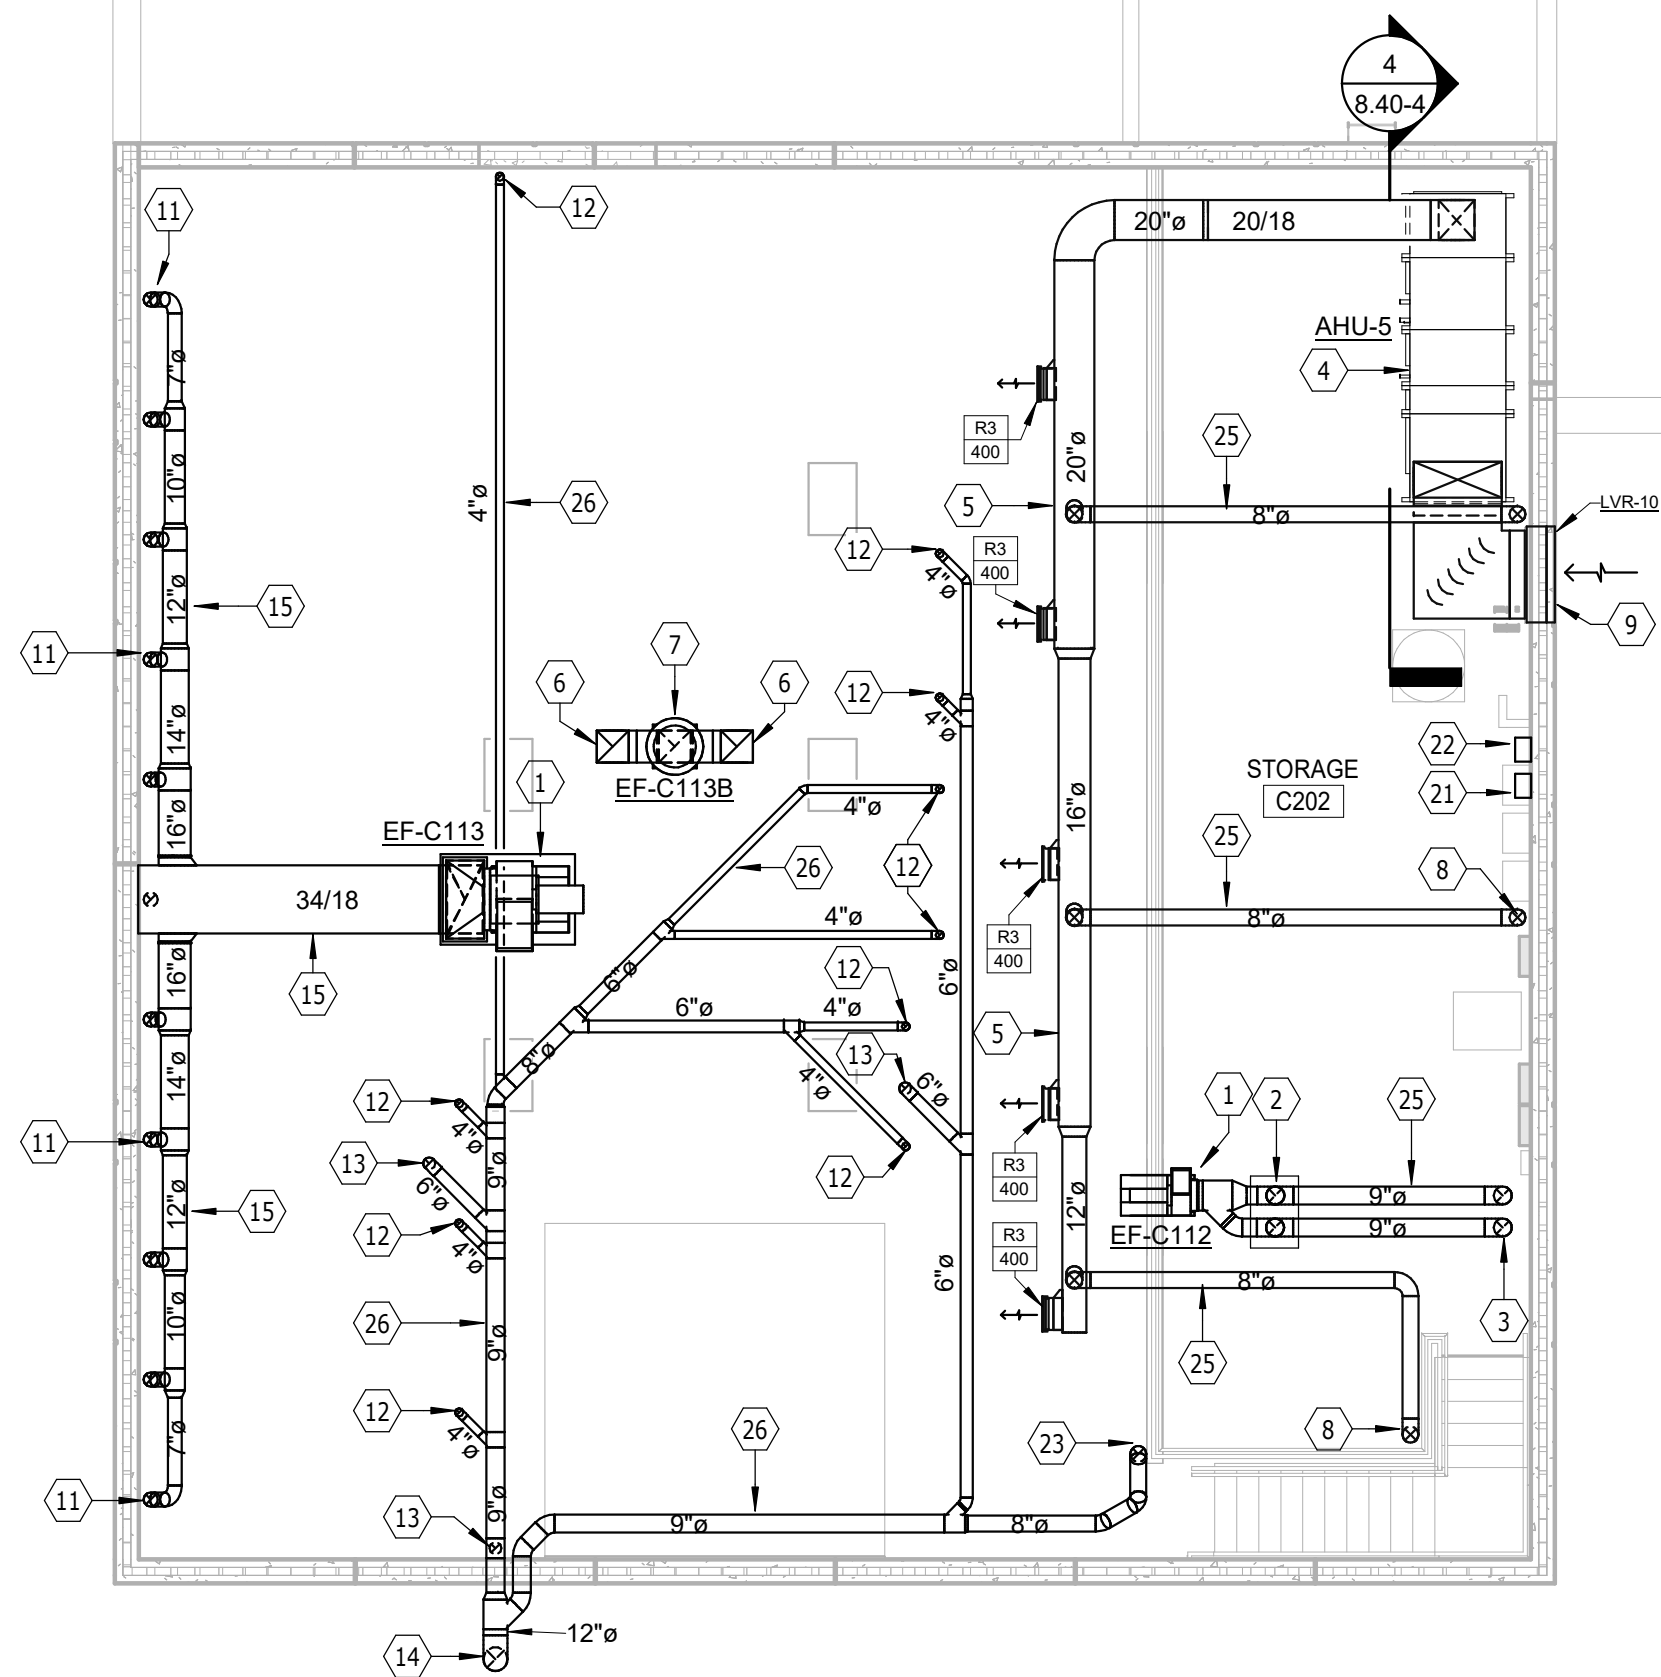

SECOND FLOOR PLAN - AREA C - VENTILATION & A/C


SCALE 0 4 8 12 16

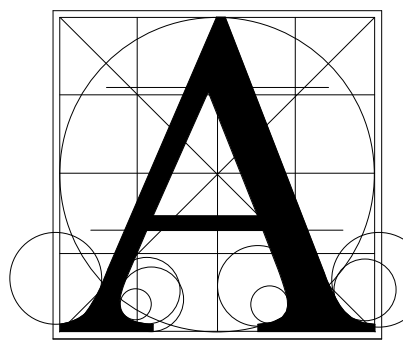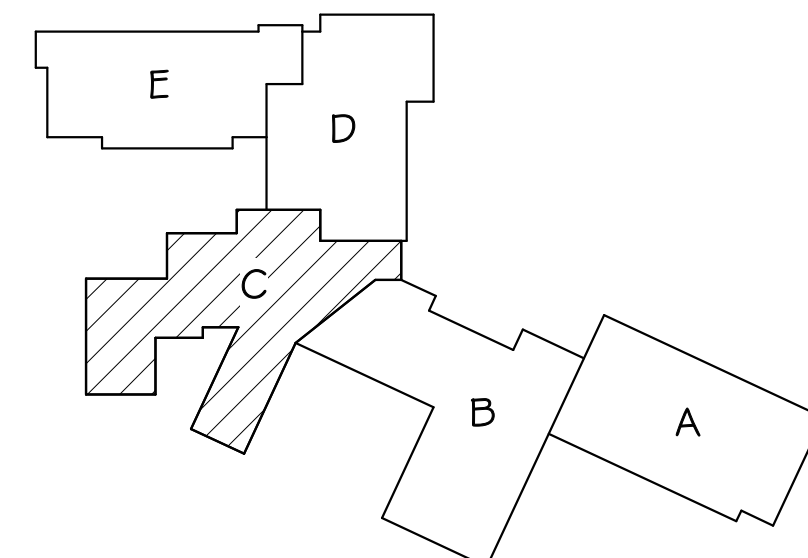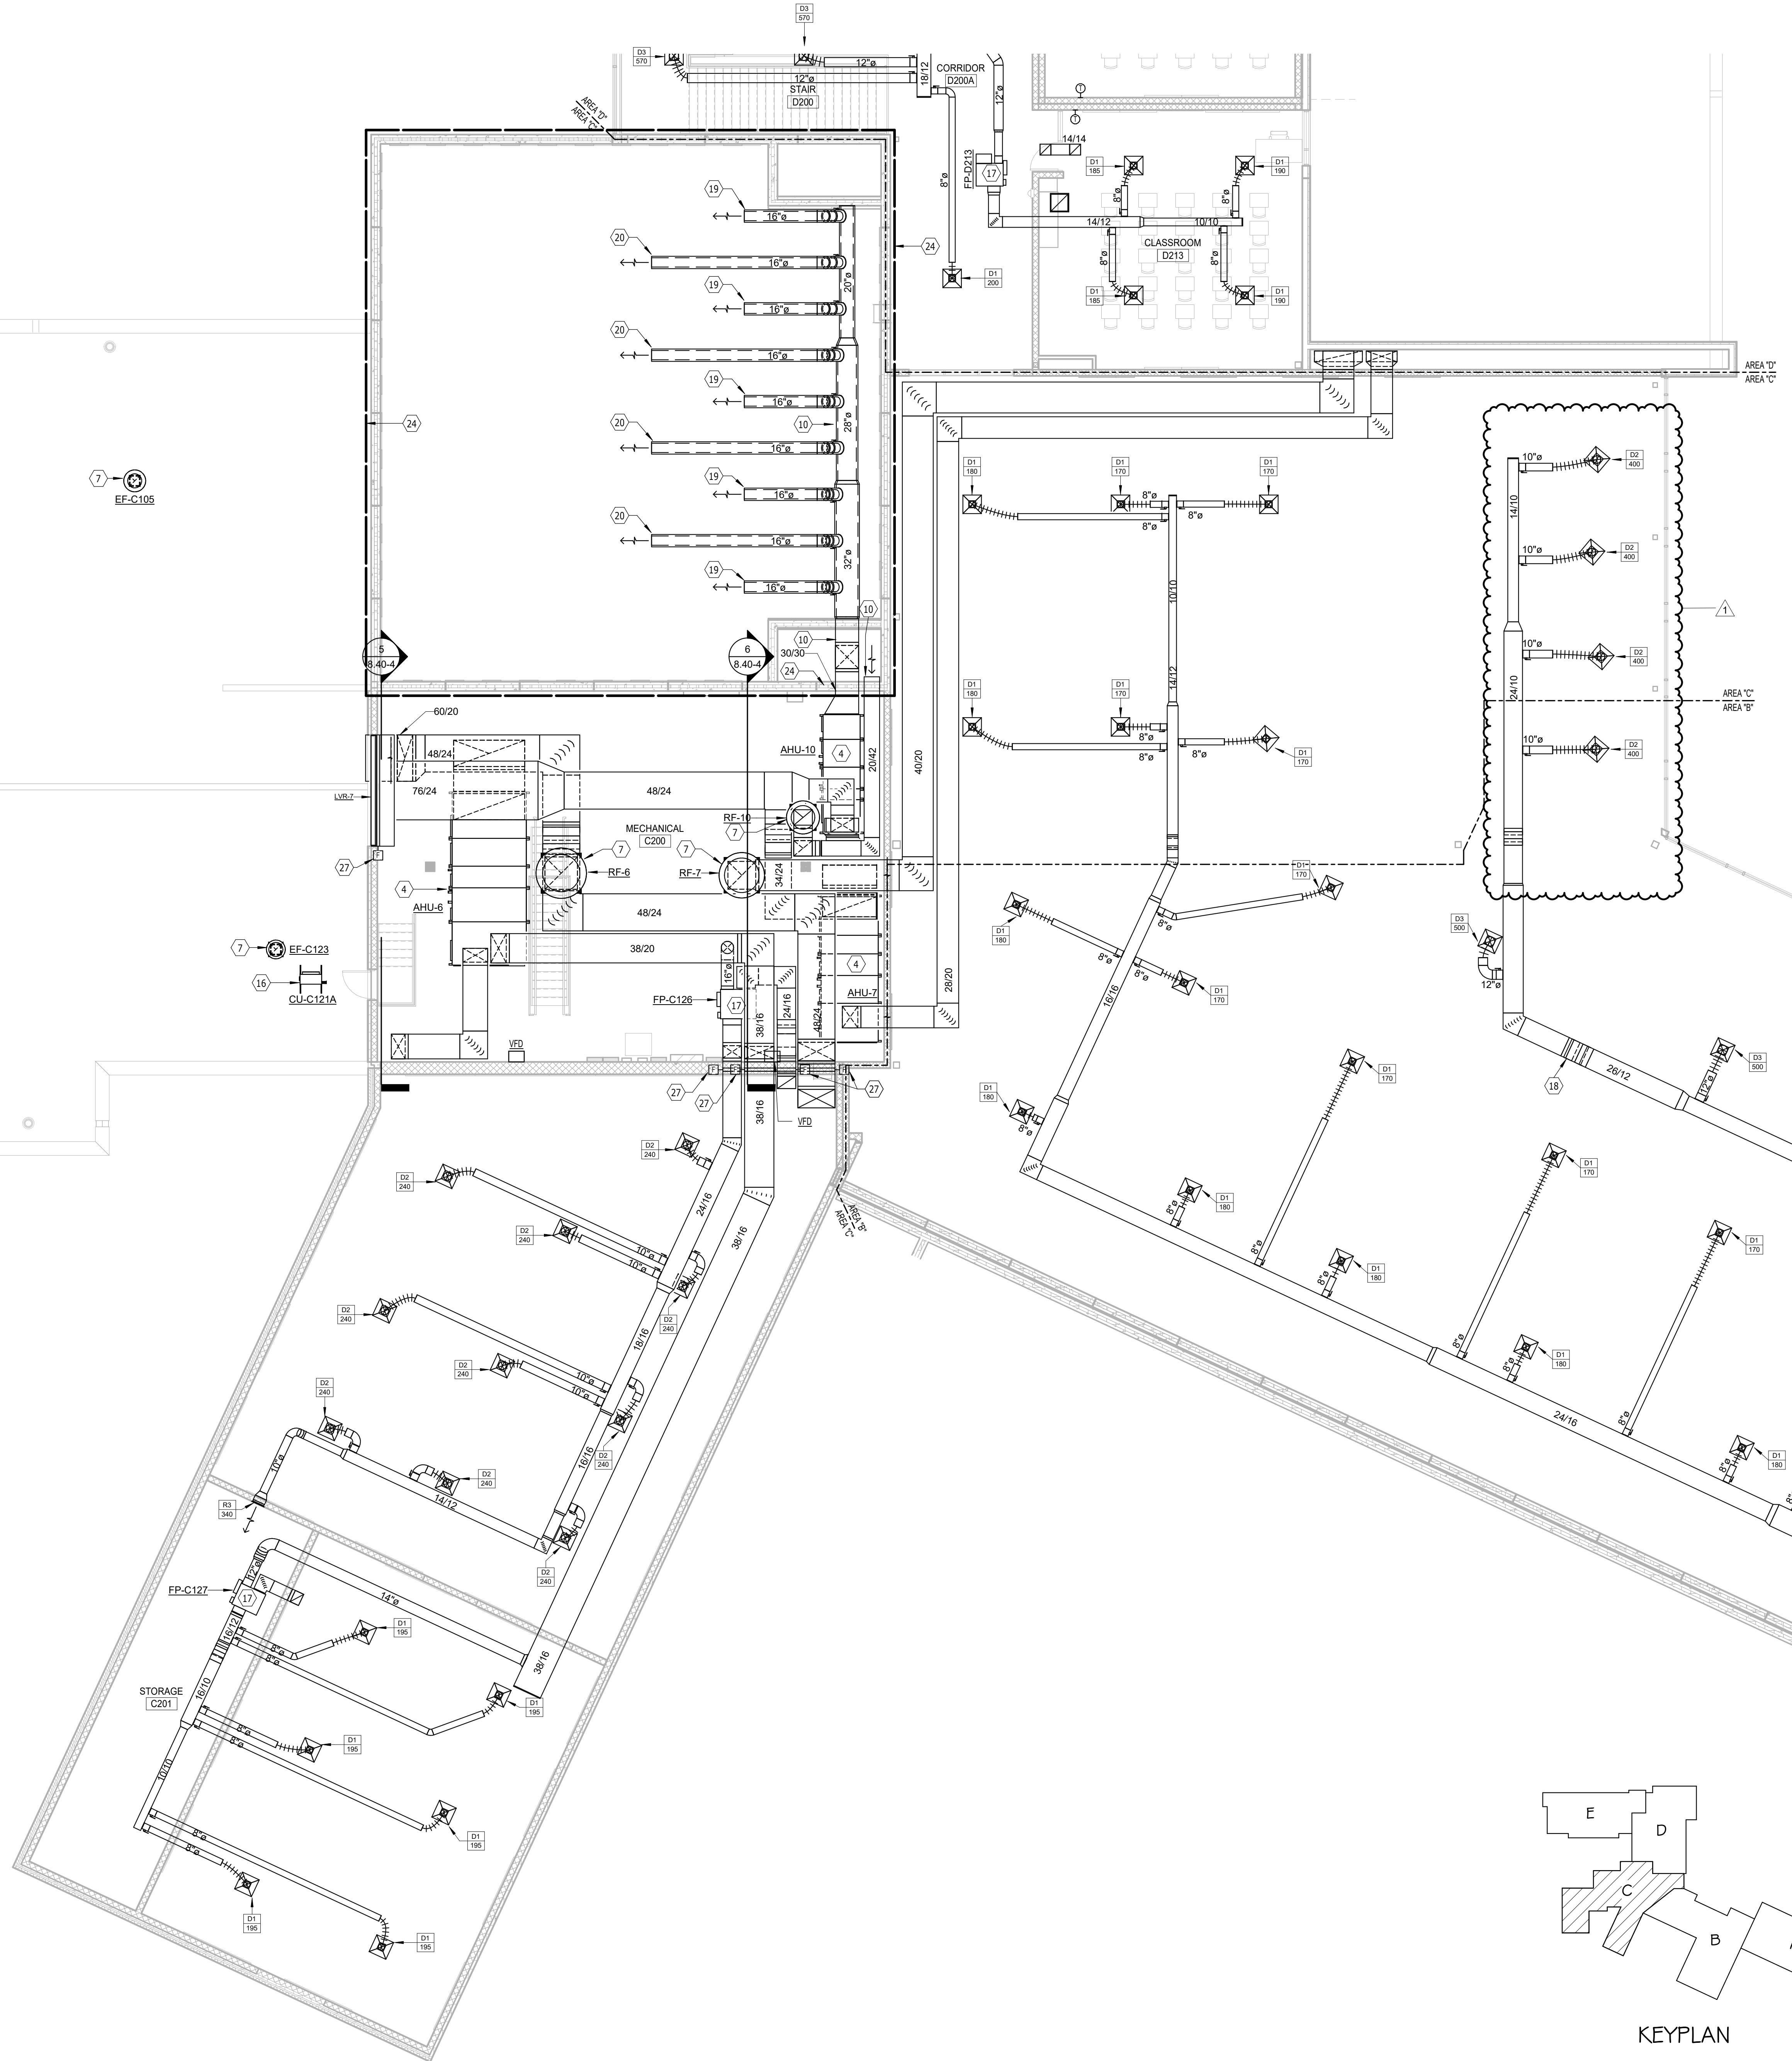

**Architecture
Incorporated**

415 South Main Avenue
P.O. Box 2140
Sioux Falls, South Dakota 57101
Phone: (605) 339-1711

815 St Joseph Street, Suite 203
P.O. Box 8047
Rapid City, South Dakota 57701
Phone: (605) 721-1158

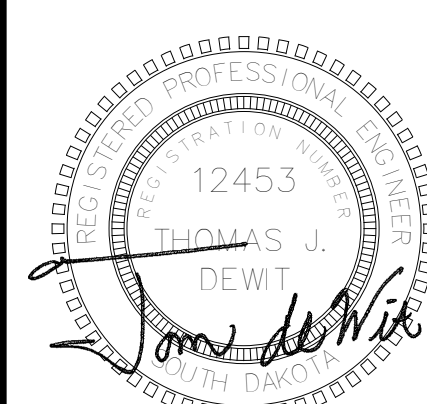

**A associated
Consulting
Engineering,
Incorporated**

340 S. Phillips Ave.
Sioux Falls, SD 57104
(605) 335-3720
Fax: 335-6220
E-mail: acei@associated.net
ACEI PROJ. #120085



HARRISBURG HS - 9TH GRADE ACADEMY

SECOND FLOOR PLAN - AREA C - VENT. & A/C


Project	number	1002.2904.20
date	11-19-21	
revision		
drawn	NJH	checked Td
NO.	DATE	DESCRIPTION
1	12-10-21	ADD M2

8.40-2C

12/9/2021 5:15:38 PM

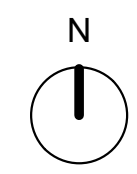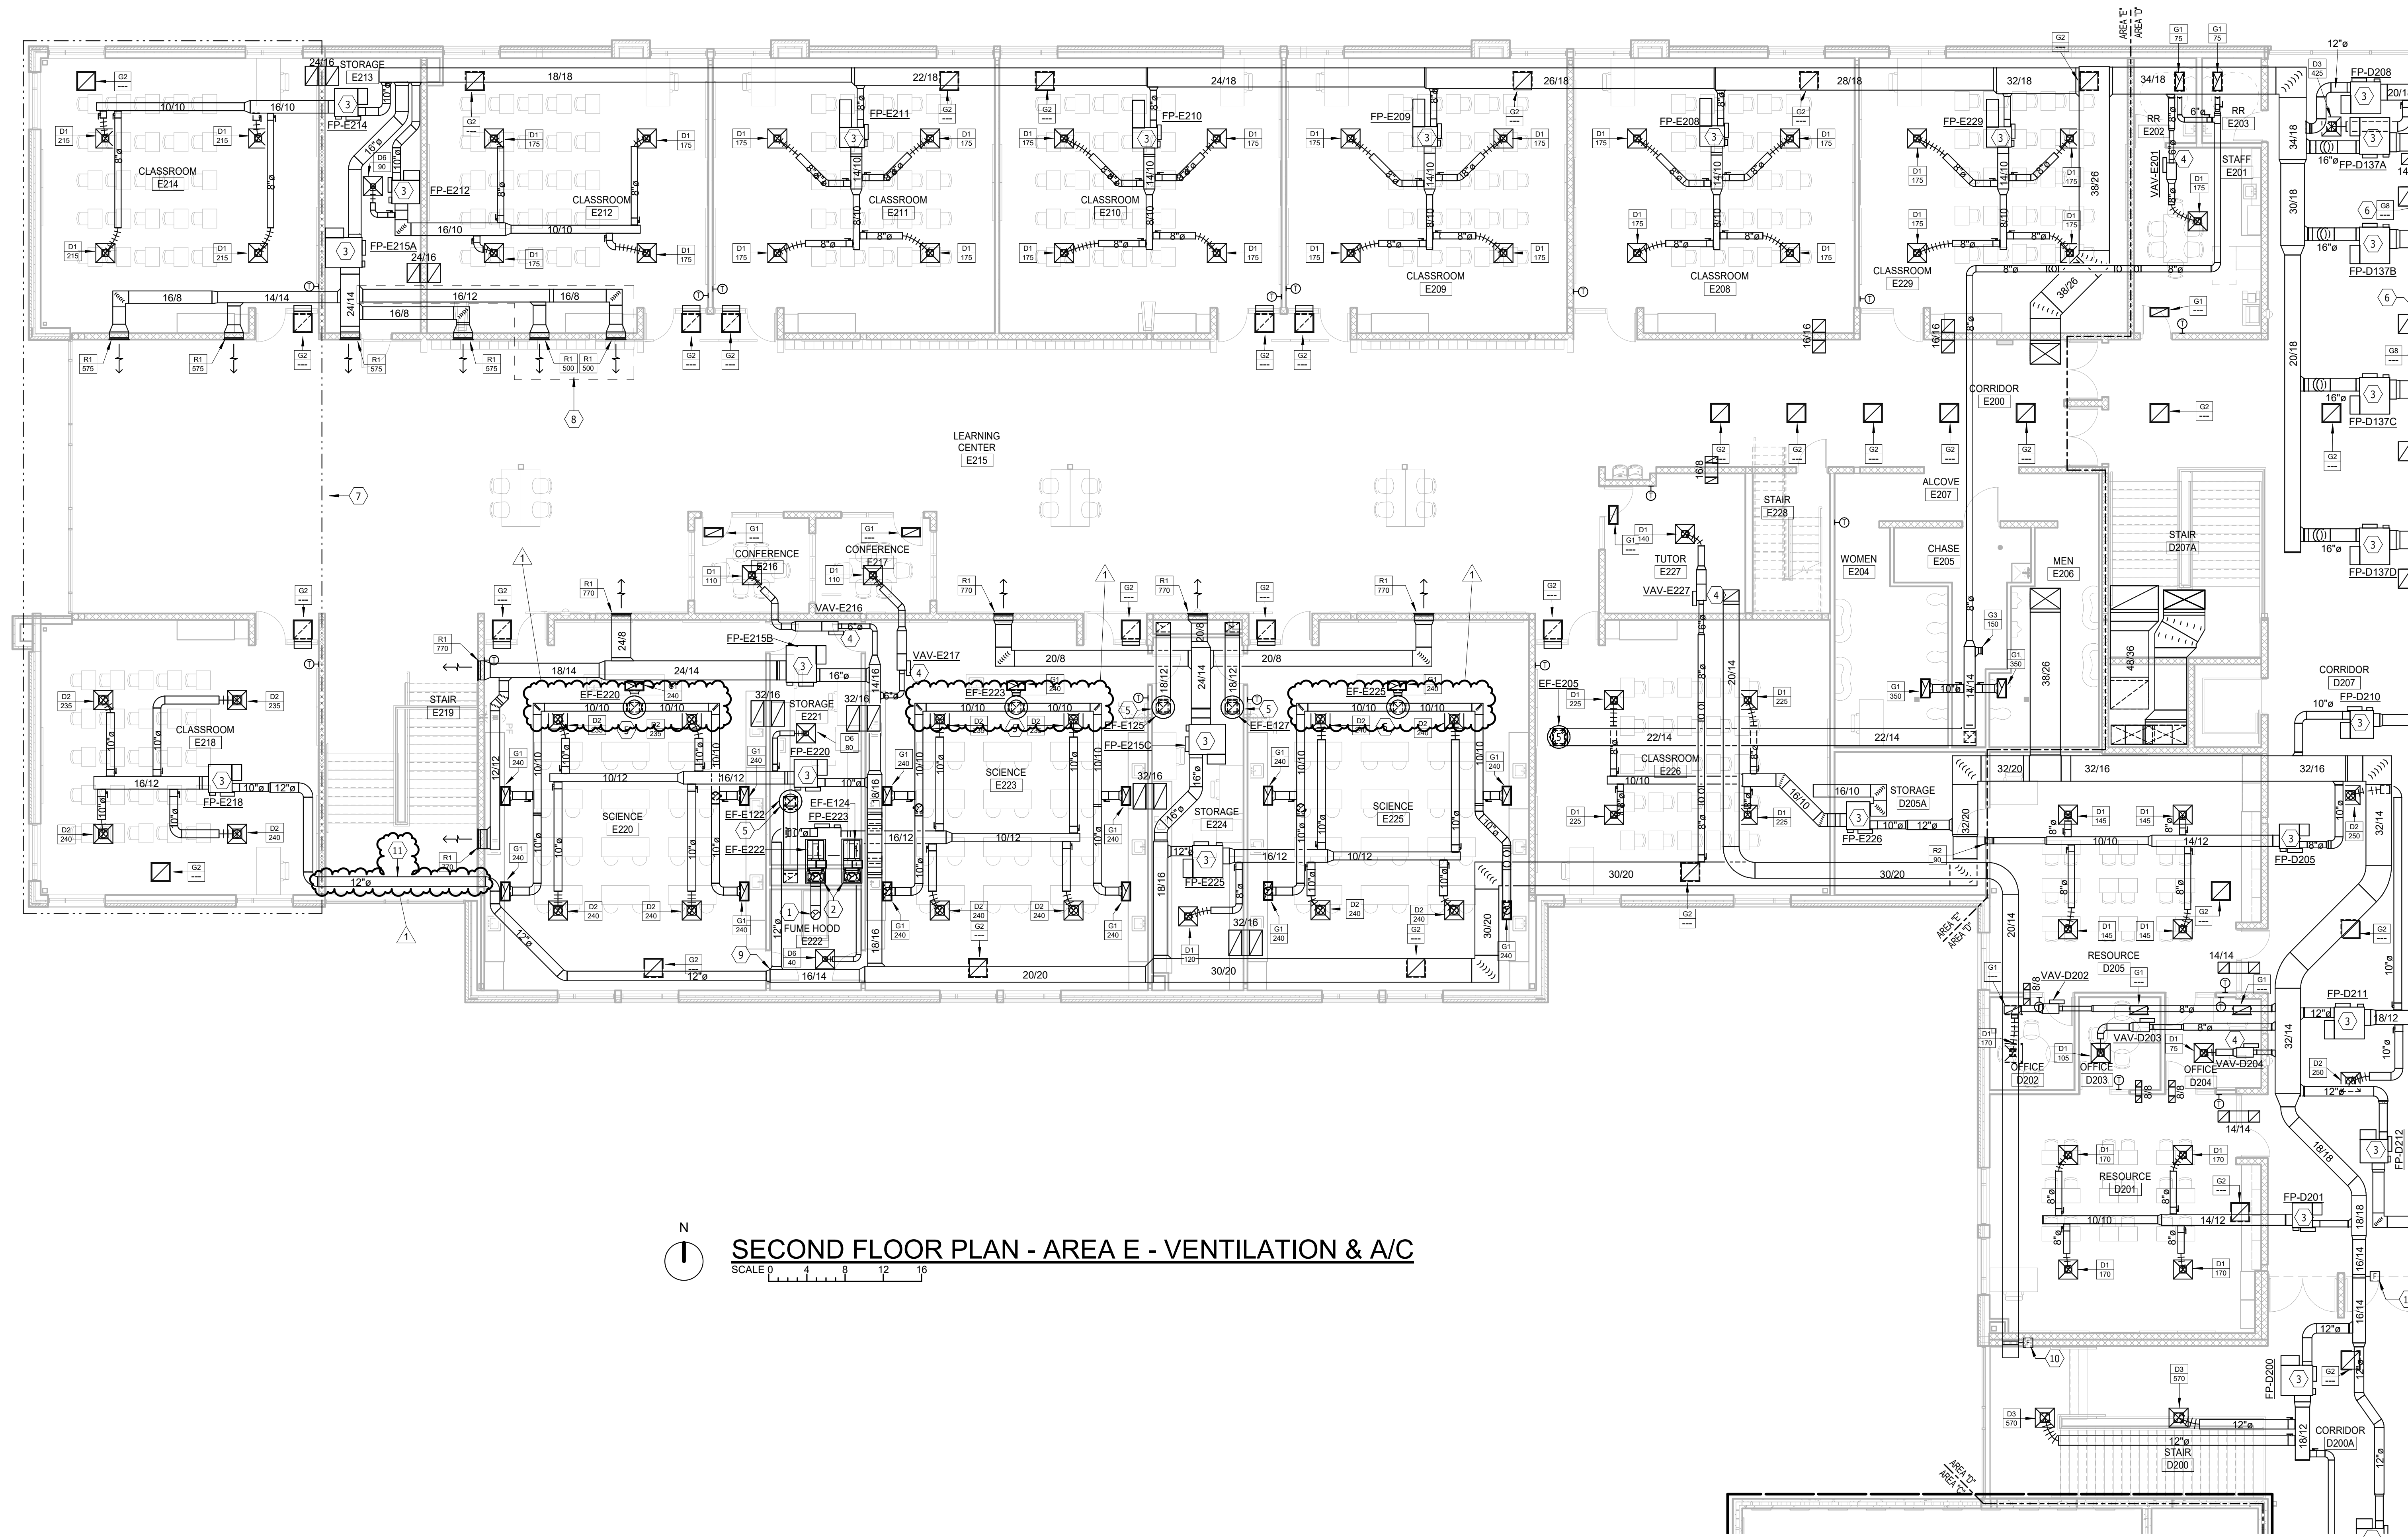


SECOND FLOOR PLAN - AREA E - VENTILATION & A/C
SCALE: 1" = 12'-0"

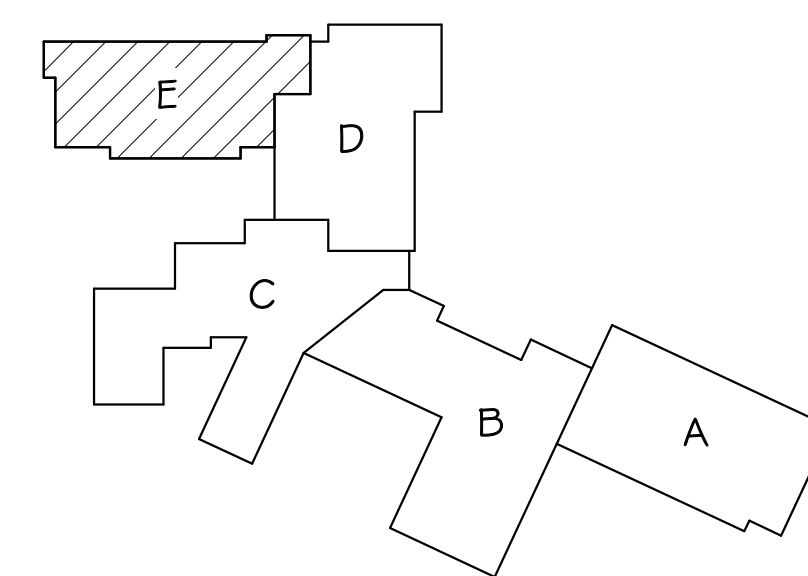


KEYPLAN

- GENERAL SHEET NOTES**
- THE CEILING SPACE AVAILABLE REQUIRES COORDINATION WITH OTHER TRADES. THE CONTRACTORS SHALL PROVIDE ALL OFFSETS AND RELOCATE AS REQUIRED TO COORDINATE THE INSTALLATION OF ALL MATERIALS AND EQUIPMENT WITH OTHER TRADES.
 - ALL EXPOSED DUCTWORK SHALL BE DUCTMATE OR TDC. EXPOSED DUCTWORK SHALL BE PAINT GRIP TYPE EXCEPT IN MECHANICAL ROOMS. COORDINATE THERMOSTAT LOCATIONS WITH OTHER TRADES AND OWNER. THERMOSTATS IN COMMON AREAS SHALL BE FLAT PLATE STAINLESS STEEL SENSOR.
 - RETURN AIR BOOTS SHALL BE CONSTRUCTED OF 24 GAUGE INSULATED DUCTWORK. SEE DETAIL. PROVIDE ON ALL RA AND TRANSFER AIR GRILLES.
- VENTILATION NOTES**
- 12"Ø 316 S.S. 18 GAUGE E/A DN TO FUME HOOD. SEAL JOINTS AIR TIGHT. FUME HOOD BY G.C.
 - UTILITY SET FAN ON ROOF. MOUNT FAN ON ROOF CURB.
 - FAN POWERED VAV TERMINAL UNIT WITH RE-HEAT COIL INSTALLED ABOVE CEILING. PROVIDE SOUND ATTENUATION BOOT, (TYP)
 - SHUT OFF TYPE VAV TERMINAL WITH RE-HEAT COIL INSTALLED ABOVE CEILING. (TYP)
 - PRV INSTALLED ON ROOF WITH FULLY INSULATED ROOF CURB.
 - SIDEWALL RETURN AIR GRILLE FOR AIR TRANSFER INTO IN BLOCK COURSE APPROX. 25'-8" AFF. PROVIDE SOUND BOOT ELBOW UP IN PLENUM SPACE.
 - MECHANICAL ITEMS INSIDE DASHED AREA ARE PART OF ADD ALT #1. OMIT FP-E114, FP-E118, FP-E214, FP-E218 AND ASSOCIATED DUCTWORK AND ACCESSORIES FROM BASE BID.
 - MECHANICAL ITEMS INSIDE DASHED AREA ARE PART OF BASE BID. OMIT IF ALT #1 IS ACCEPTED.
 - CAP AT THIS LOCATION FOR BASE BID.
 - REFRIGERANT INSTALL PER MANUFACTURER'S INSTALLATION INSTRUCTIONS.
 - EXPOSED SPIRAL DUCT THRU CORRIDOR SHALL BE DOUBLE WALL CONSTRUCTION.

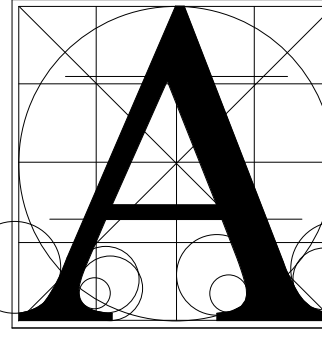

Architecture Incorporated
415 South Main Avenue
P.O. Box 2140
Sioux Falls, South Dakota 57101
Phone: (605) 339-1711

815 St Joseph Street, Suite 203
P.O. Box 8047
Rapid City, South Dakota 57701
Phone: (605) 721-1158

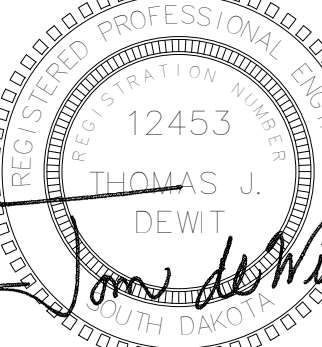

Associated Consulting Engineering, Incorporated
340 S. Phillips Ave.
Sioux Falls, SD 57104
(605) 335-3720
Fax: 335-6220
E-mail: acei@aceinet.com
ACEI PROJ. #120085


Project **HARRISBURG HS - 9TH GRADE ACADEMY**

Second Floor Plan - Area E - Ventilation & A/C


number: 1002.2904.20
date: 11-19-21
revision:
drawn: NJH checked: Td
NO. DATE DESCRIPTION
1 12-10-21 ADD M2

8.40-2E

12/10/2021 2:30:20 PM

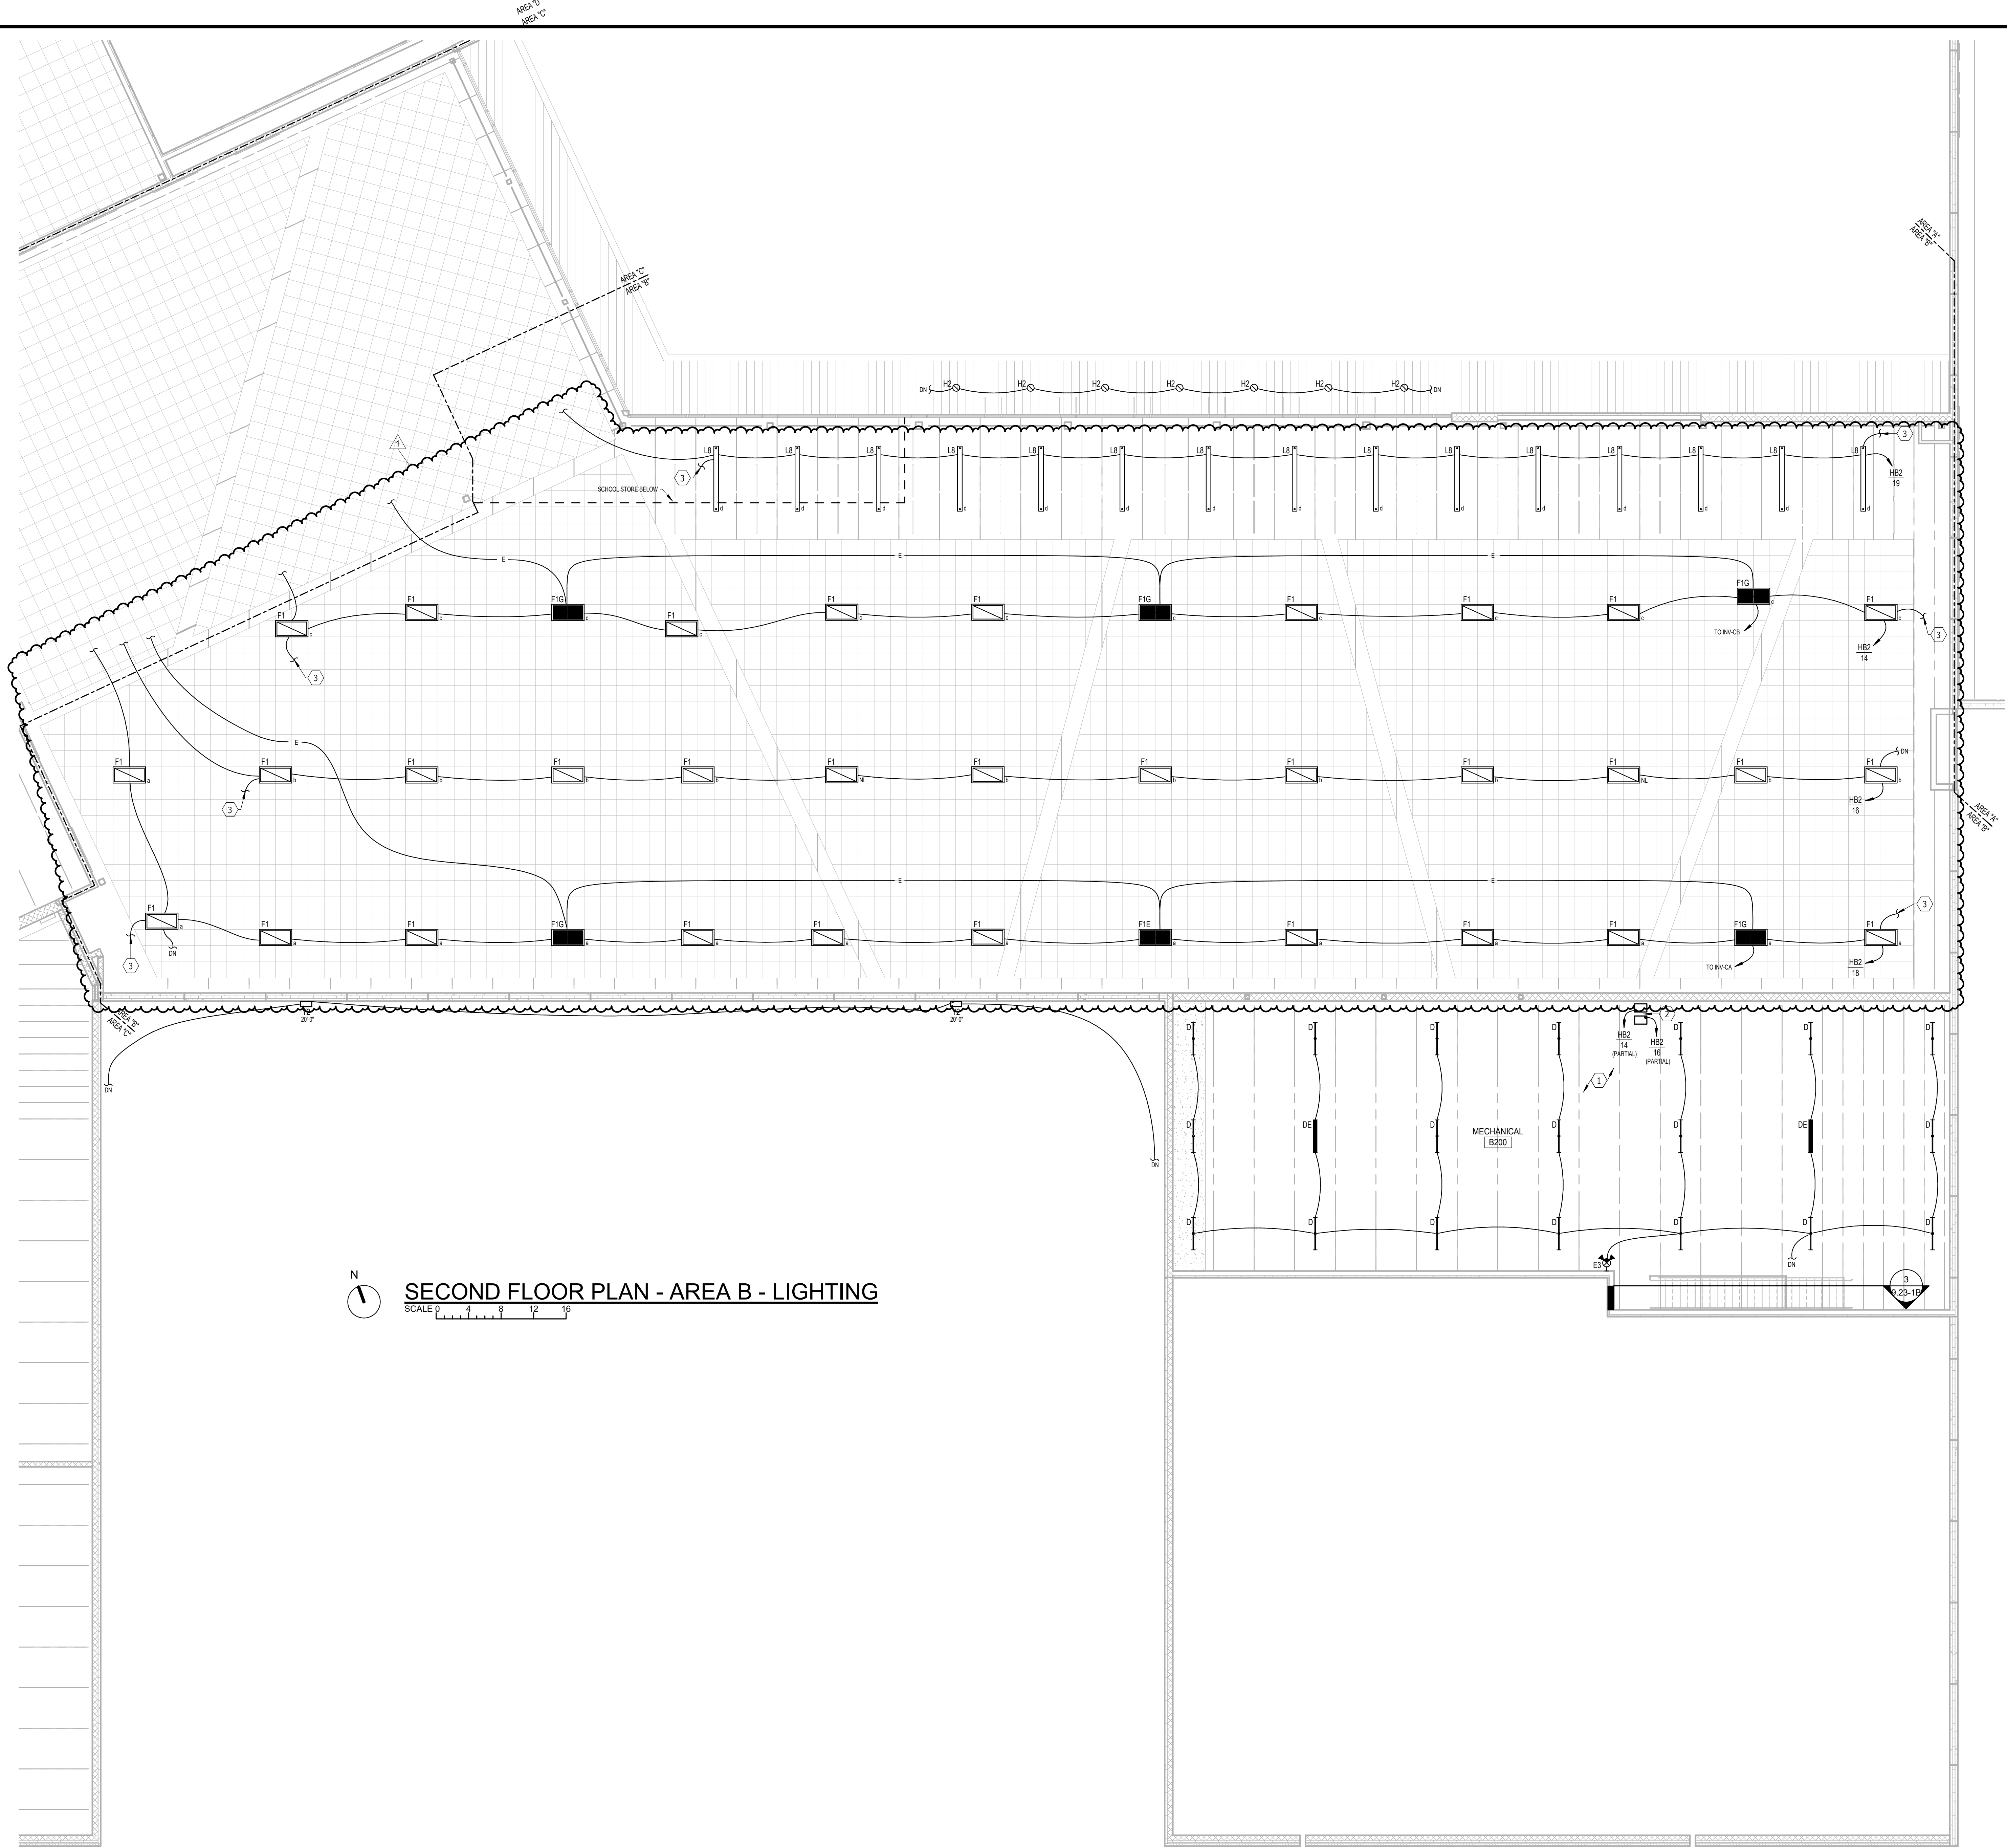

N
SECOND FLOOR PLAN - AREA B - LIGHTING
SCALE 0 4 8 12 16

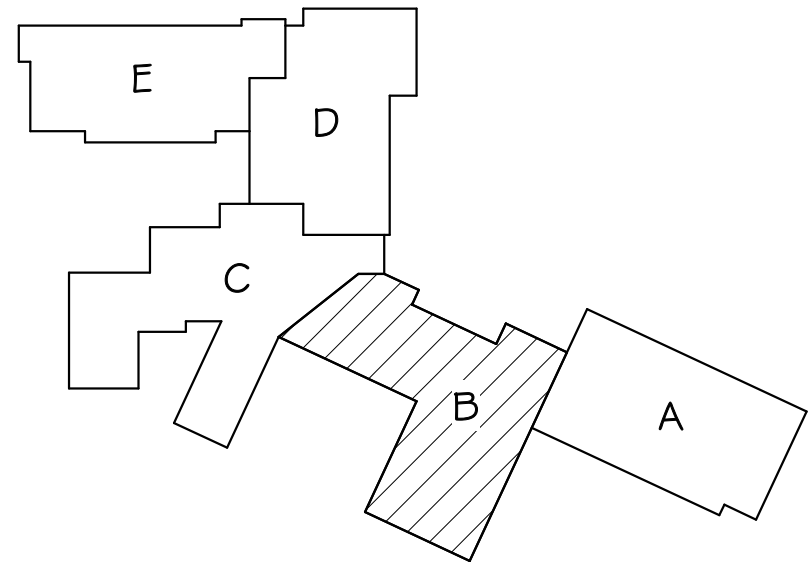


KEYPLAN

ELECTRICAL NOTES

- 1 COORDINATE LIGHTING INSTALLATION WITH MECHANICAL EQUIPMENT, SHIFT AS NECESSARY.
- 2 EMERGENCY LIGHTING INVERTERS "INV-CA" (EQUAL TO EMERGI-LITE EMU-720) AND "INV-CB" (EQUAL TO EMERGI-LITE EMU-720).
- 3 TO SWITCH AT ENTRY TO ROOM.

GENERAL SHEET NOTES


- A. SEE AV DRAWINGS (BY REACH COMMUNICATIONS) FOR ADDITIONAL SCOPE WORK.

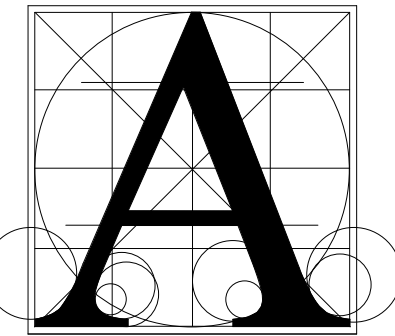

Architecture
Incorporated

415 South Main Avenue
P.O. Box 2140
Sioux Falls, South Dakota 57101
Phone: (605) 339-1711

815 St Joseph Street, Suite 203
P.O. Box 8047
Rapid City, South Dakota 57701
Phone: (605) 721-1158

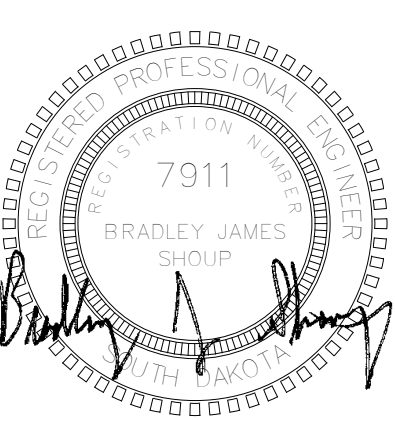

Associated
Consulting
Engineering,
Incorporated

340 S. Phillips Ave.
Sioux Falls, SD 57104

(605) 335-3720 Fax: 335-6220
E-mail: acei@gsnet.net

ACEI PROJ. #120085

Project
HARRISBURG HS - 9TH GRADE ACADEMY

Sheet Contents
SECOND FLOOR PLAN - AREA B - LIGHTING

number: 1002.2904.20

date: 11-19-21



revision:

drawn: ADP checked: BJS

NO. DATE DESCRIPTION



1 12-10-21 ADD E2

12/10/2021 2:30:22 PM

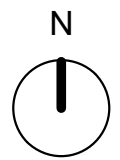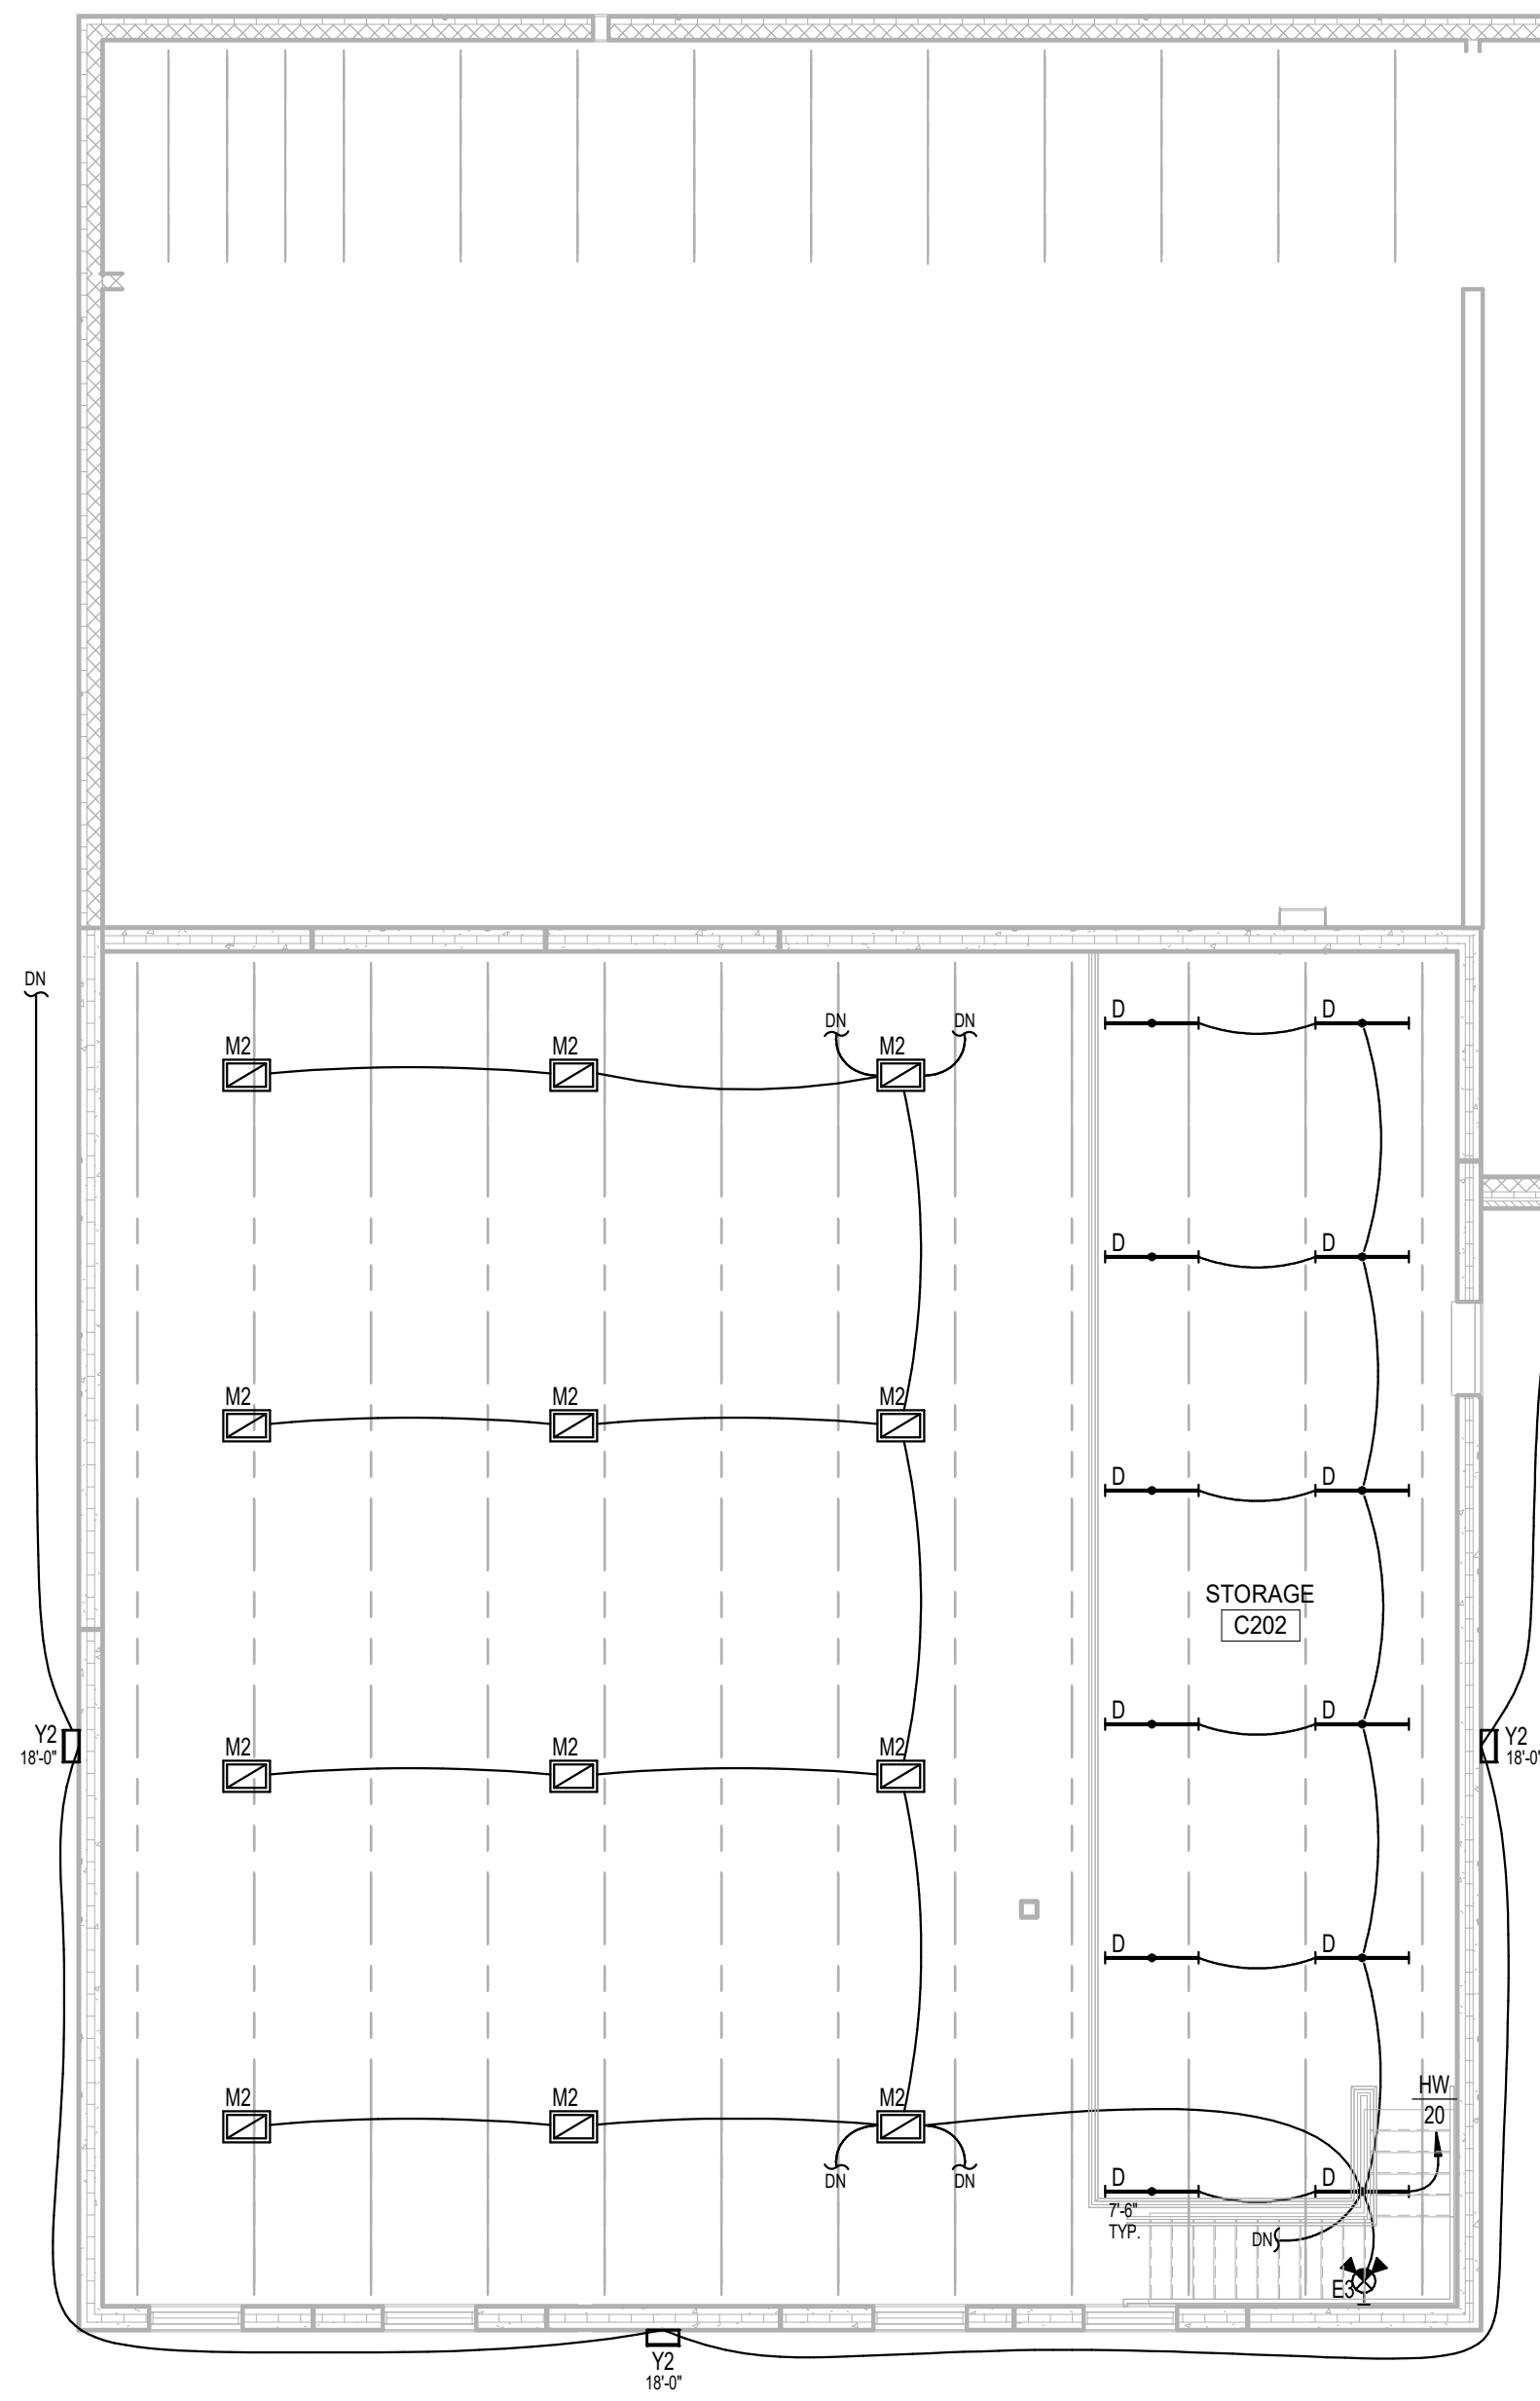

SECOND FLOOR PLAN - AREA C - LIGHTING

SCALE 0 4 8 12 16

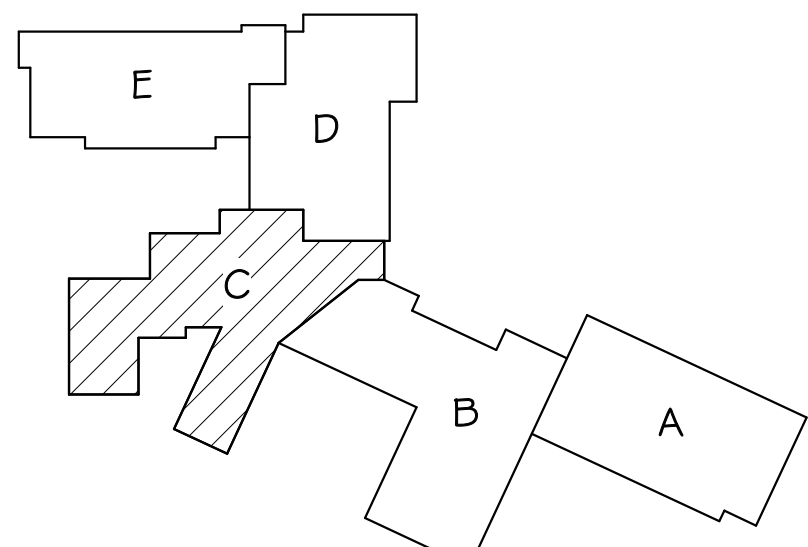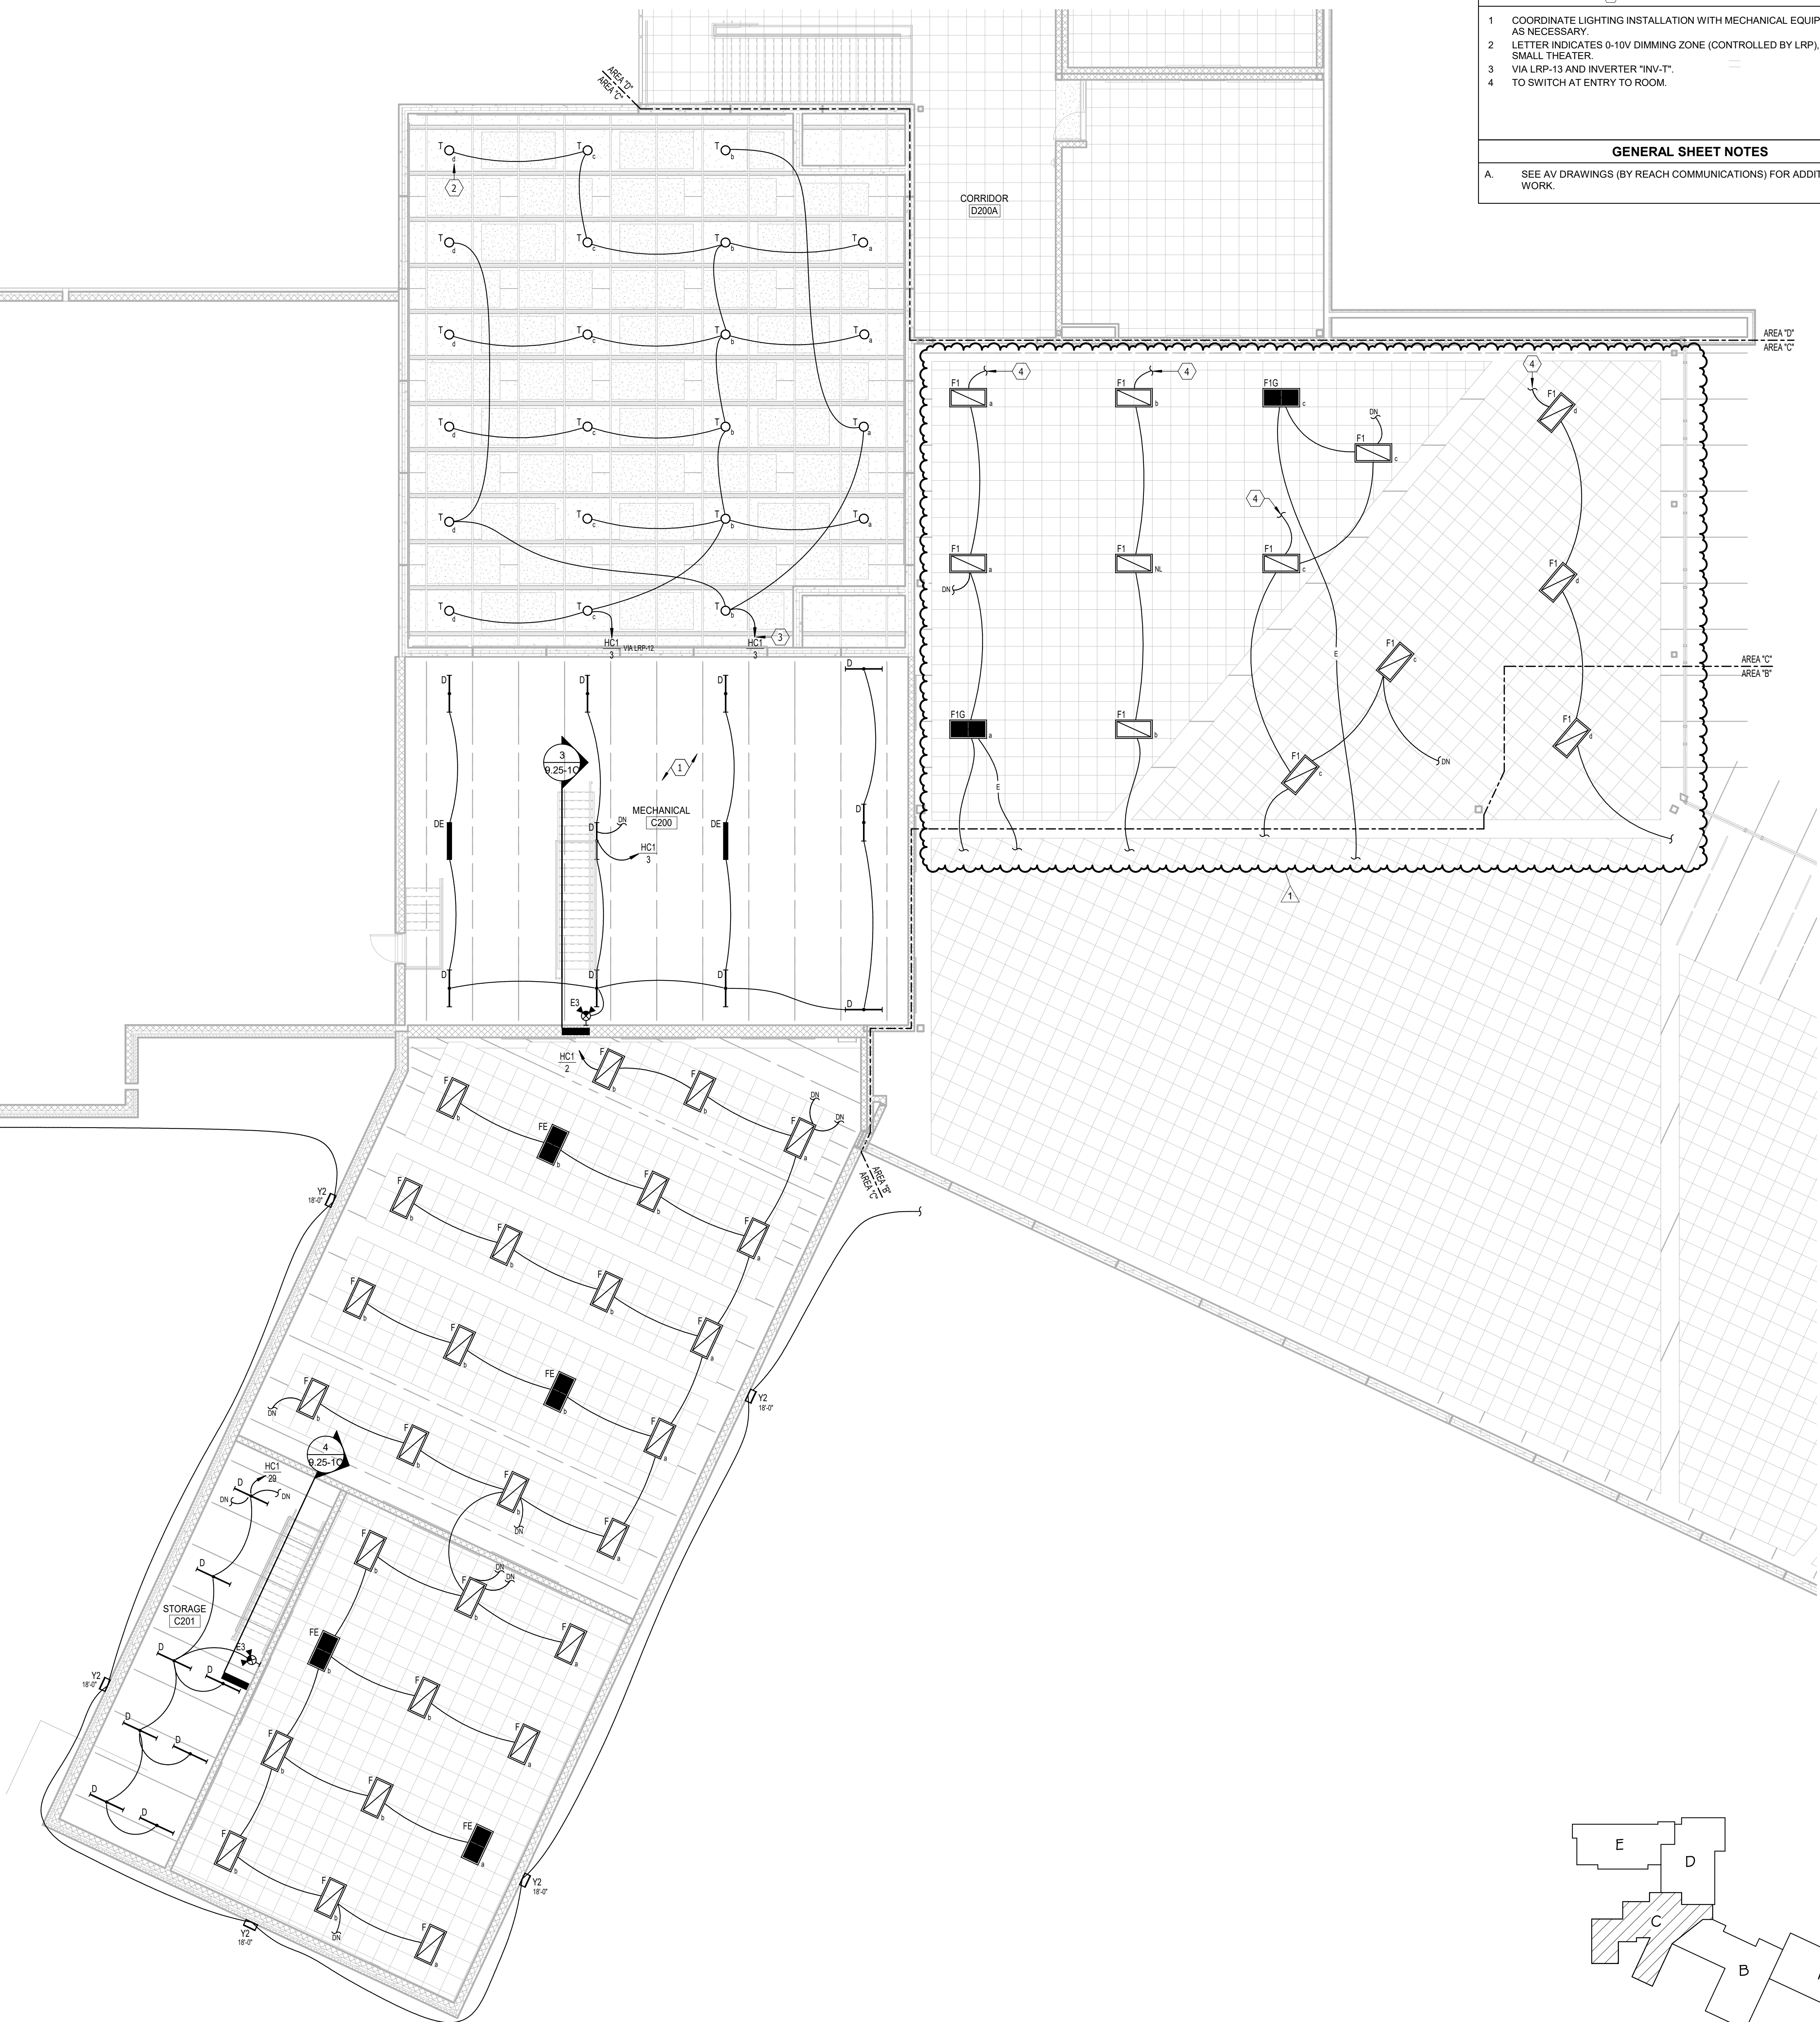


KEYPLAN

ELECTRICAL NOTES

- 1 COORDINATE LIGHTING INSTALLATION WITH MECHANICAL EQUIPMENT, SHIFT AS NECESSARY.
- 2 LETTER INDICATES 0-10V DIMMING ZONE (CONTROLLED BY LRP), TYPICAL IN SMALL THEATER.
- 3 VIA LRP-13 AND INVERTER "INV-T".
- 4 TO SWITCH AT ENTRY TO ROOM.

GENERAL SHEET NOTES


- A SEE AV DRAWINGS (BY REACH COMMUNICATIONS) FOR ADDITIONAL SCOPE WORK.

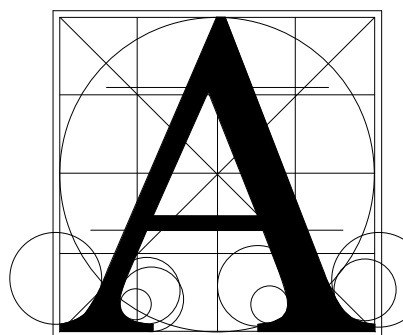

Architecture
Incorporated

415 South Main Avenue
P.O. Box 2140
Sioux Falls, South Dakota 57101
Phone: (605) 339-1711

815 St Joseph Street, Suite 203
P.O. Box 8047
Rapid City, South Dakota 57701
Phone: (605) 721-1158

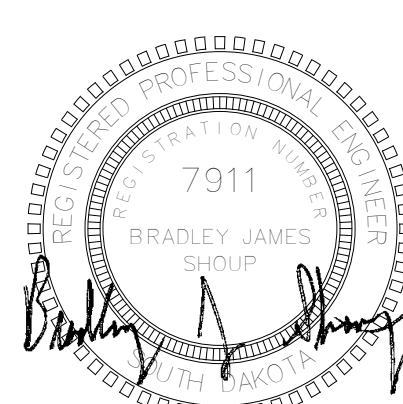

Associated
Consulting
Engineering,
Incorporated

340 S. Phillips Ave.
Sioux Falls, SD 57104
(605) 335-3720
Fax: 335-6220
E-mail: acei@gsnet.net

ACEI PROJ. #120085

Project
HARRISBURG HS - 9TH GRADE ACADEMY
Sheet Contents
SECOND FLOOR PLAN - AREA C - LIGHTING

number	1002.2904.20		
date	11-19-21		
revision			
drawn	ADP	checked	BJS
NO.	DATE	DESCRIPTION	
1	12-10-21	ADD E2	

9.36-2C